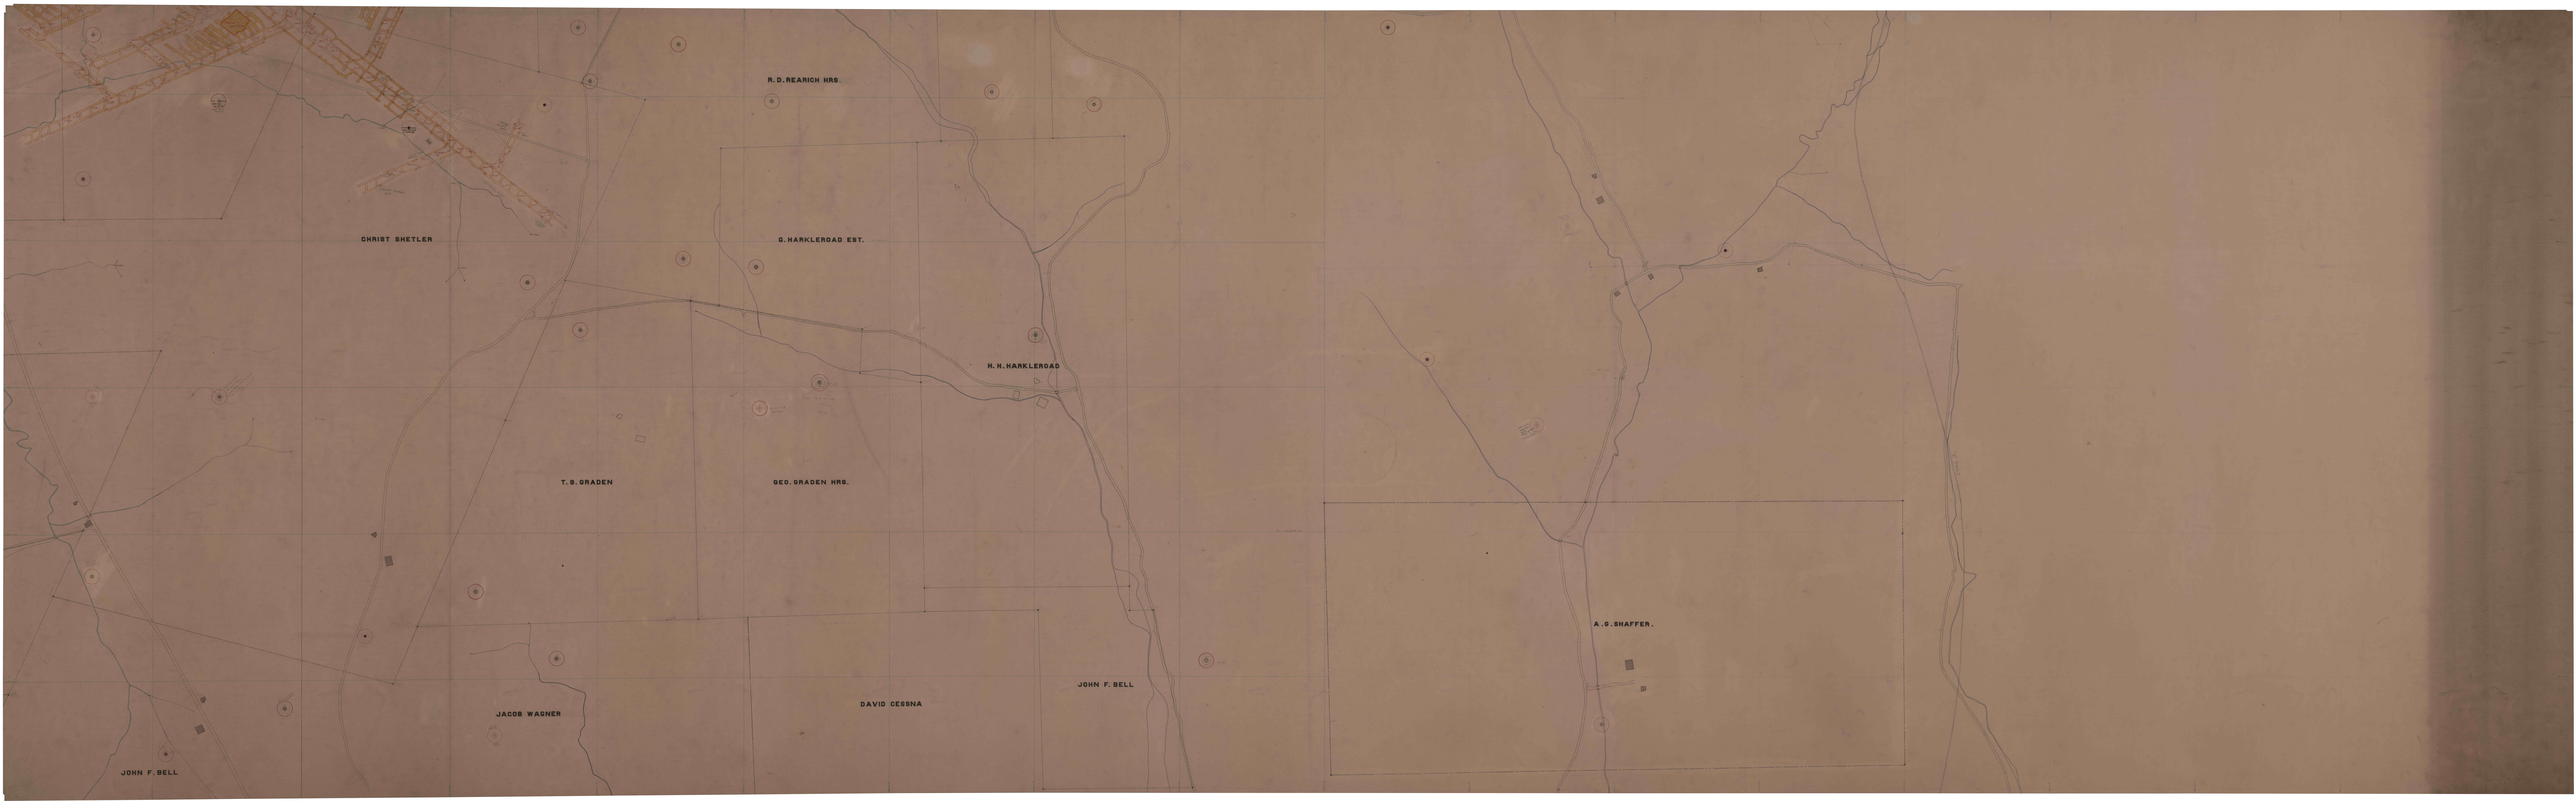
R. D. REARICH HRS.
CHRIST SHETLER
G. HARKLEROAD EST.
H. H. HARKLEROAD
T. B. GRADEN
GEO. GRADEN HRS.
A. G. SHAFFER.
JOHN F. BELL
DAVID CESSNA
JACOB WAGNER
JOHN F. BELL