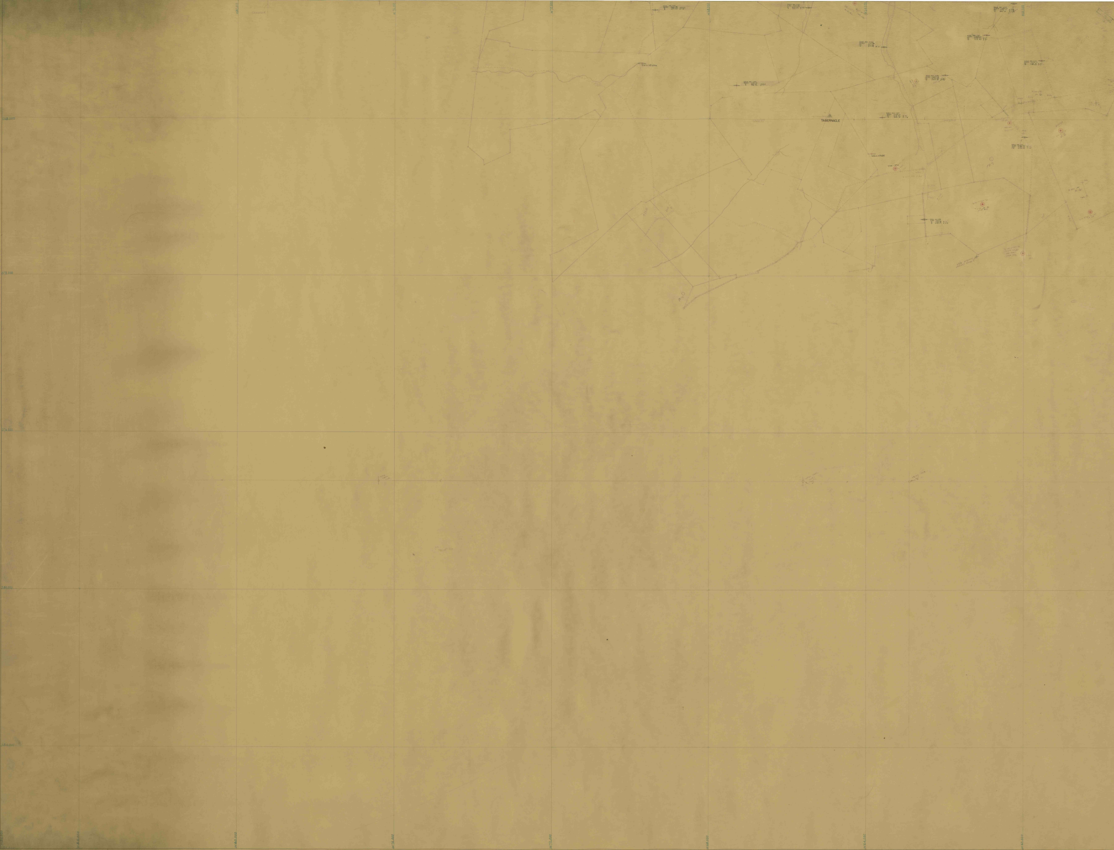
TABERNACLE

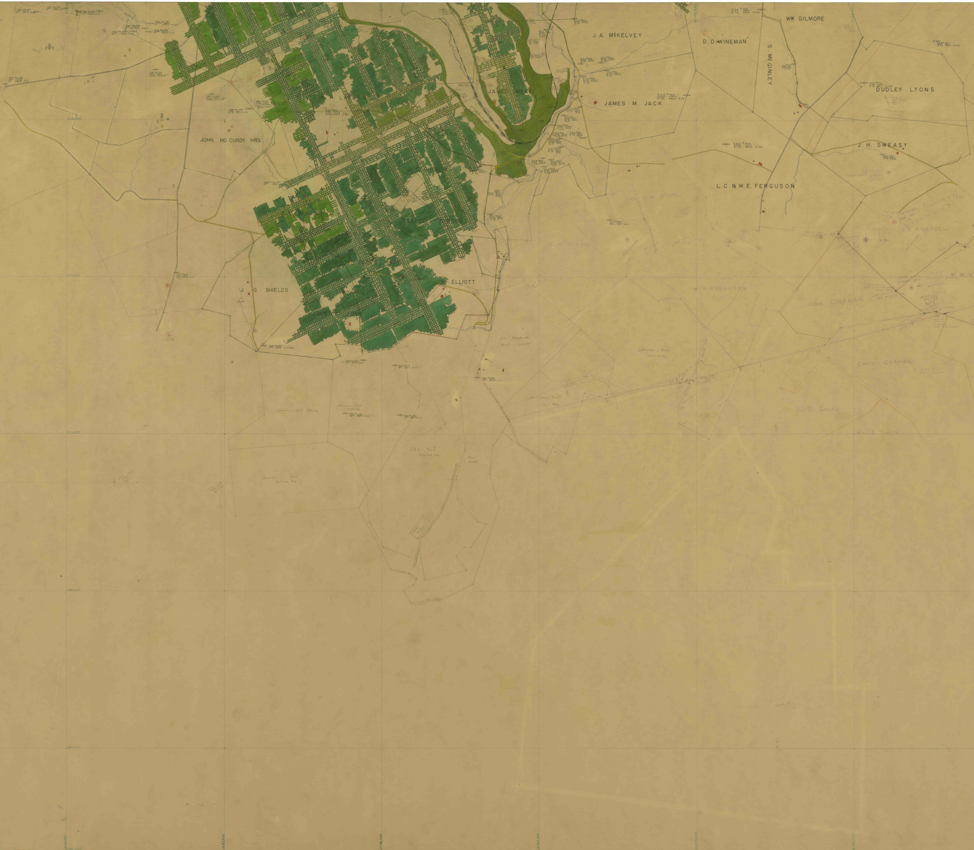
WM. GILMORE
J. A. McKELVEY
D. D. WINEMAN
S. McGINLEY
DUDLEY LYONS
S. LUCHSINGER
A. F. LAVEEN
JAMES McKEE
JAMES M. JACK
JOHN McCURDY HRS.
J. H. SWEASY
J. E. GIBSON
L. C. & W. E. FERGUSON
J. M. BARCLAY
ISABELL GIBSON
J. K. MIKESELL
BERNIE GREY
M. ELLIOTT
J. G. SHIELDS
W. D. FERGUSON
F. M. K
JOHN OVERDORF
LUCETTA TOMB
CHAS. CRAMER
J. T. SMITH
Wm. J. SMITH

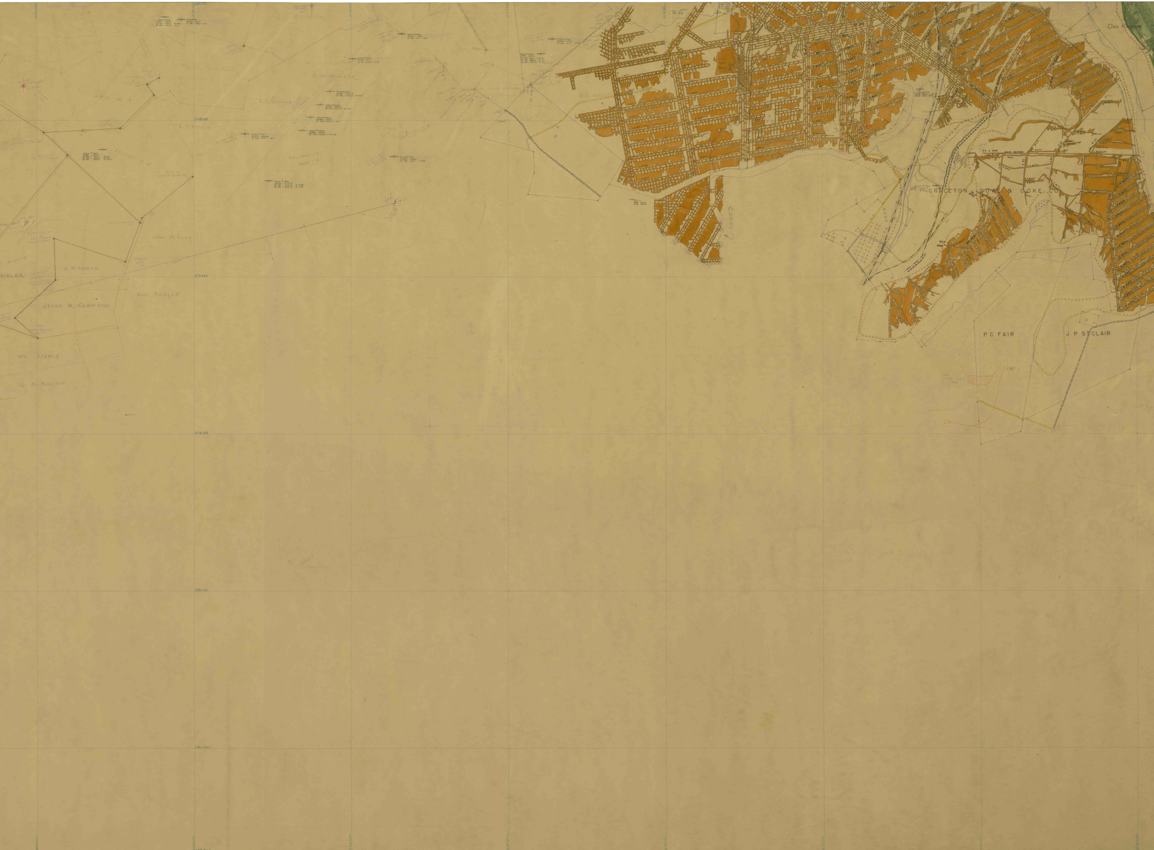
Dan Kunkle
Lemeul Kunkle
E. W. Kunkle
J. C. Broner
E. M. Kunkle
John M. Long
P. McClaren
EIBLER
Eliz. Badger
Jesse K. Clawson
Wm. Lively
C. A. Brown
GRACETON COAL & COKE CO.
No. 2 Mine
Main Heading
No. 5 Mine
P. C. FAIR
J. P. St. CLAIR
Coal
568,000
572,000
576,000
580,000
584,000

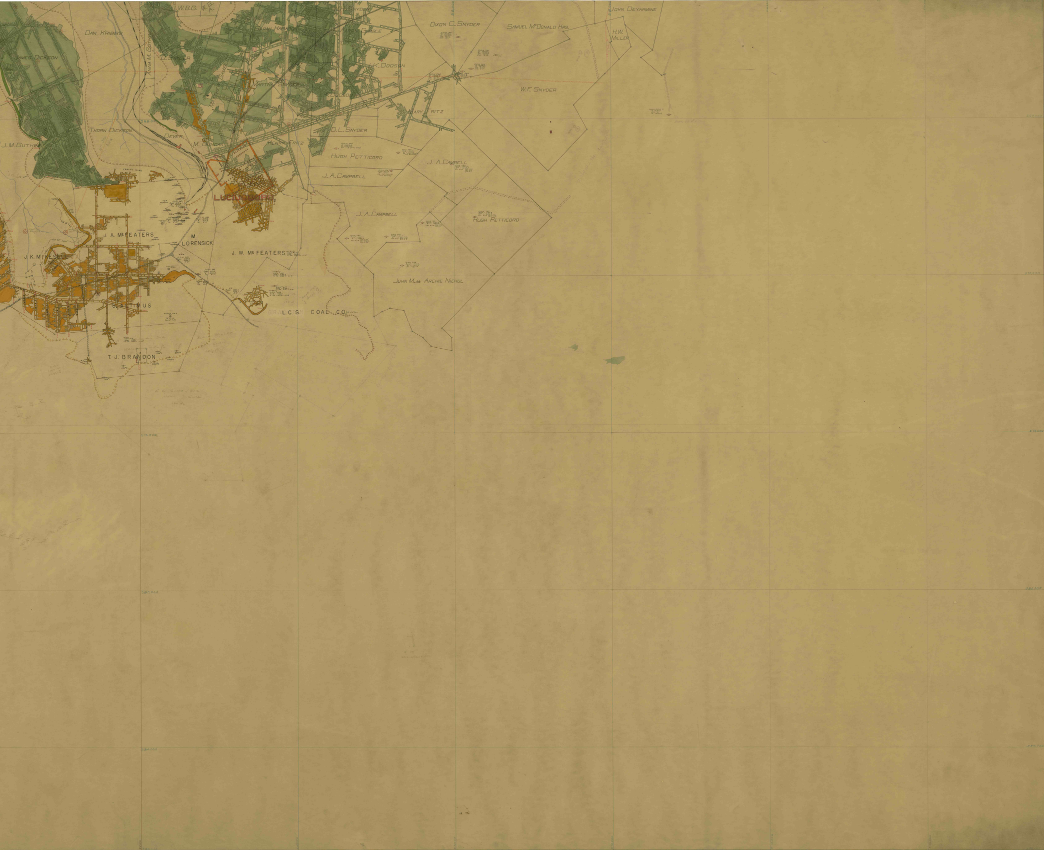
W.B.G.
W.G.A.
H. Snyder
Dan Kribbs
James Dickson
Anna M. Guthrie
D. Snyder
Sarah Harbaugh
Aaron Gamble
Matthew Gamble
Martha Snyder
K. Dodson
H.K. Dodson
Dixon C. Snyder
Samuel McDonald Hrs.
John Deyarmine
H.W. Miller
W.F. Snyder
Mary Fritz
Thorn Dickson
J.M. Guthrie
Dever
M. Duncan
Henry Fritz
D.L. Snyder
Hugh Petticord
J.A. Campbell
J. A. Cambell
Vanity Mine
Luciusboro
J.A. Campbell
Hugh Petticord
J. A. McFeaters
M. Lorensick
J.K. Mikesell
J. W. McFeaters
John M. & Archie Nichol
S. Altimus
L.C.S. Coal Co.
T. J. Brandon
568.00