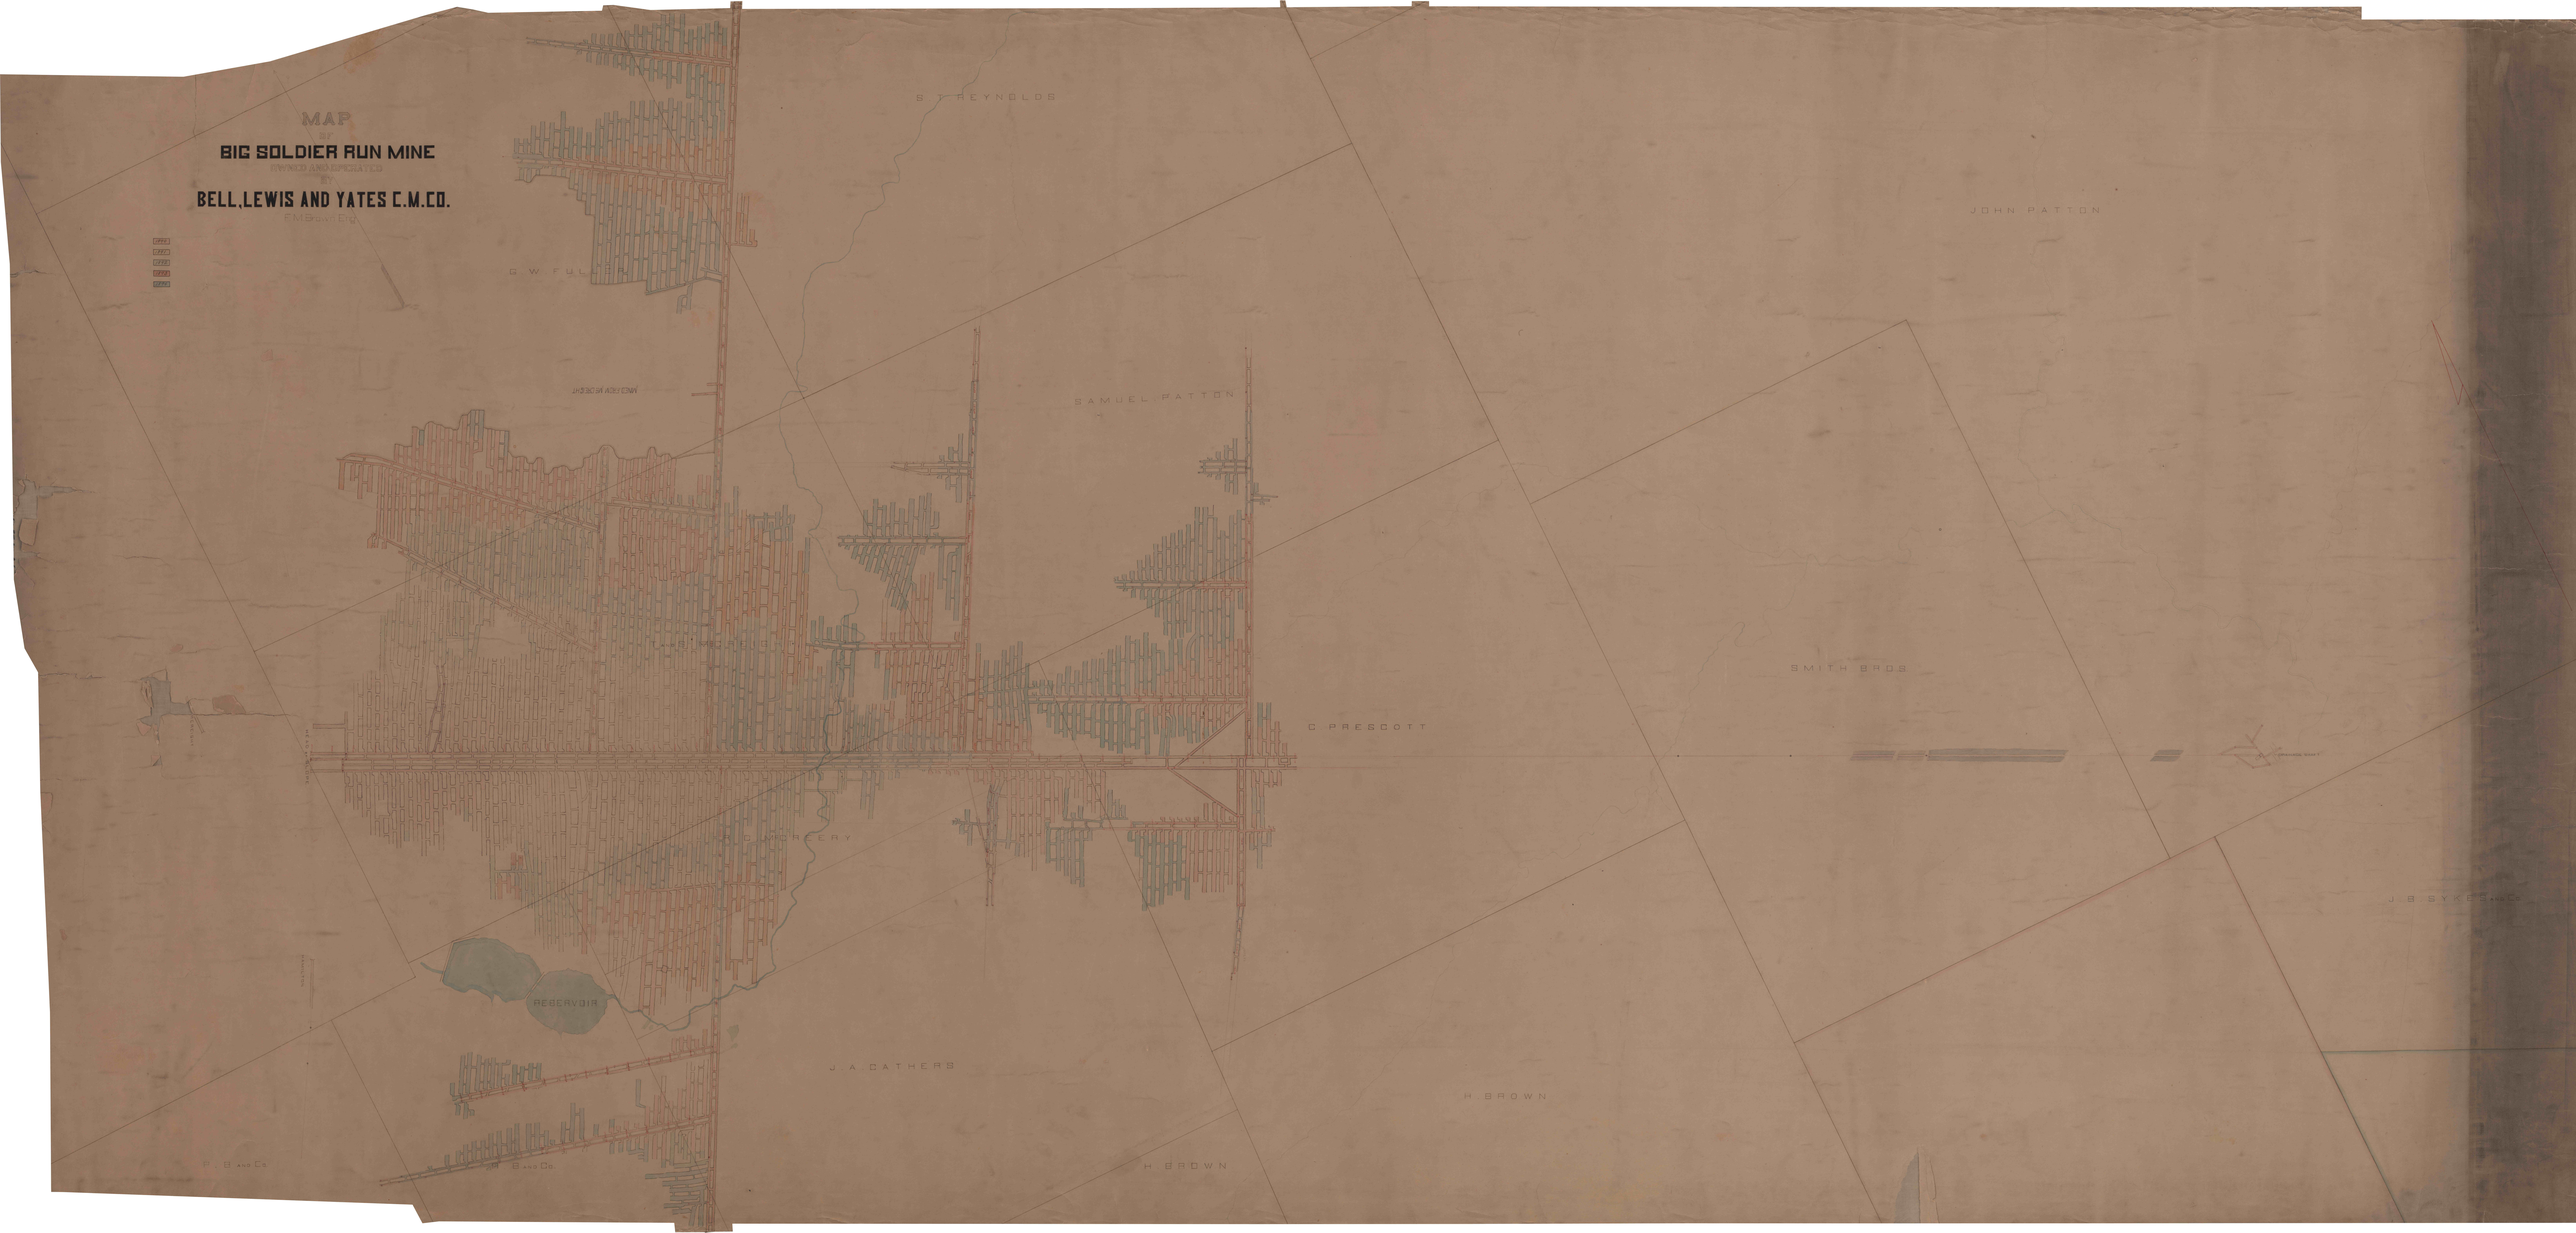
MAP
OF
BIG SOLDIER RUN MINE
OWNED AND OPERATED
BY
BELL, LEWIS AND YATES C.M.CO.
S. T. REYNOLDS
G. W. FULTON
SAMUEL PATTON
JOHN PATTON
SMITH BROS.
C. PRESCOTT
J. A. CATHERS
H. BROWN
H. BROWN
J. B. SYKES AND CO.
RESERVOIR