


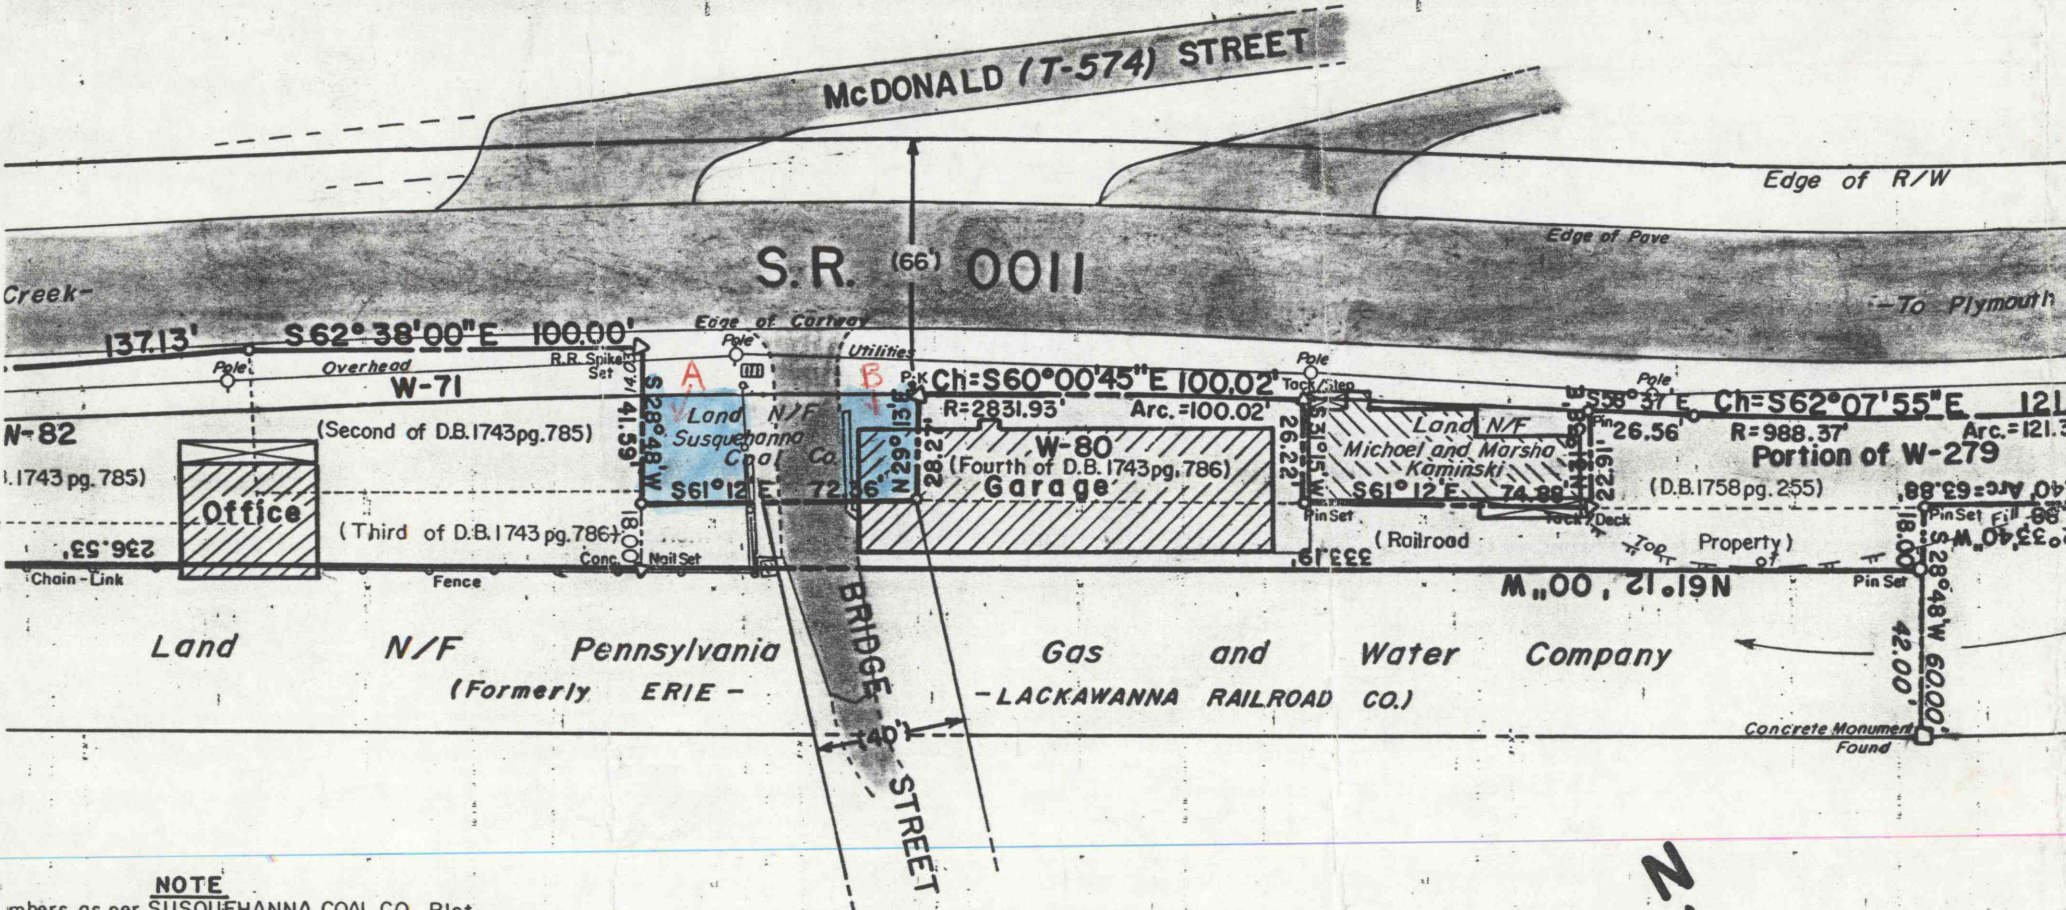

PLAT
Showing Lands of
PETER AND ROSE MARIE BRUNI
West Nanticoke

Plymouth Township — Luzerne County — Pennsylvania
Surveyed by RANDY L. HOWARD PLS.

