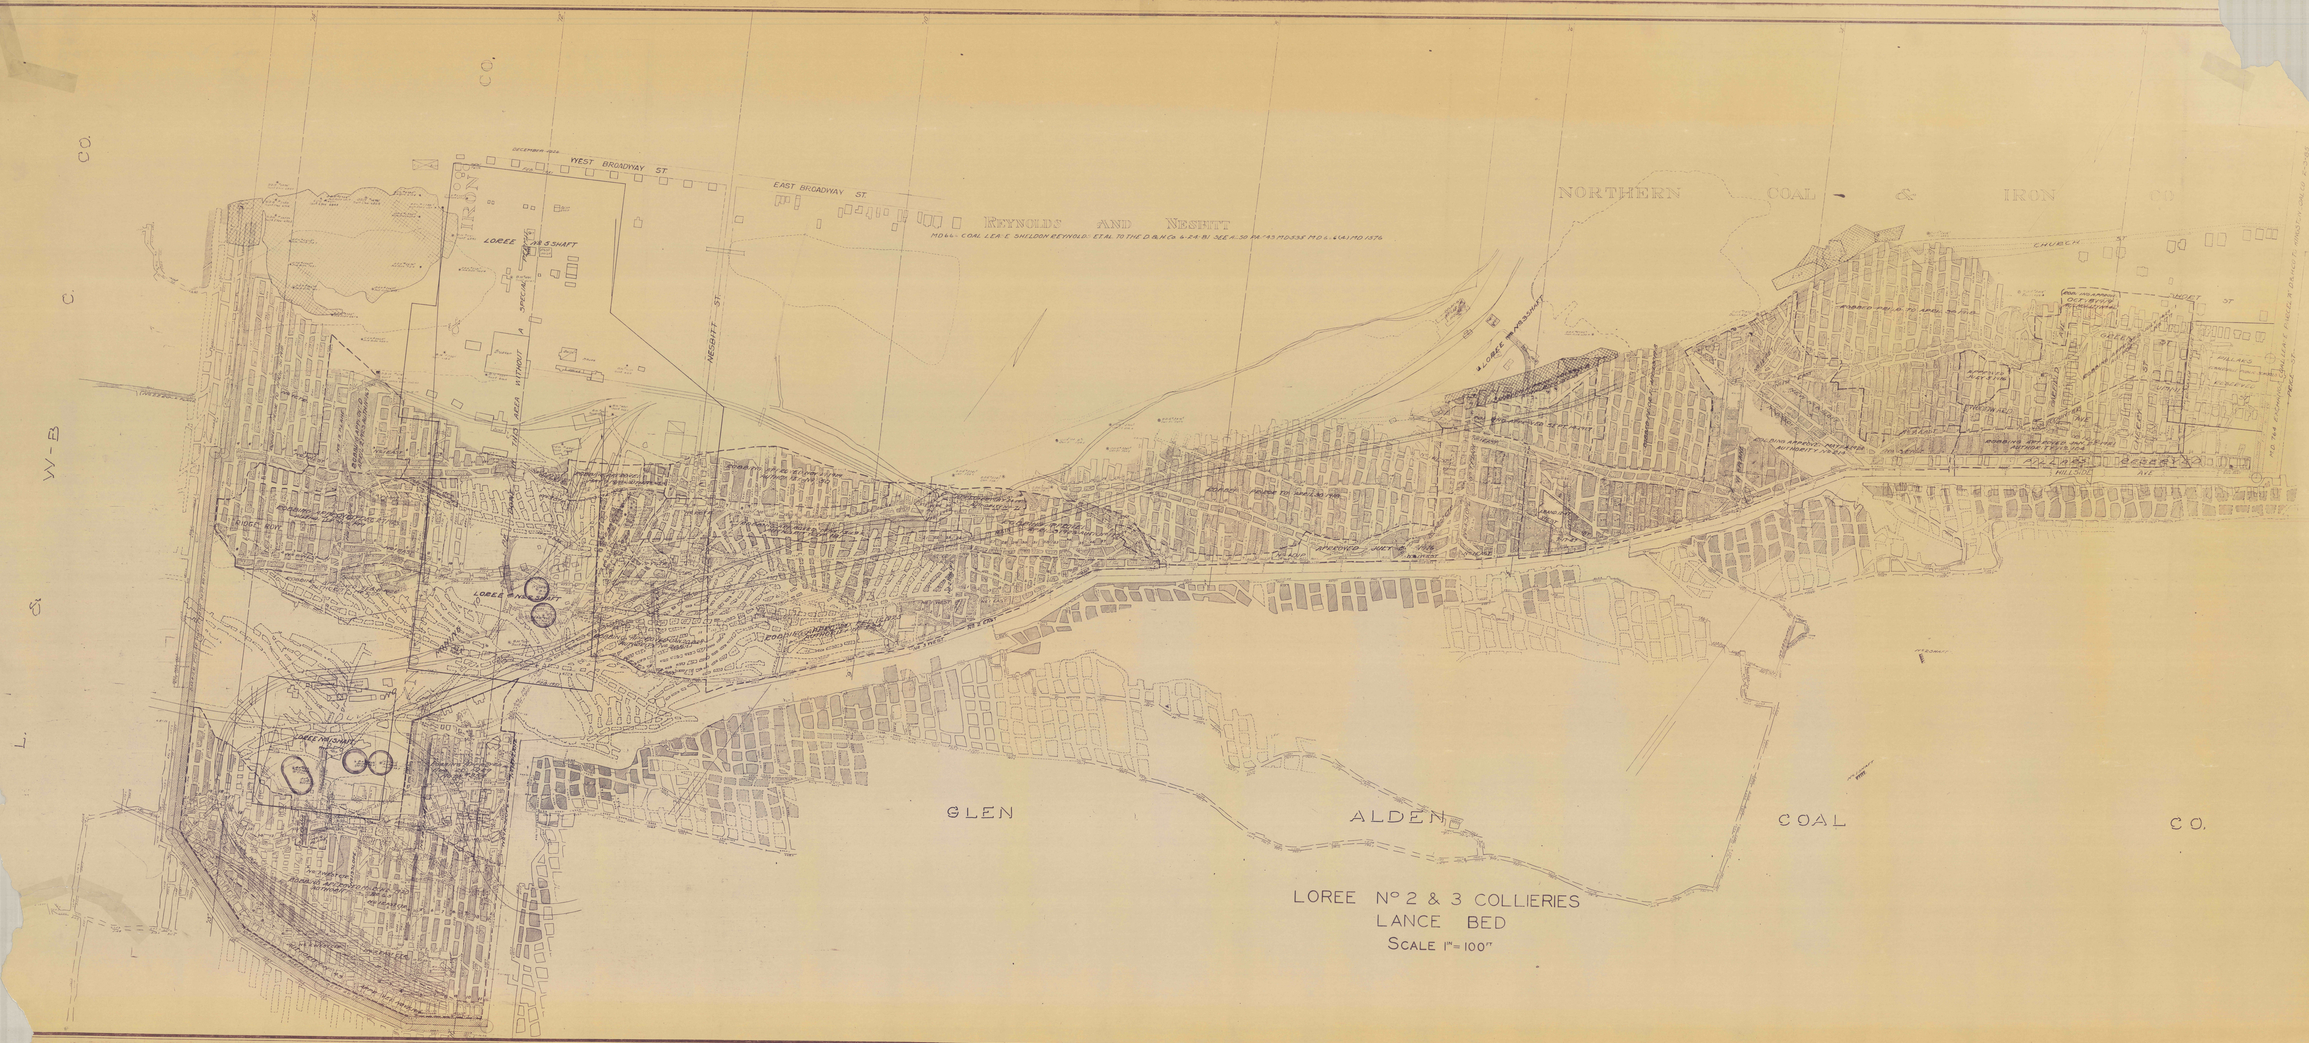


LOREE Nº 2 & 3 COLLIERIES
LANCE BED
SCALE 1" = 100'