


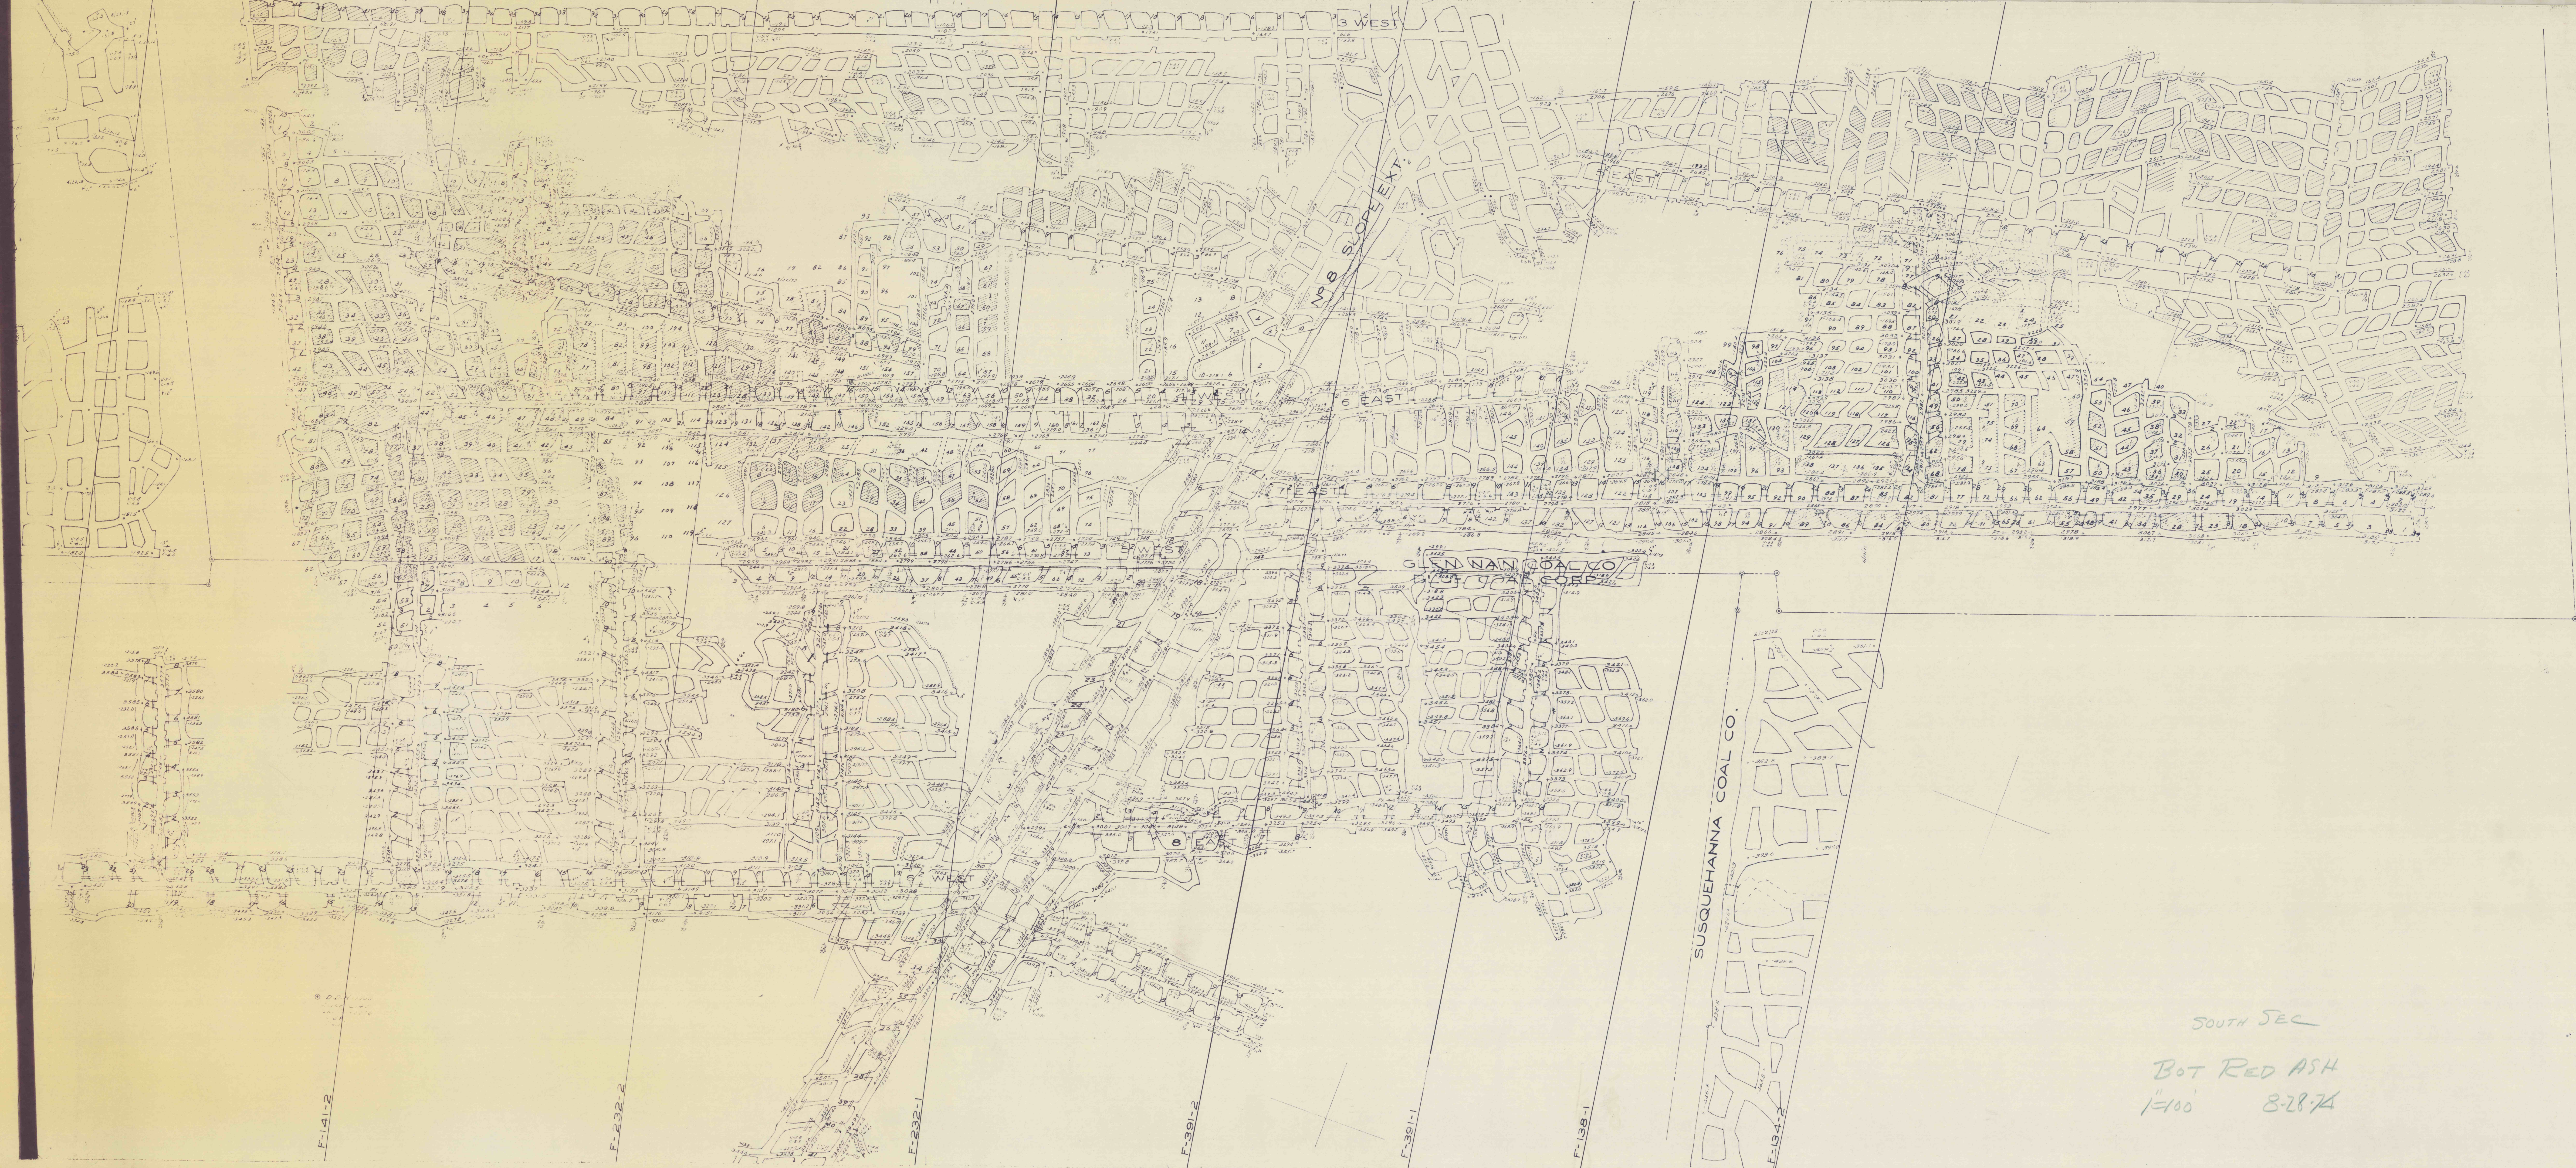

SOUTH SEC

BOT RED ASH

1"=100 8-28-74