


GLEN NAN INC.
BLUE COAL

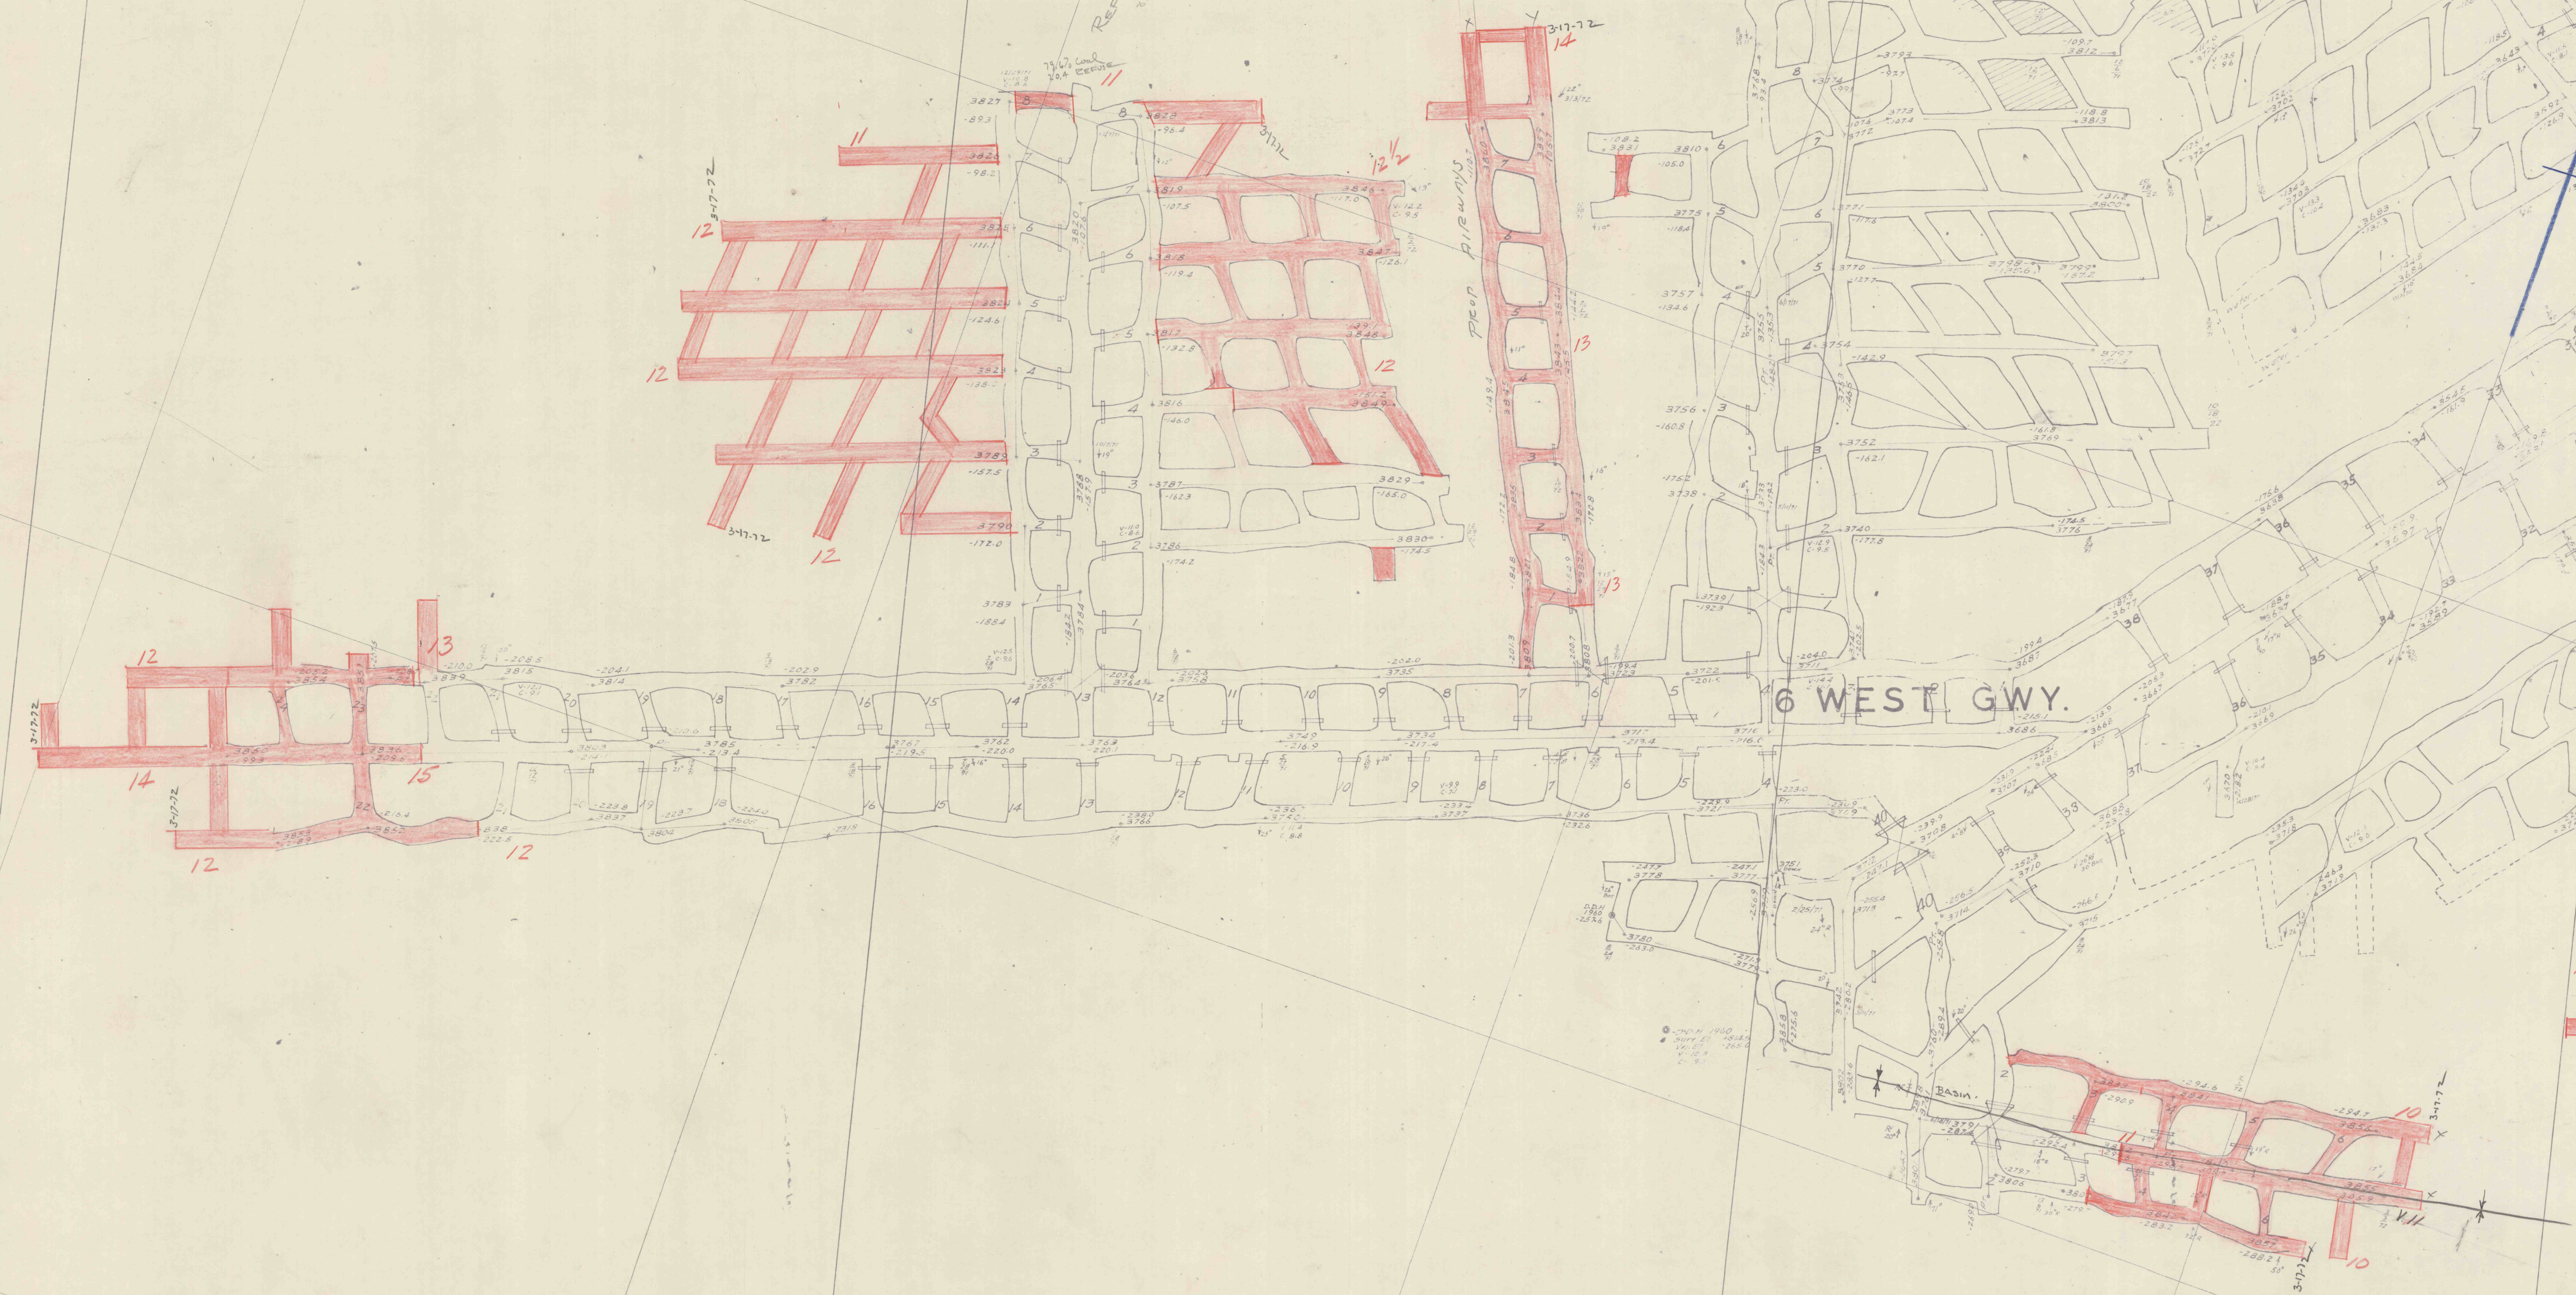

R055
1 1/2 50'
12/15/71 - 3/17/72