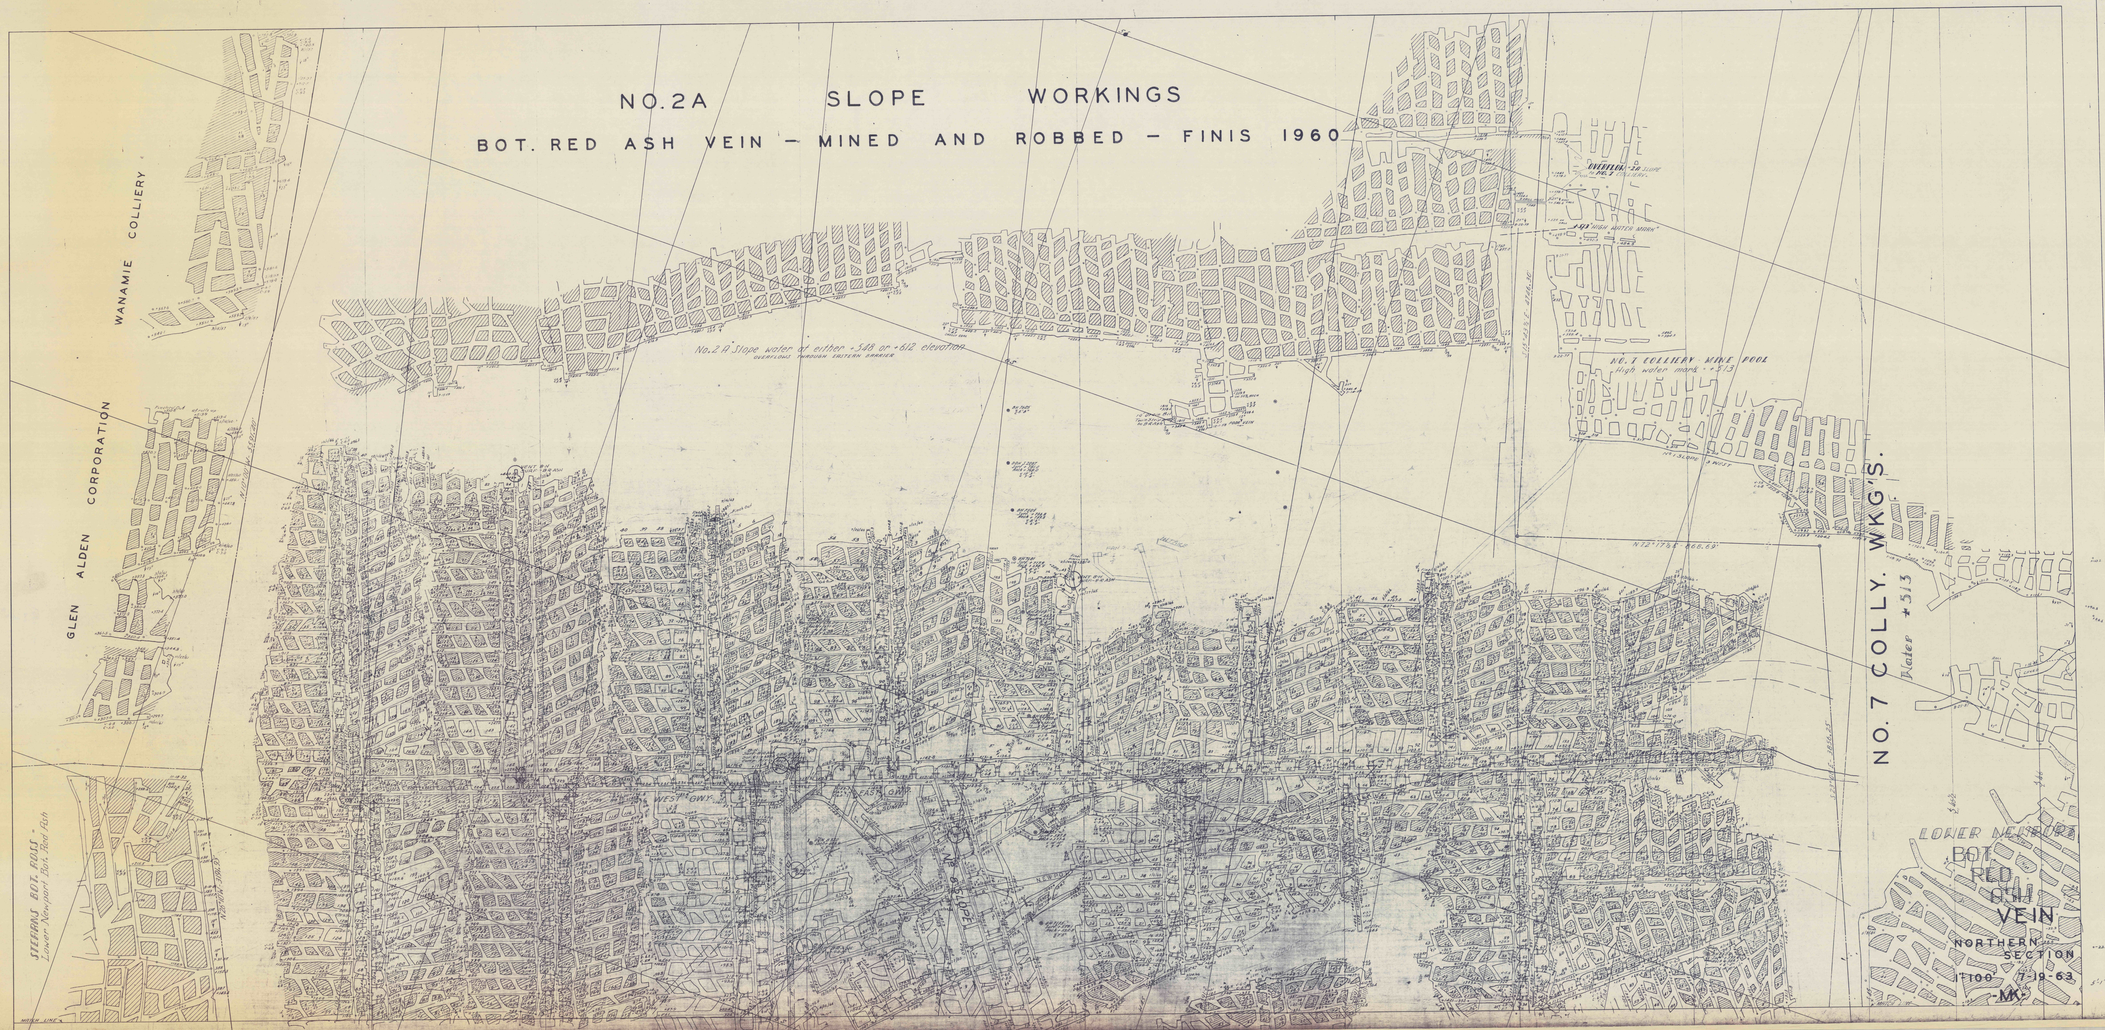

NO. 2A SLOPE WORKINGS
BOT. RED ASH VEIN – MINED AND ROBBED – FINIS 1960
WANAMIE COLLIERY
GLEN ALDEN CORPORATION
No. 2 A Slope water at either +548 or +612 elevations
NO. 7 COLLY. WKG'S.
LOWER NEWPORT
BOT. RED ASH VEIN
NORTHERN SECTION
1"=100' 7-19-63
MK
LOWER NEWPORT - BOT. RED ASH VEIN
NORTHERN SECT.