
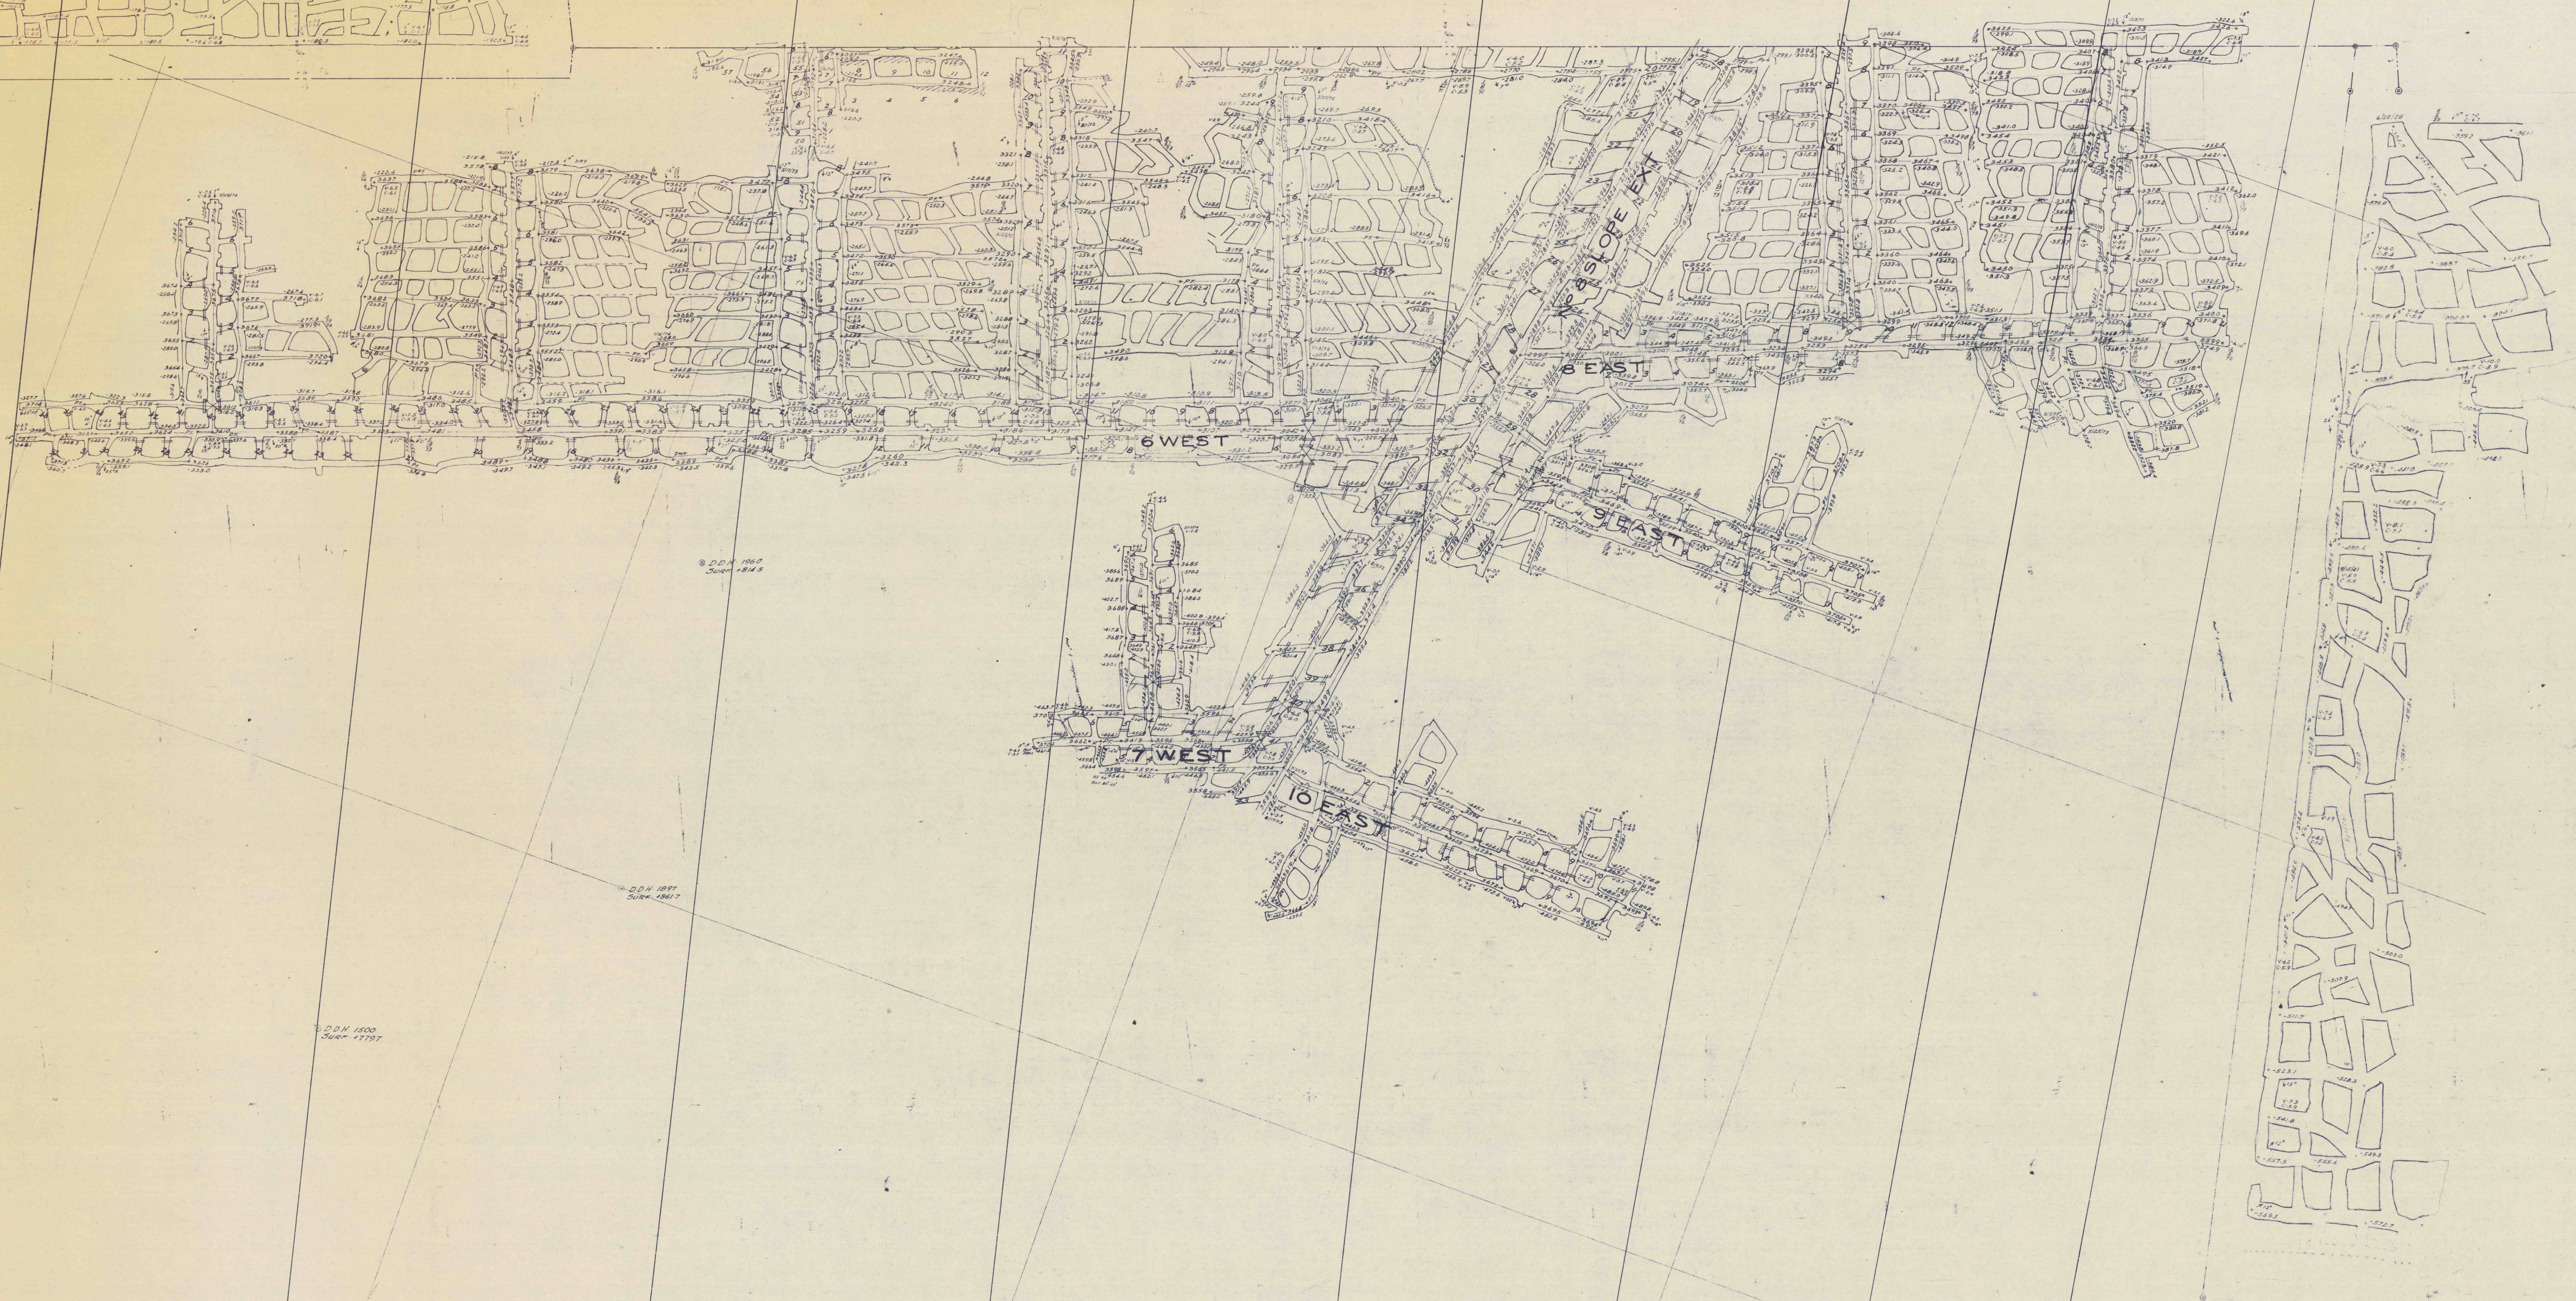


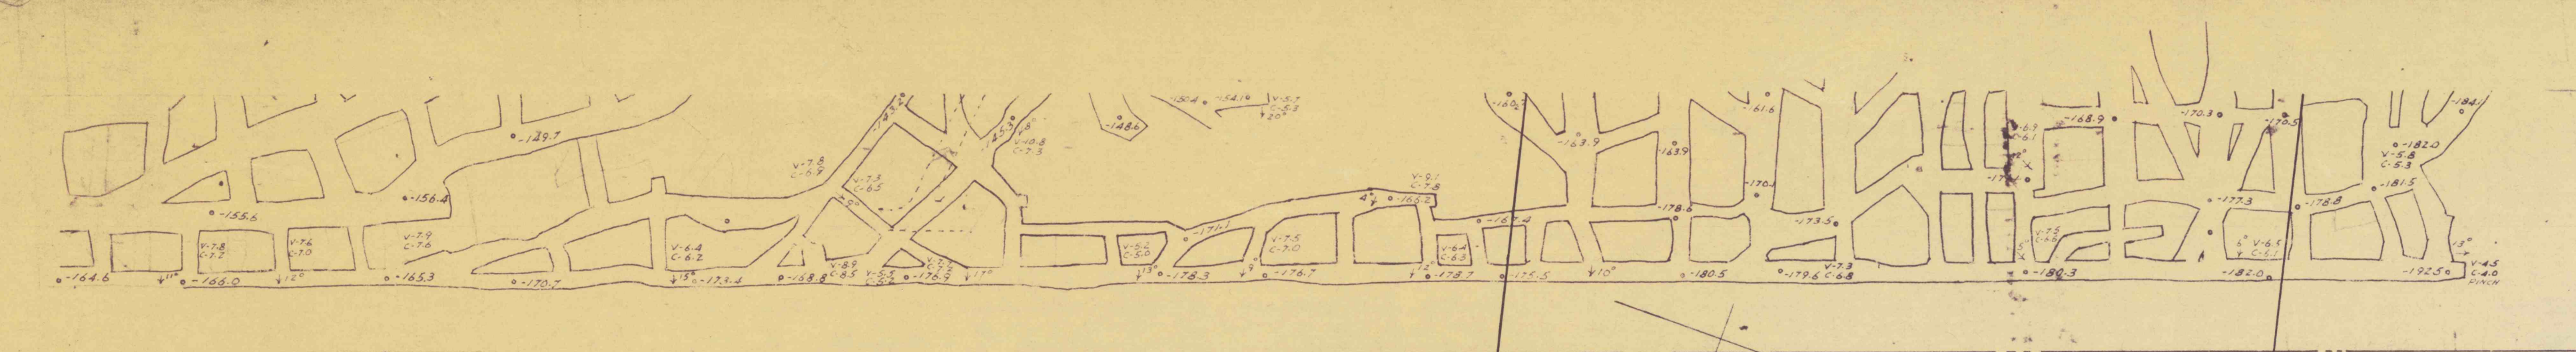

SOUTH SEC

RED ASH

1"=100'

P