


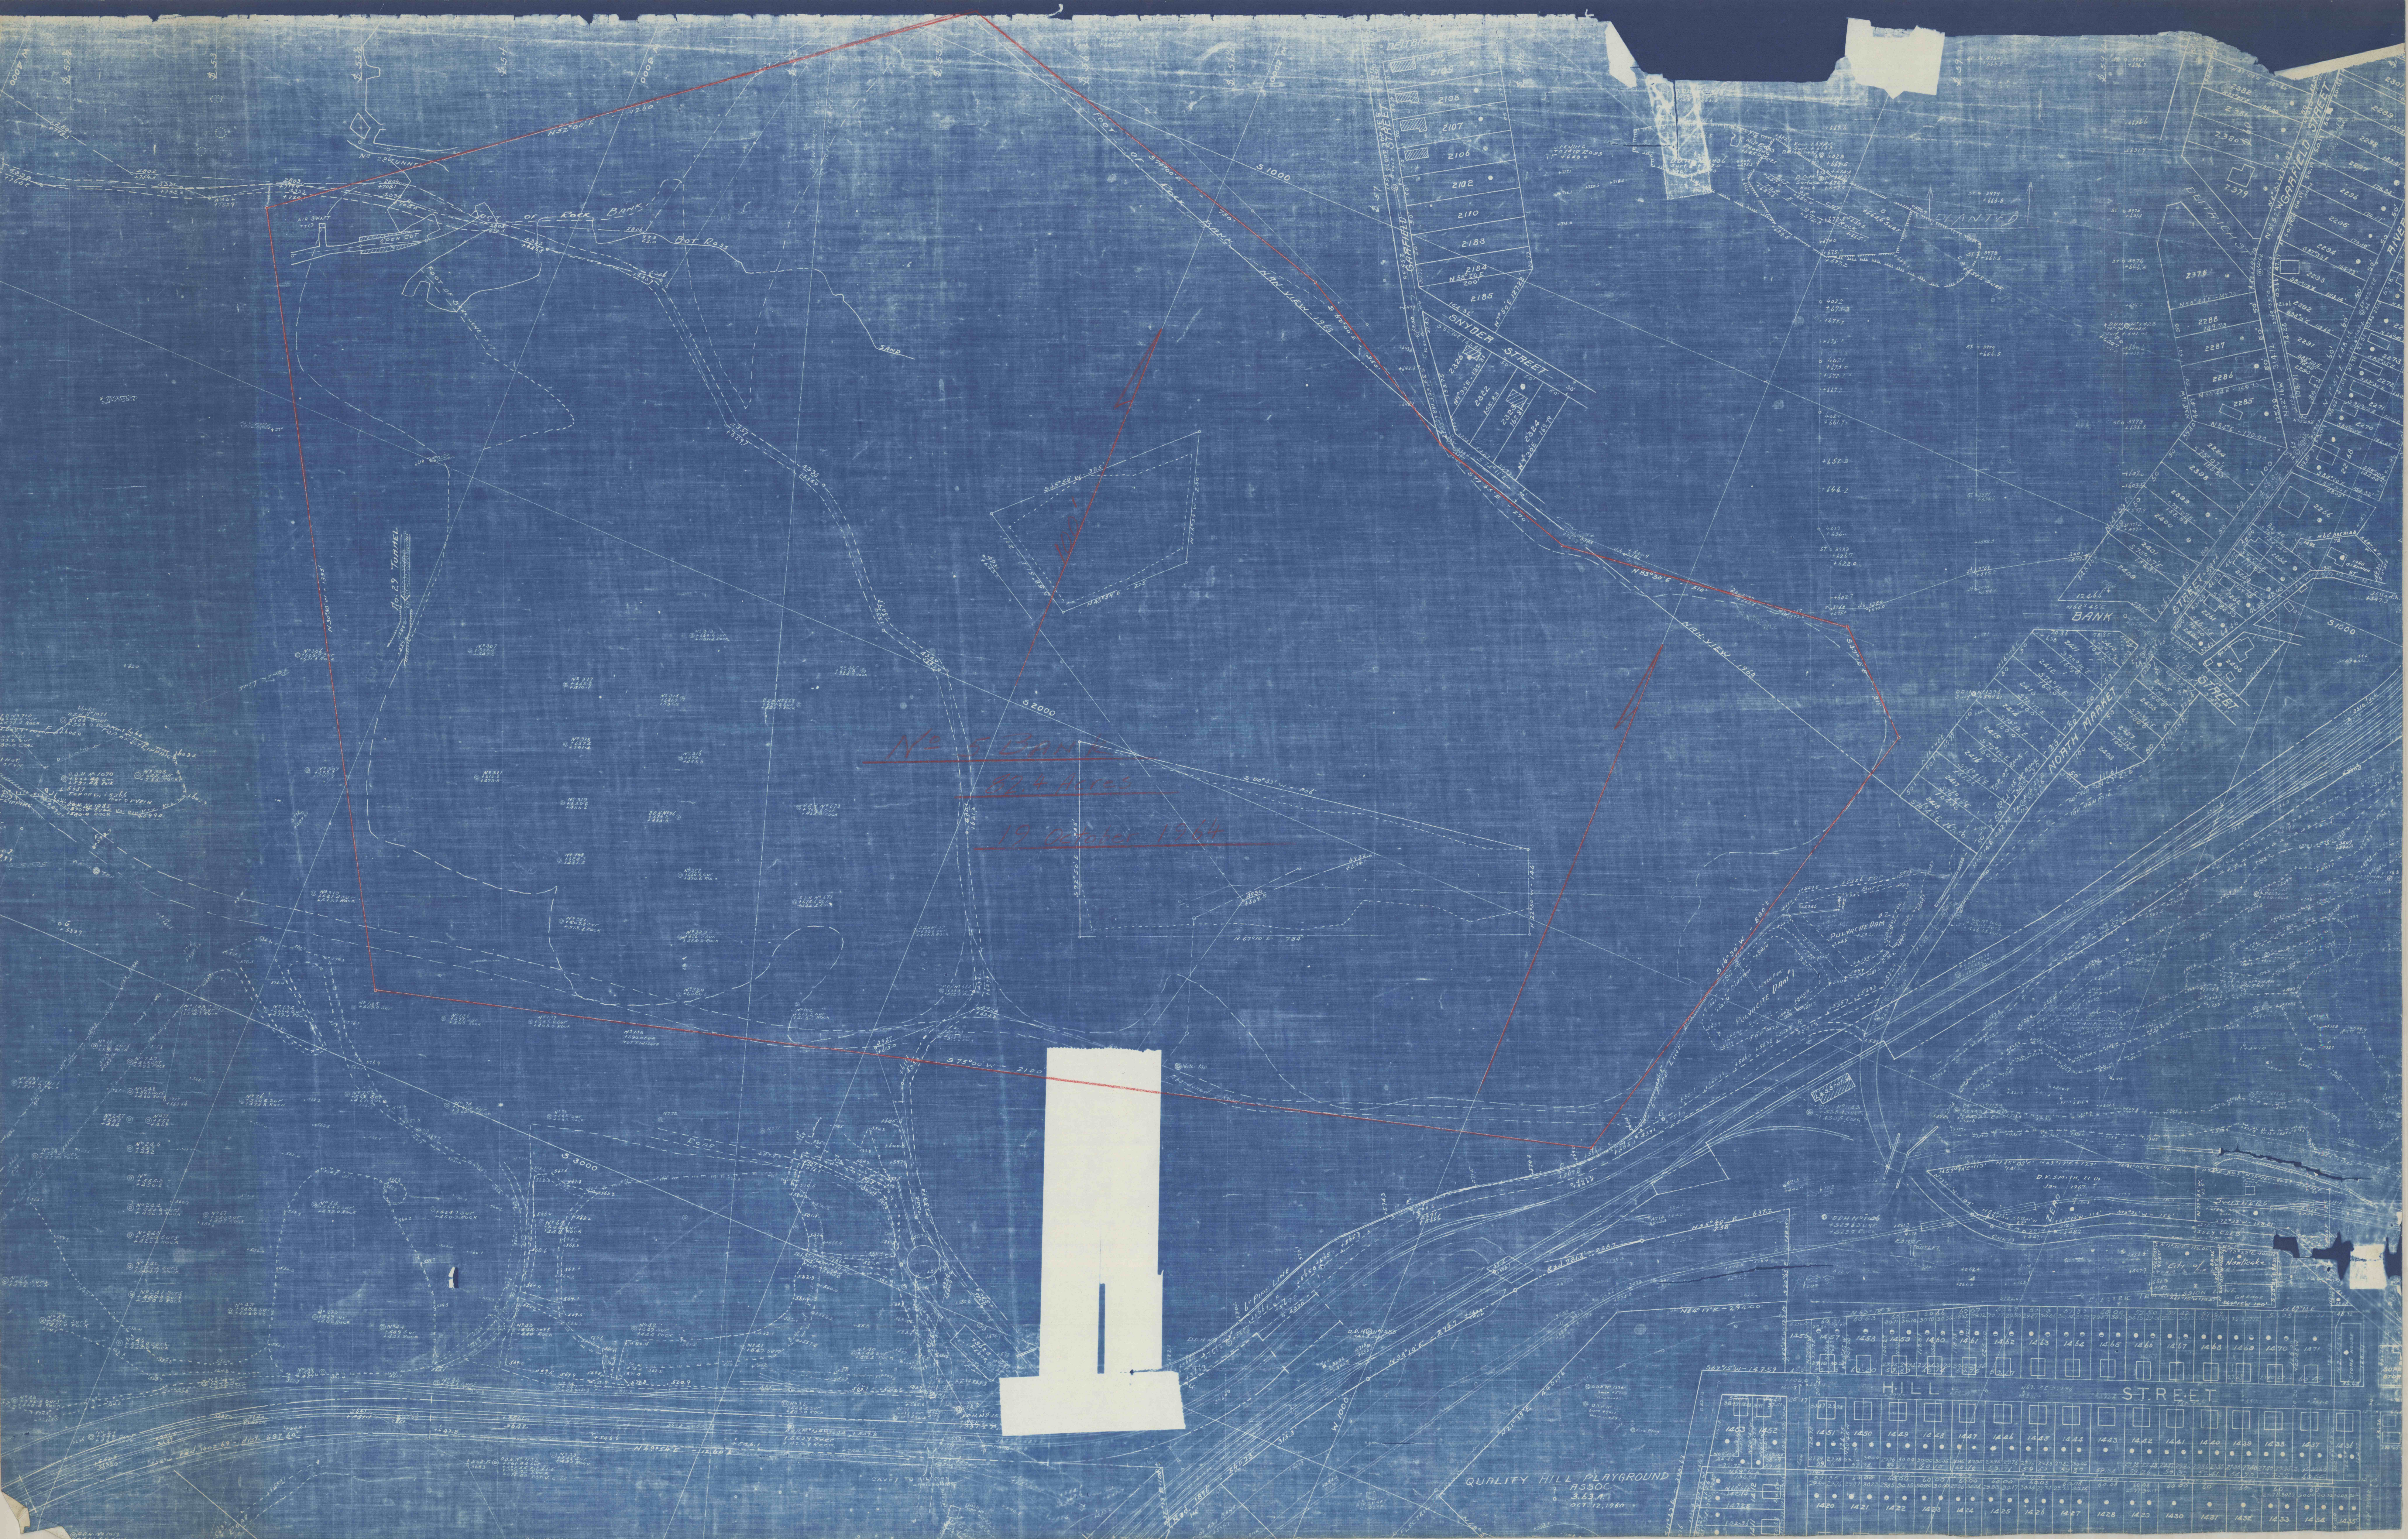

No 5 BANK

87.4 Acres

19 October 1964

HILL STREET

QUALITY HILL PLAYGROUND
3.43 A.
OCT. 12, 1960