


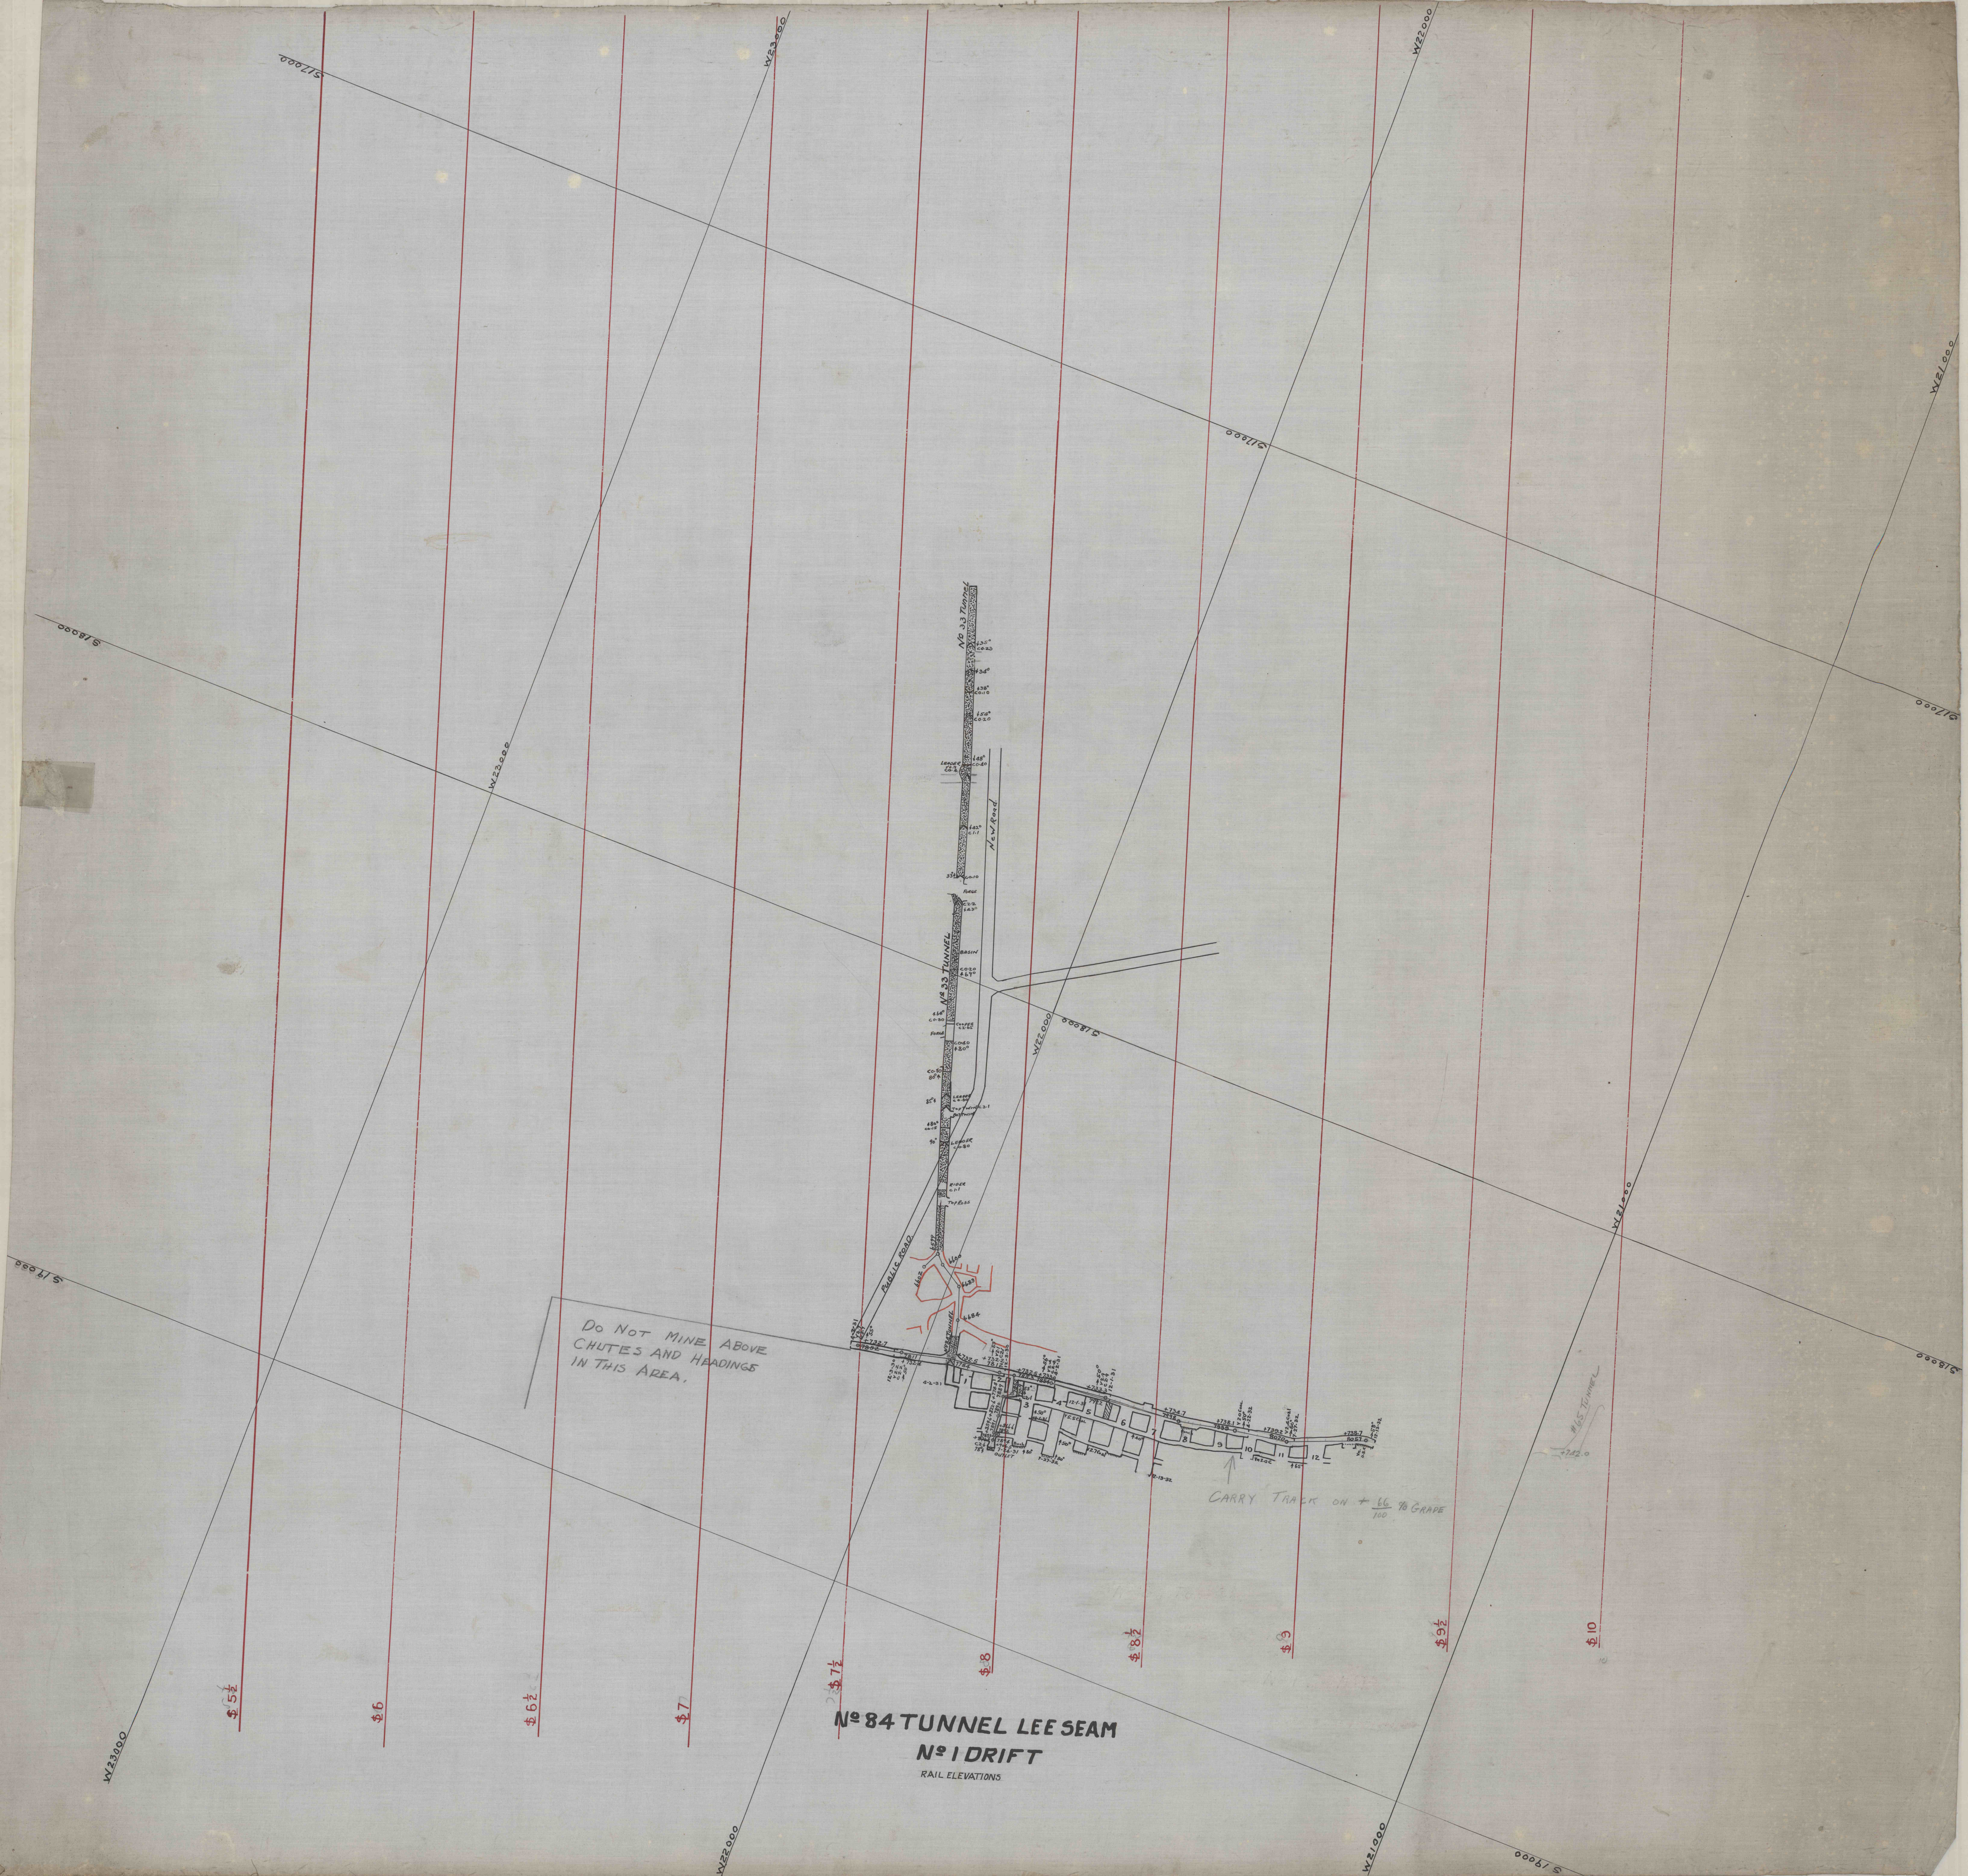

DO NOT MINE ABOVE
CHUTES AND HEADINGS
IN THIS AREA.

Nº 84 TUNNEL LEE SEAM
Nº 1 DRIFT
RAIL ELEVATIONS