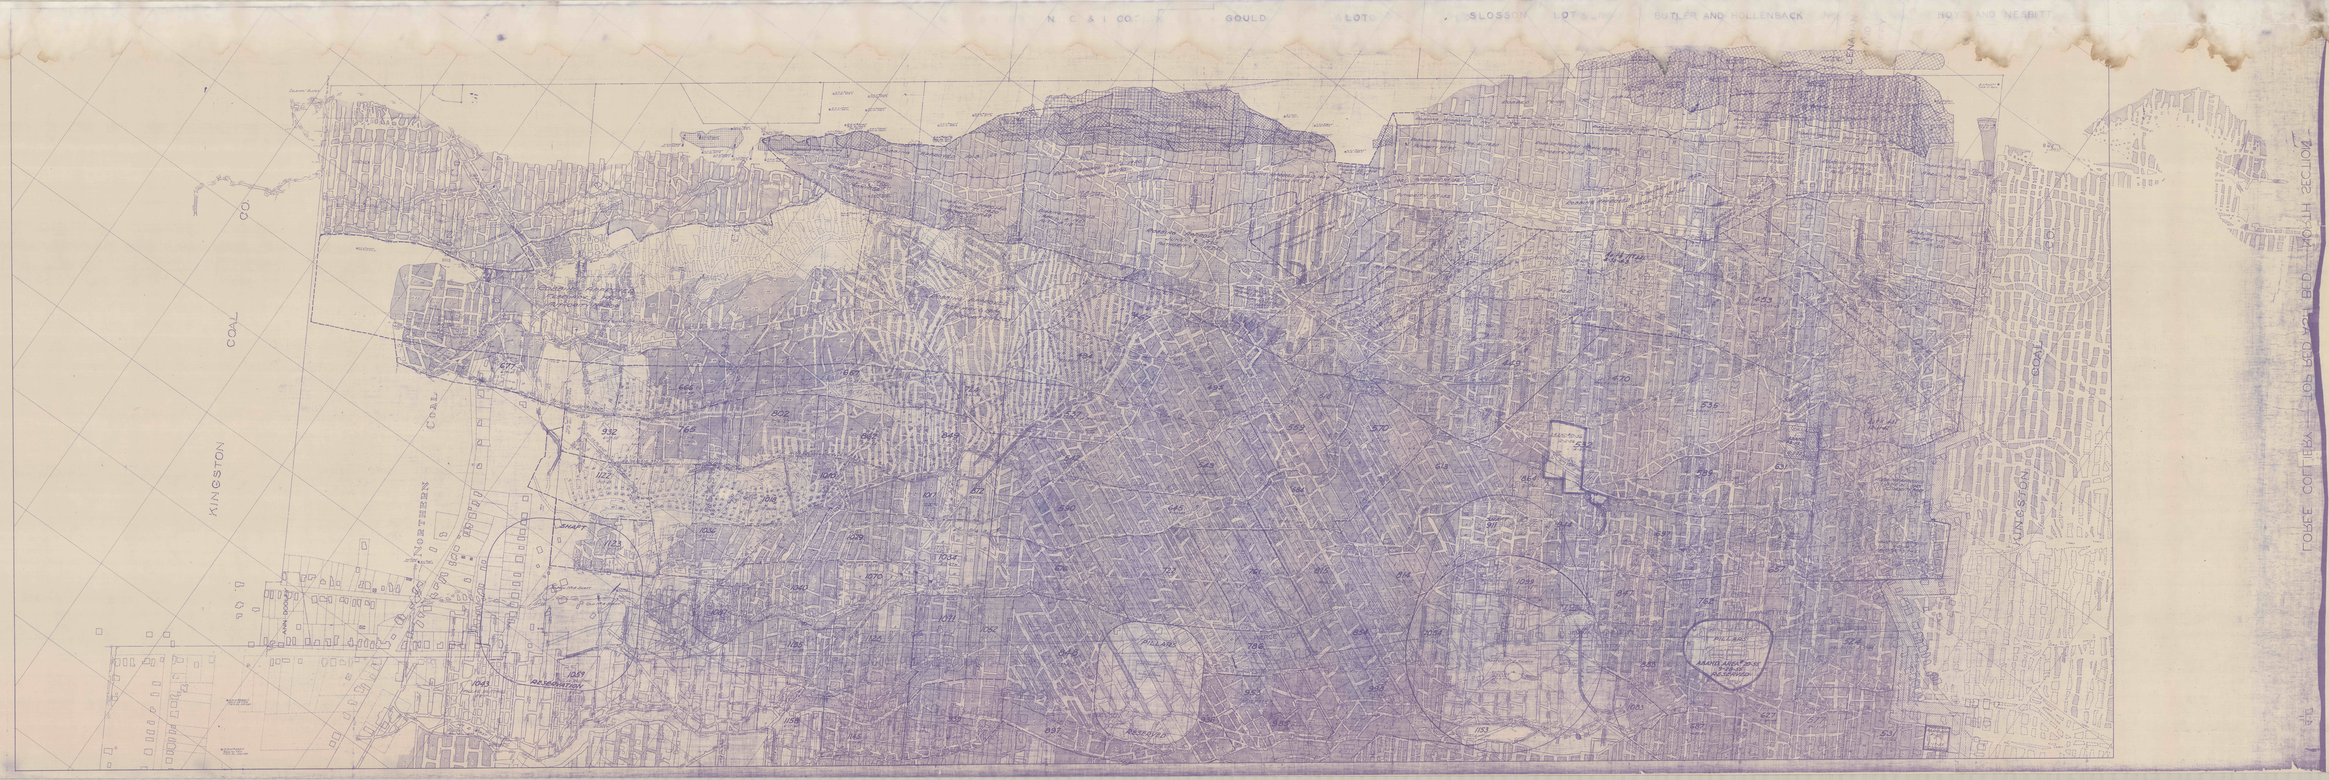

N C & I CO
GOULD
LOT
SLOSSON
LOT
BUTLER AND HOLLENBACK
HOYLAND NESBIT
KINGSTON COAL CO
KINGSTON COAL
NORTHERN COAL
KINGSTON
KINGSTON COAL
RESERVOIR
RESERVOIR
ABANDONED
ABANDONED
FORGE COLLIERY — TOP RED ASH BED — NORTH SECTION