
LOREE COLLIERY —— CROSS SECTION 9-10

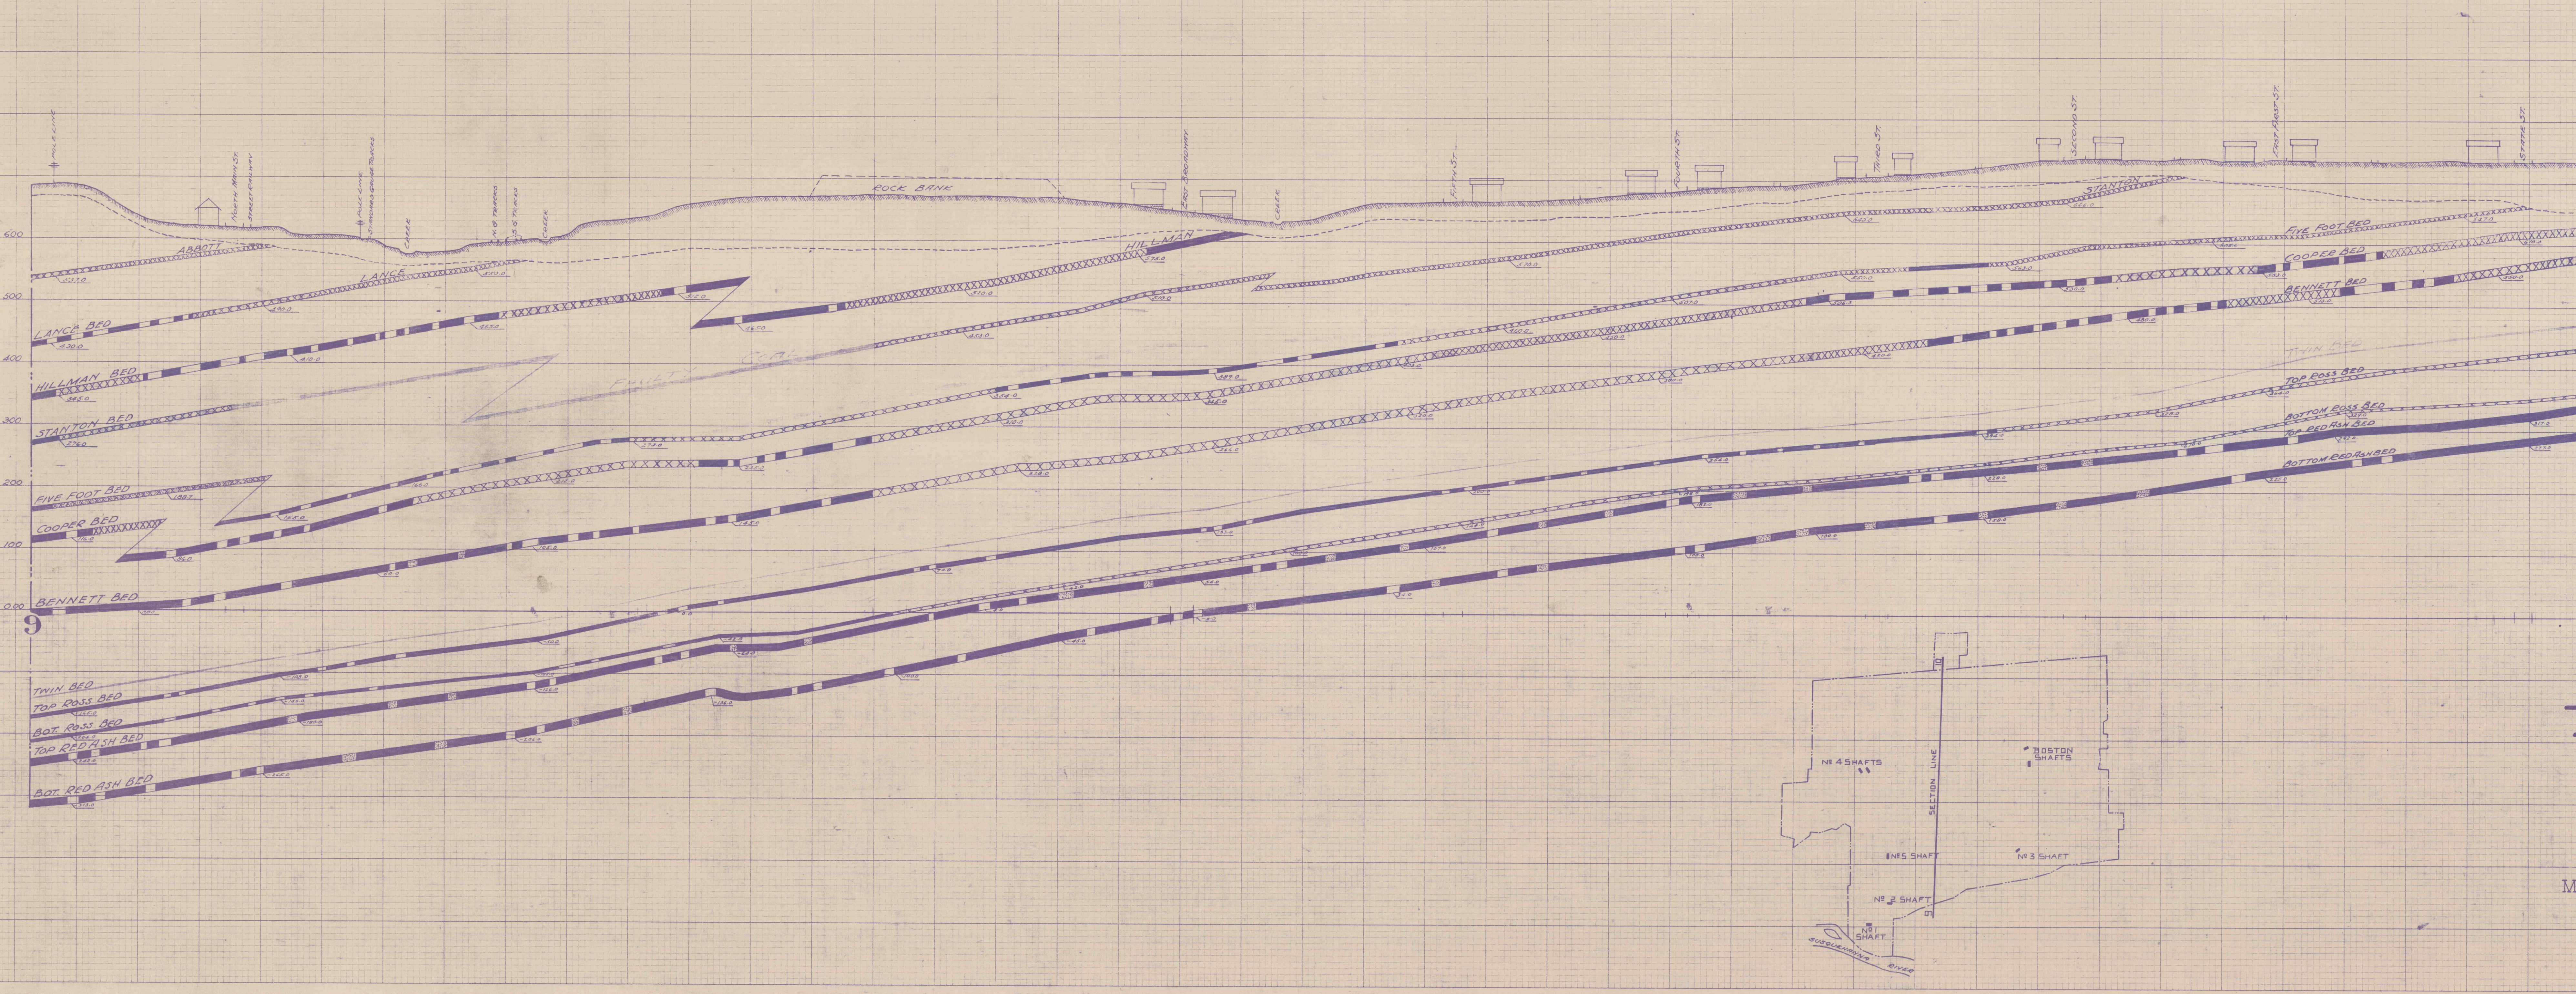

THE HUDSON COAL CO.
LOREE COLLIERY
CROSS SECTION
THRU COAL MEASURES

SCALE 1 INCH = 100 FT

MINING ENGINEER'S OFFICE —————— NOVEMBER 1928

POSTED	
9-25-45	K.M.
3-1-47	K.M.
2-24-50	K.M.
2-12-52	K.M.
6-22-54	K.M.
7-22-58	K.M.
5-24-70	J.G.A.

LOREE COLLIERY —— CROSS SECTION 9-10