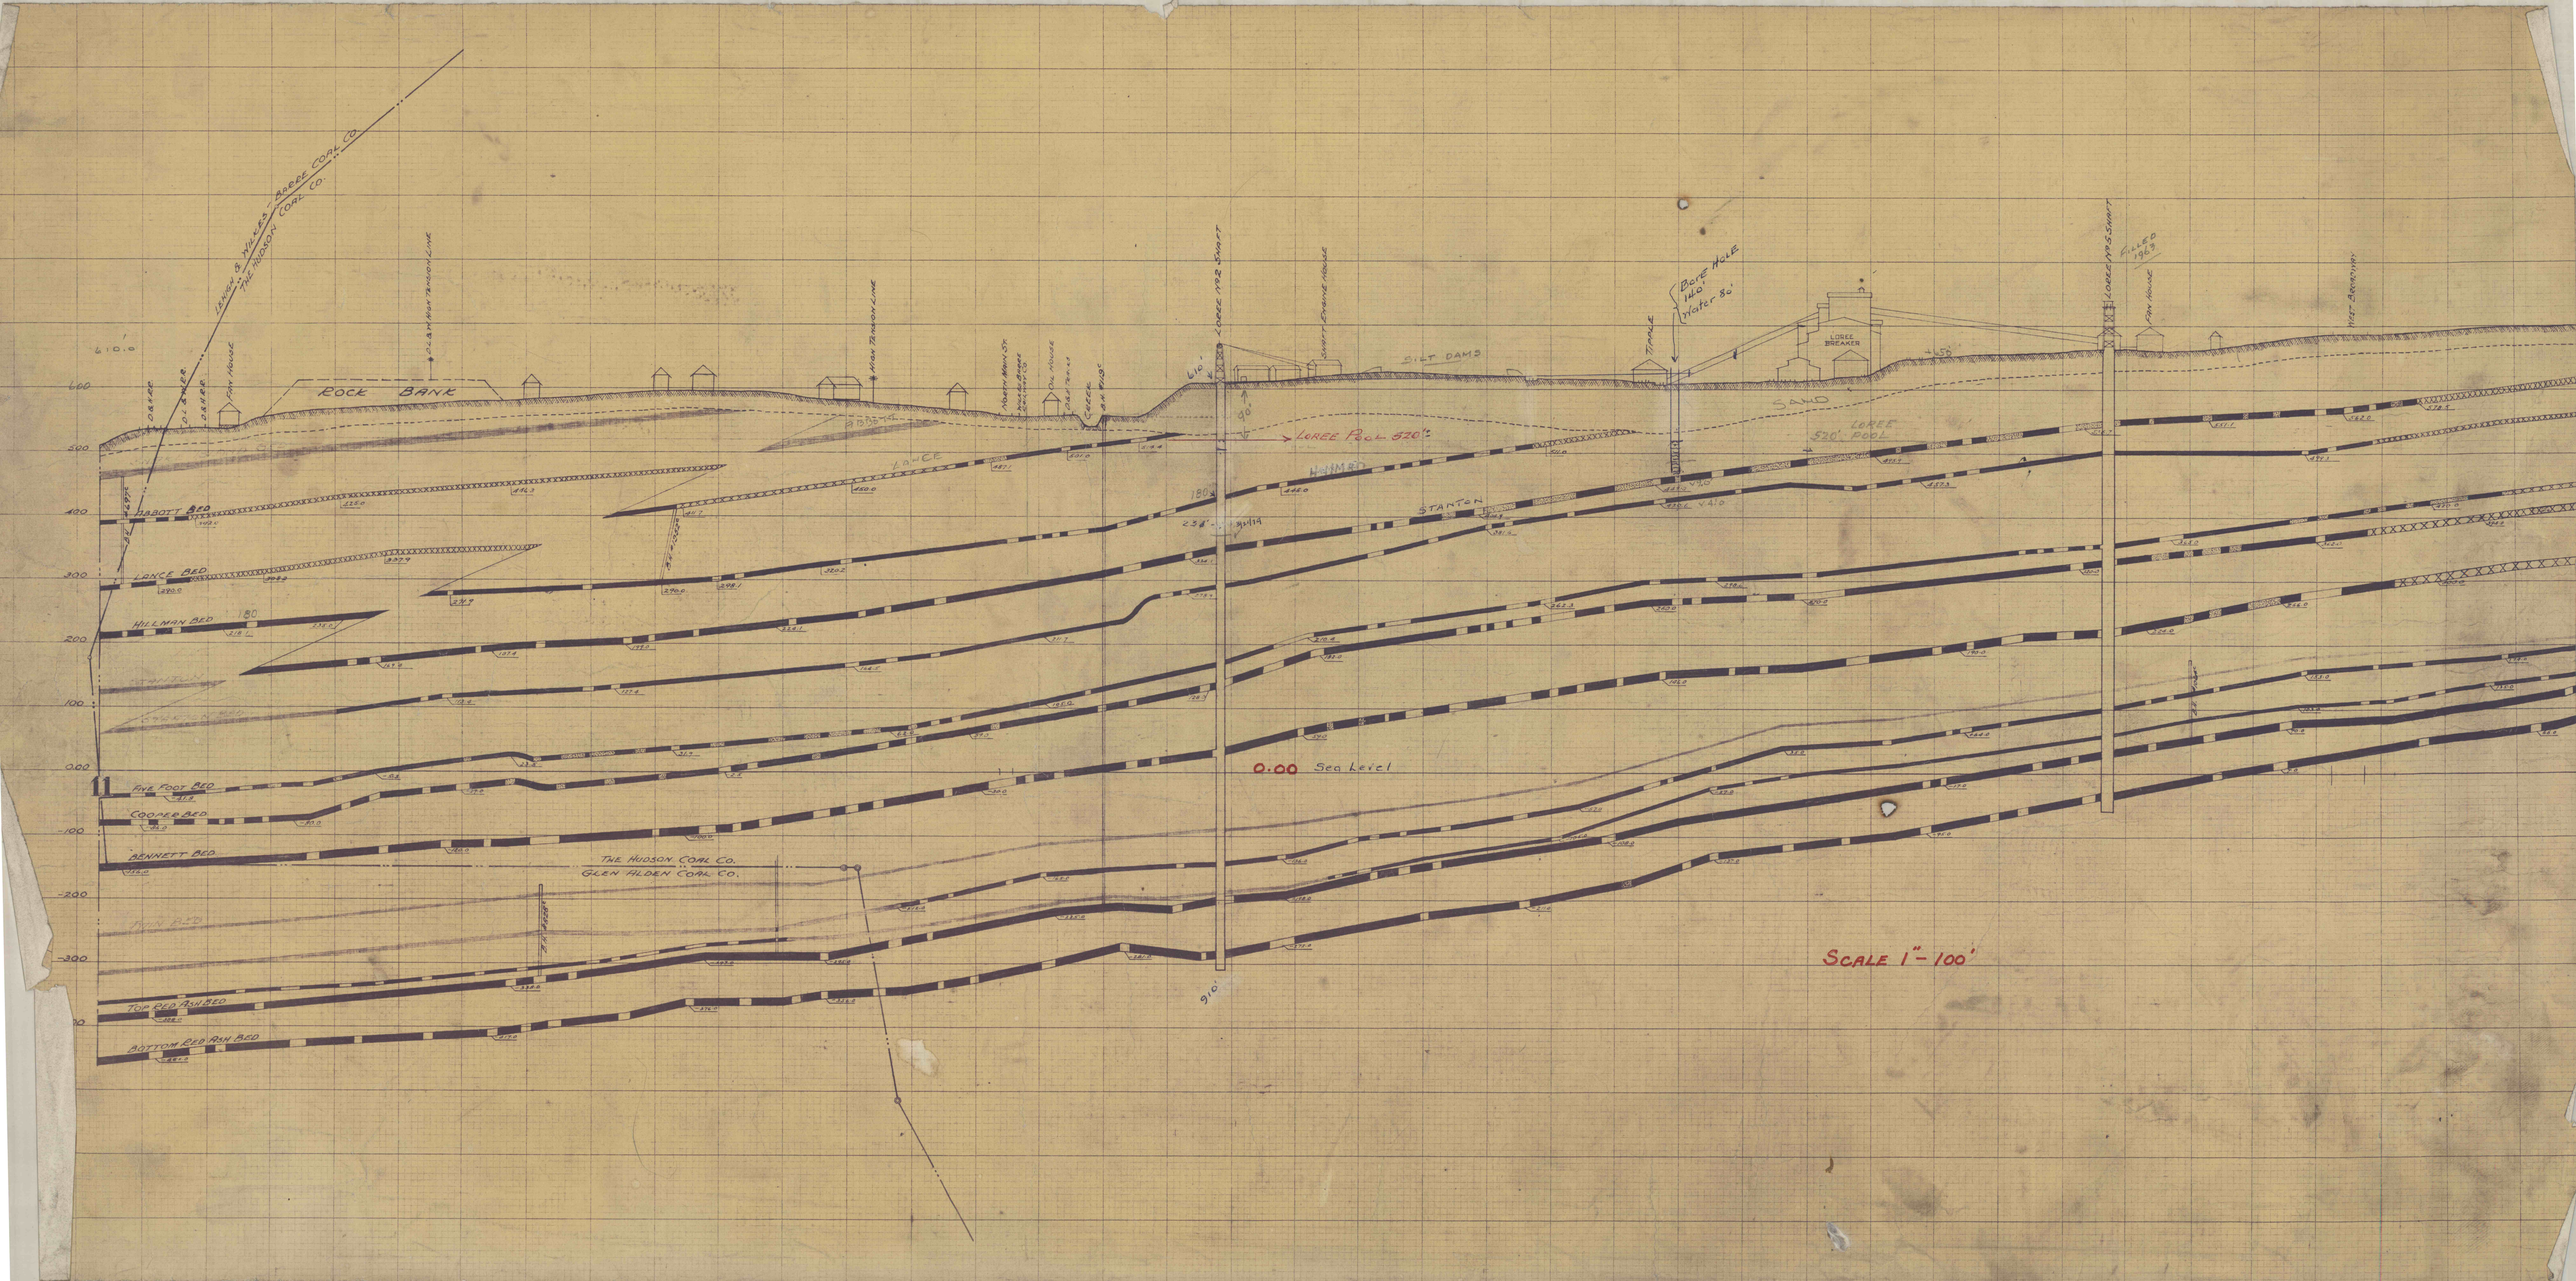

ROCK BANK
ABBOTT BED
LANCE BED
HILLMAN BED
STANTON
FIVE FOOT BED
COOPER BED
BENNETT BED
TOP RED ASH BED
BOTTOM RED ASH BED
LOREE POOL 520'±
0.00 Sea Level
SILT DAMS
SAND
LOREE 520' POOL
BORE HOLE 180' Water 80'
LOREE BREAKER
LOREE 1912 SHAFT
LOREE No. 5 SHAFT
FILLED 1963
FAN HOUSE
SCALE 1"=100'
THE HUDSON COAL CO.
GLEN ALDEN COAL CO.
IRWIN & WILKES - ABERE COAL CO.
THE HUDSON COAL CO.