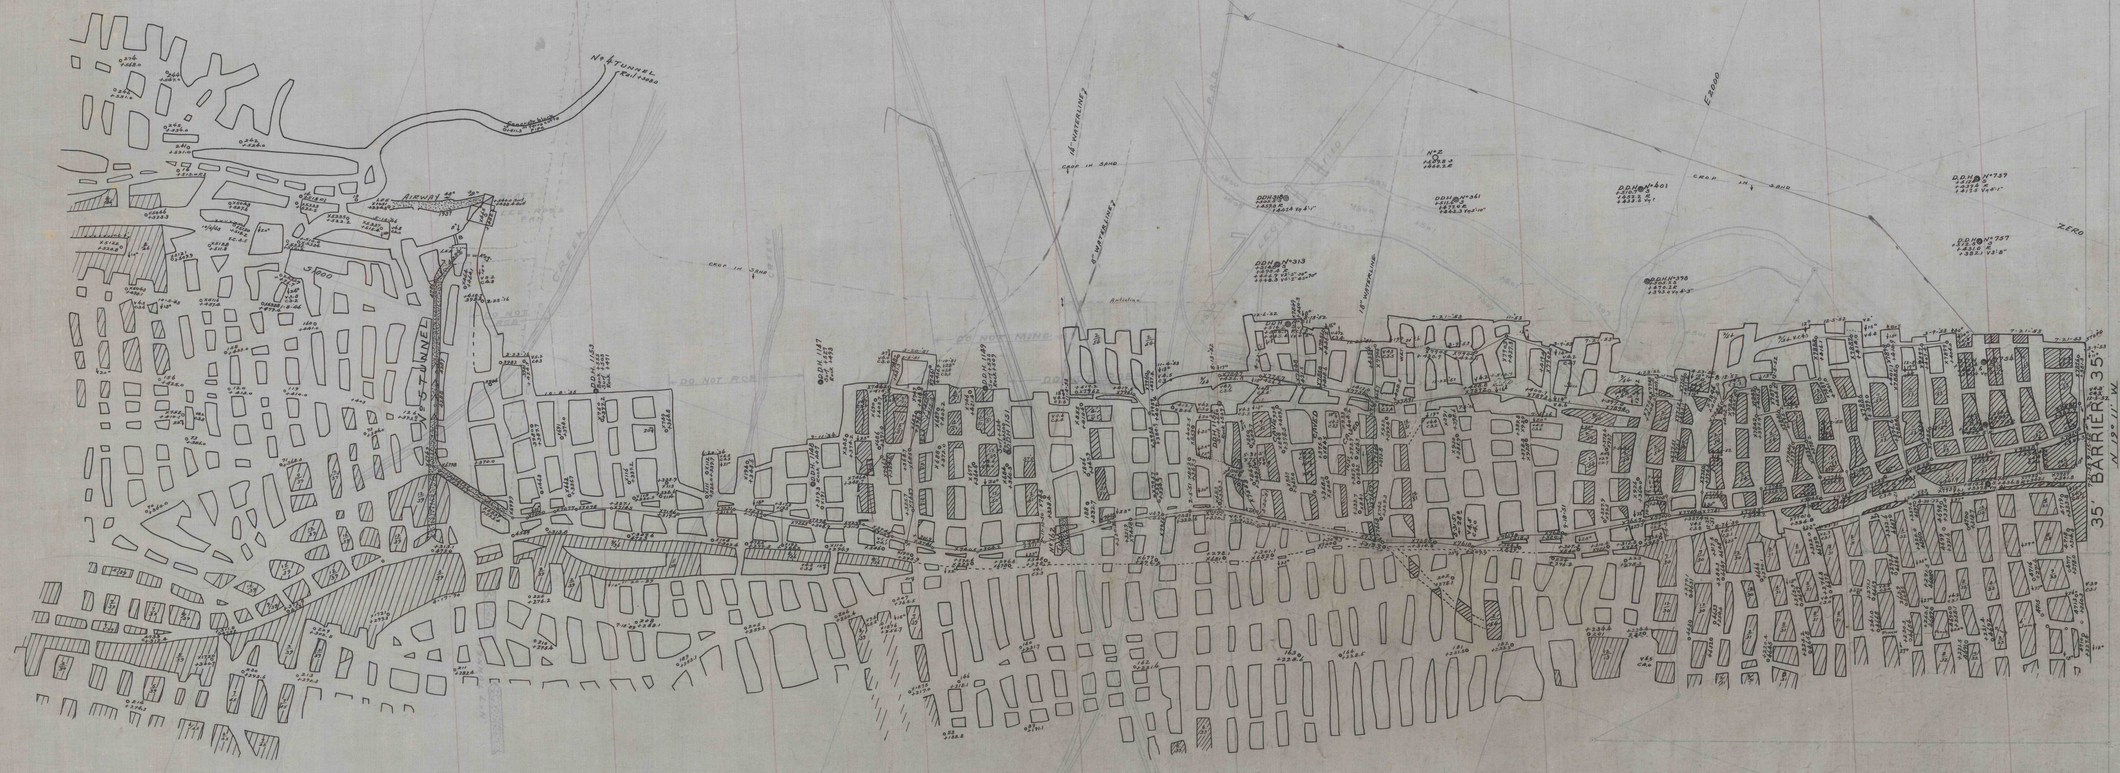
No. 4 TUNNEL Trailhead
AIRWAY
No. 4 TUNNEL
3000
CROP. IN SAND
18" WATERLINE
18" WATERLINE
18" WATERLINE
DO NOT MINE
DO NOT
DDH N-313
DDH N-361
DDH N-401
DDH N-396
DDH N-737
DDH N-787
E 1000
E 2000
ZERO
35' BARRIER
M 121 W

