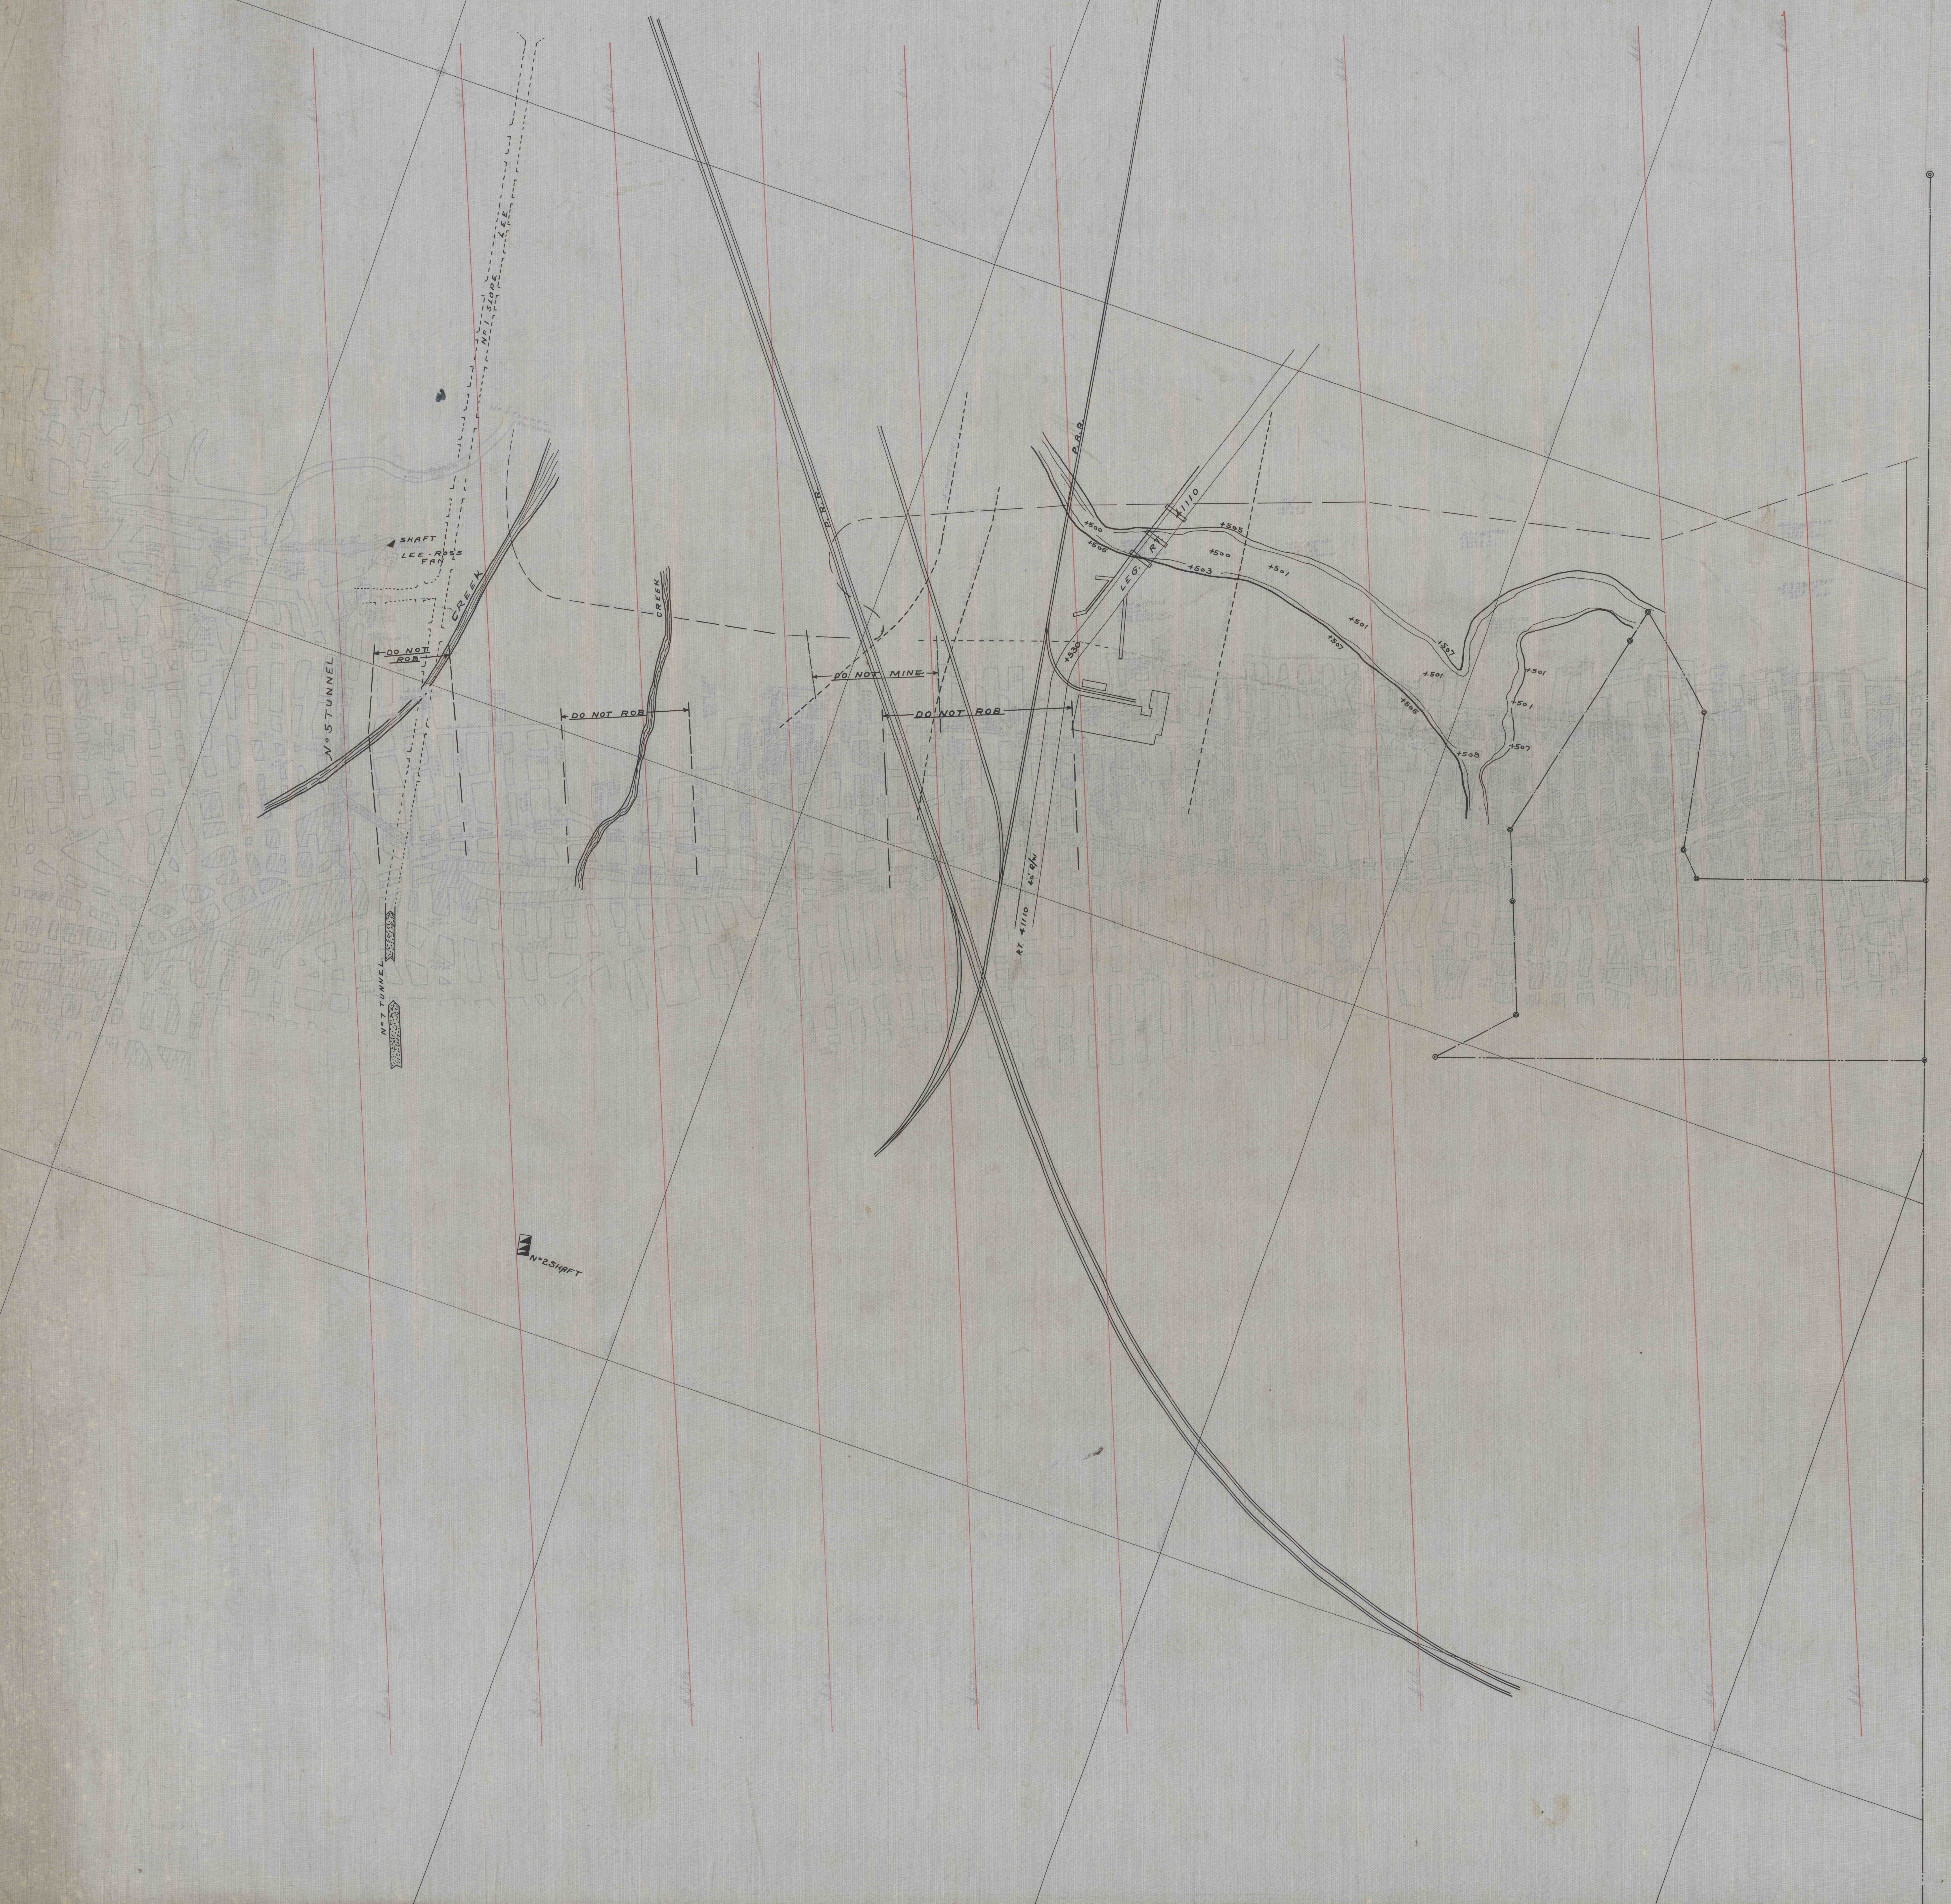
SHAFT
LEE-ROSS FAN
No 1 SLOPE
LEE
CREEK
No 5 TUNNEL
DO NOT ROB
No 7 TUNNEL
CREEK
DO NOT ROB
P.R.R.
DO NOT MINE
DO NOT ROB
P.R.R.
LEG. RT 1110
RT 41110 40' R/W
+500
+505
+505
+503
+500
+501
+501
+507
+507
+501
+505
+508
+530
+501
+501
+507
35' BARRIER 35'
No 2 SHAFT