


This map is not recorded as shown, in that the previously recorded lots (shaded and cross hatched) have been left off by the recorder at H.A.Gordons request and only the skeleton of Enterprise, Arch, Ridge and Spring Streets shown. Attached hereto is a copy of map as actually recorded in Deed Book 3 Page 219. October 26, 1931.

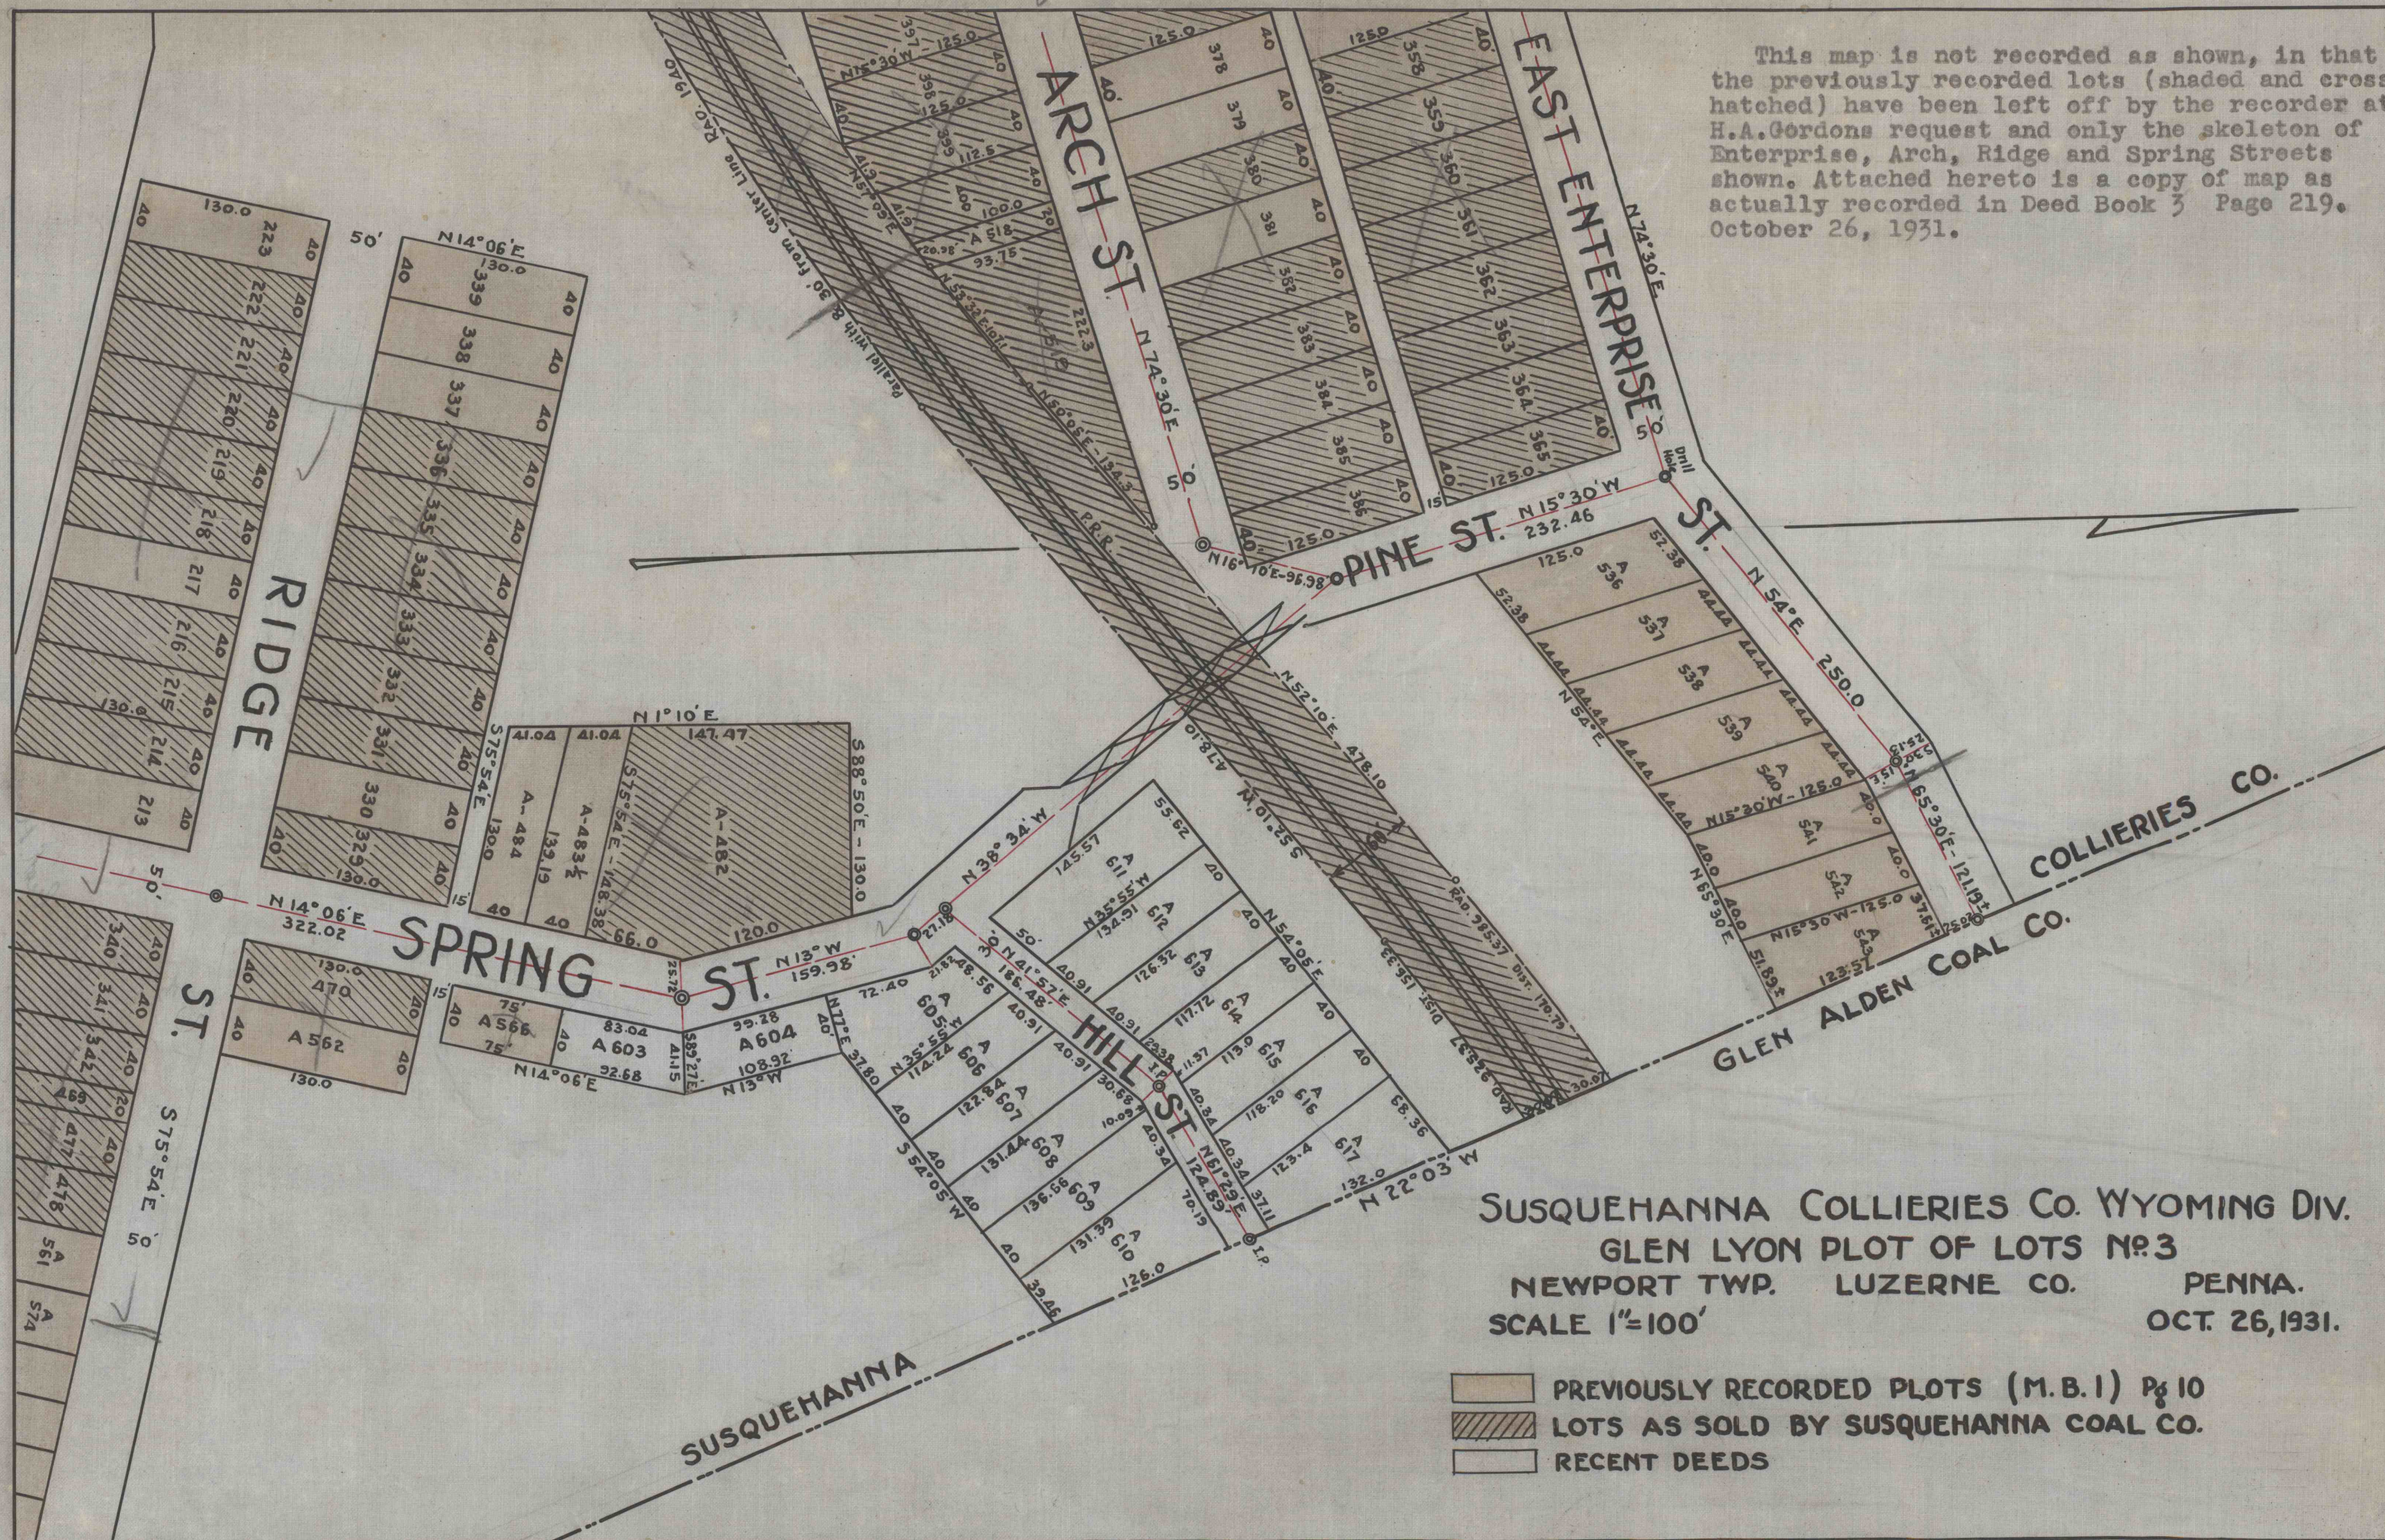

SUSQUEHANNA COLLIERIES CO. WYOMING DIV.
 GLEN LYON PLOT OF LOTS No. 3
 NEWPORT TWP. LUZERNE CO. PENNA.
 SCALE 1"=100'
 OCT. 26, 1931.

- PREVIOUSLY RECORDED PLOTS (M.B.1) Pg 10
- LOTS AS SOLD BY SUSQUEHANNA COAL CO.
- RECENT DEEDS

B 3 P 219