


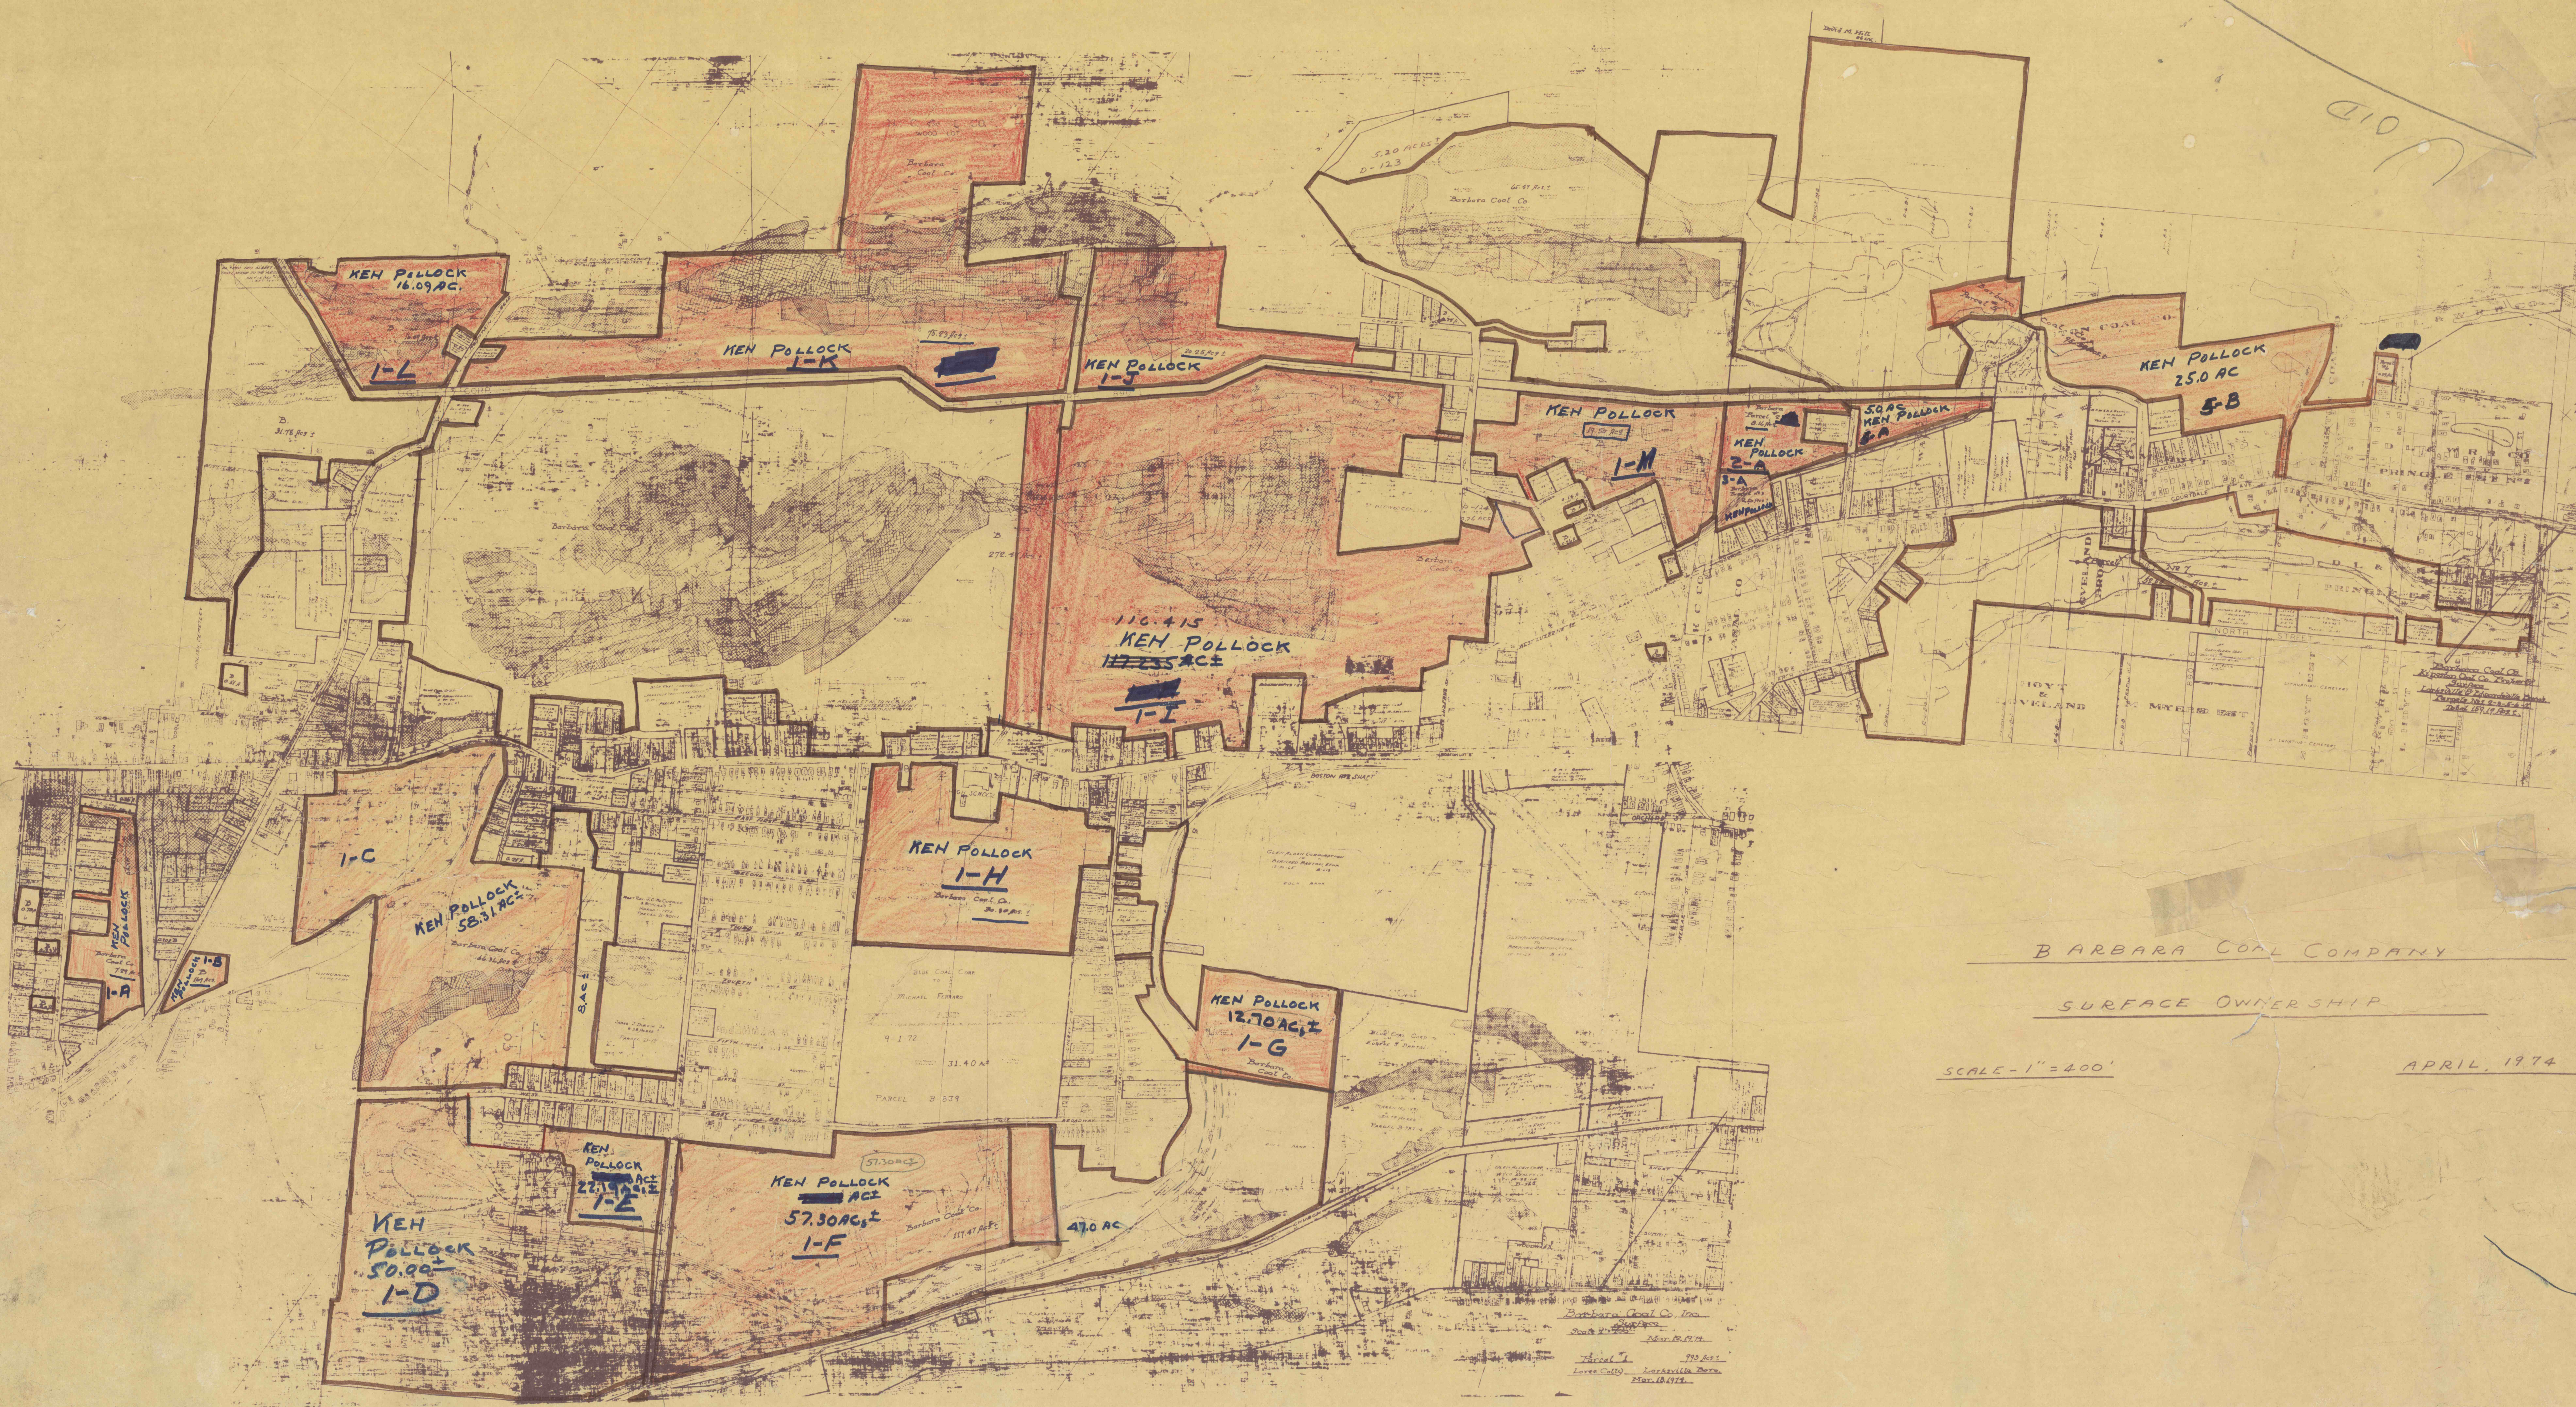

BARBARA COAL COMPANY

SURFACE OWNERSHIP

SCALE - 1" = 400'

APRIL, 1974

14.05

8.14

470