


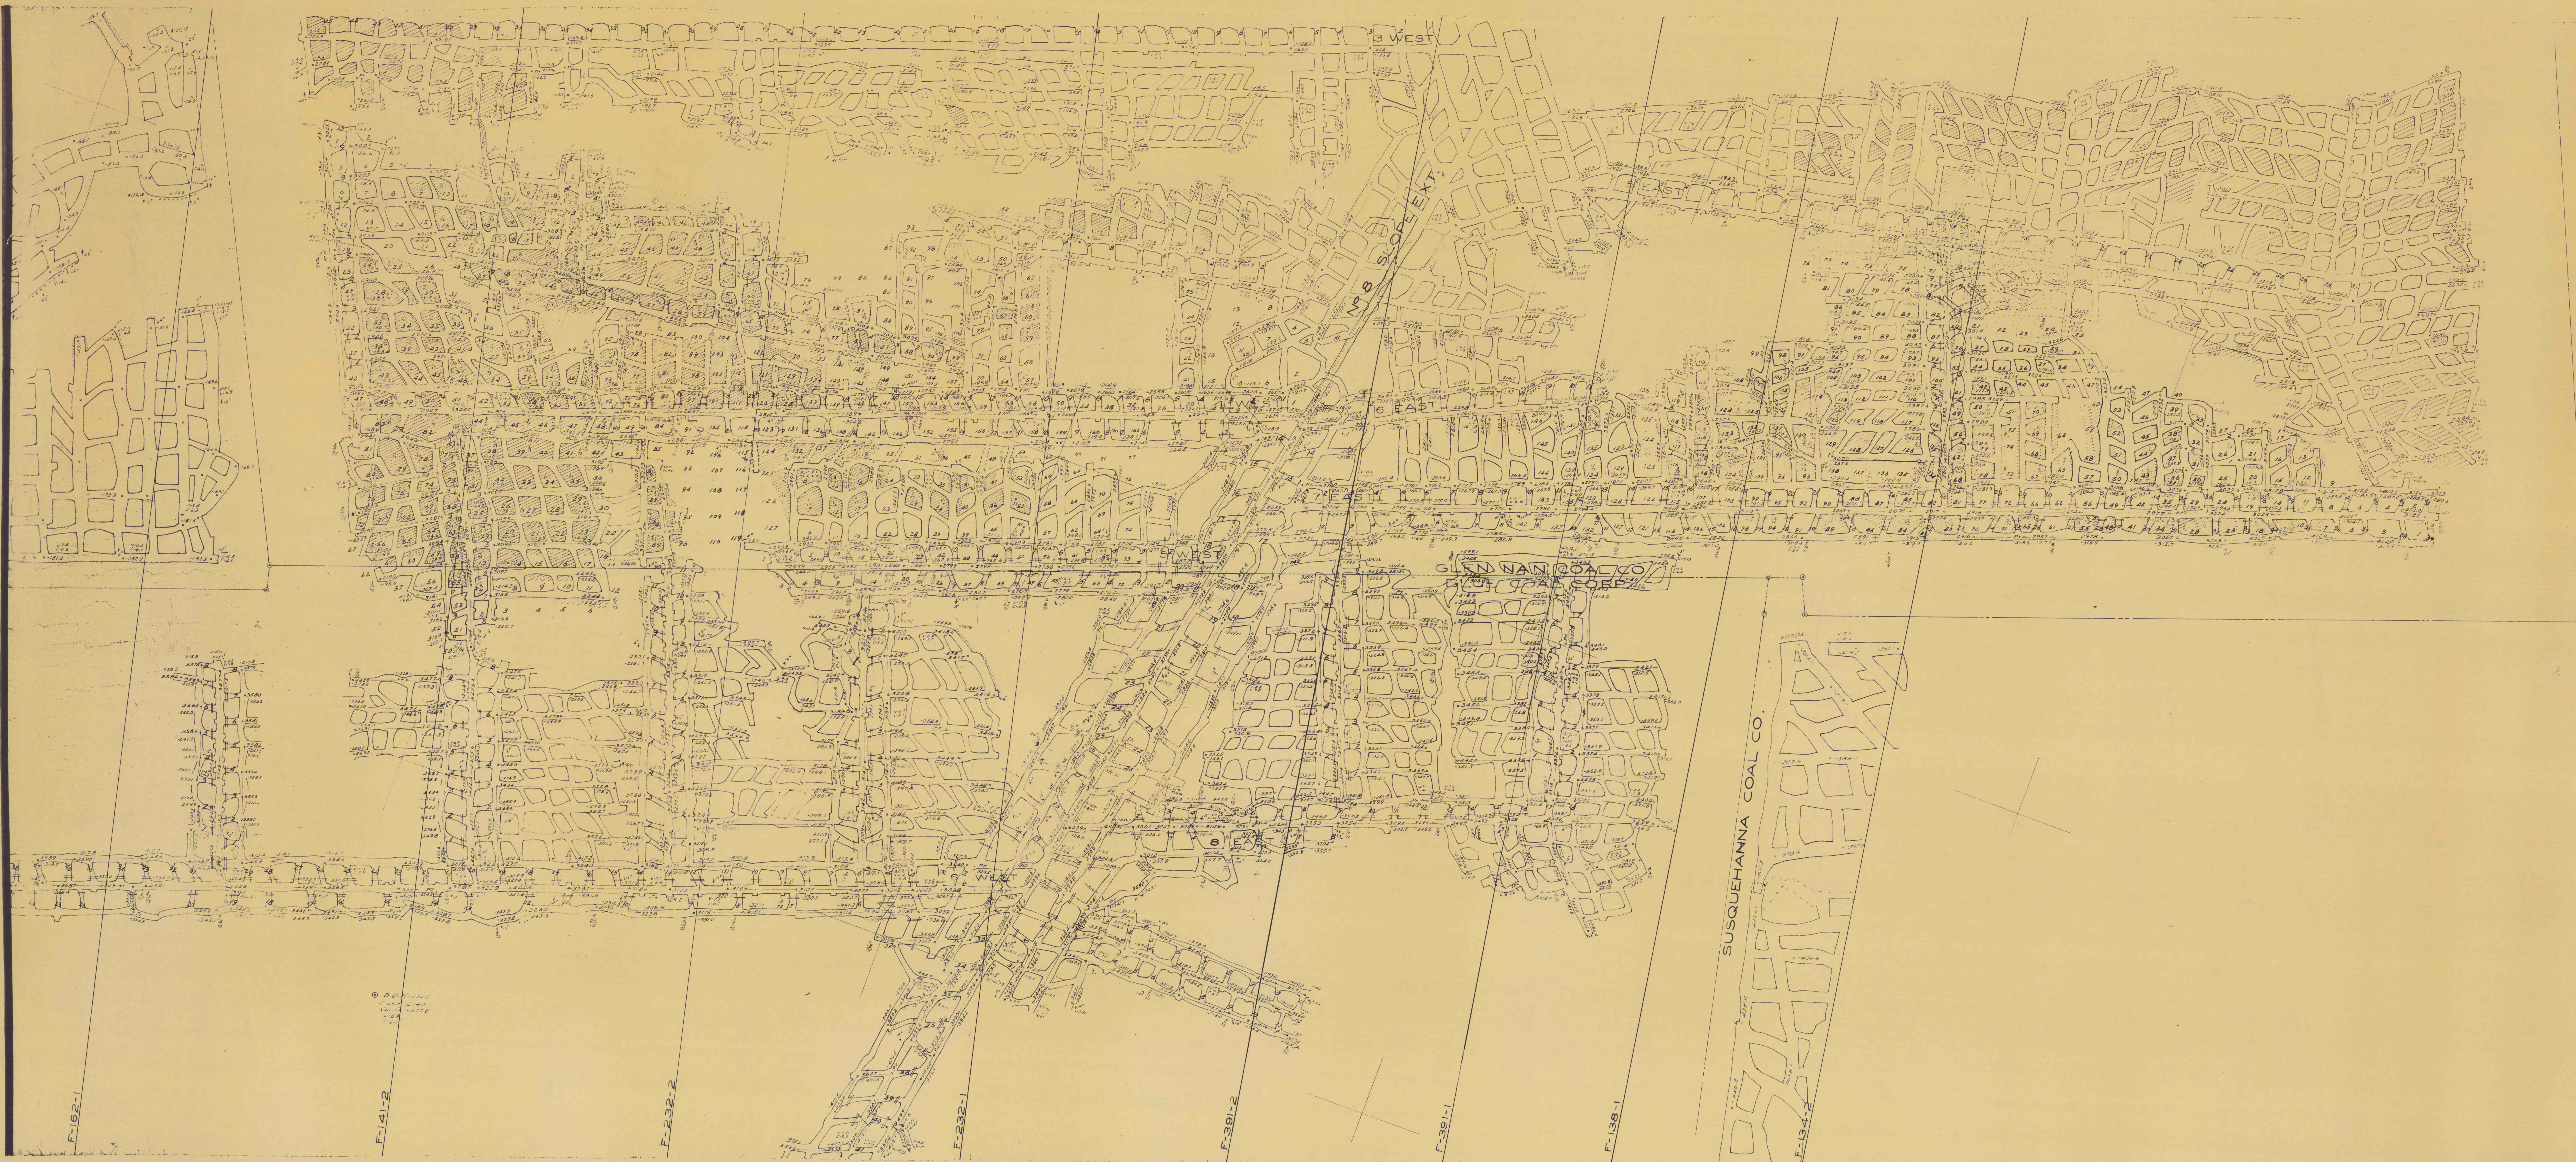

F-162-1

F-141-2

F-232-2

F-232-1

F-391-2

F-391-1

F-138-1

F-138-2