


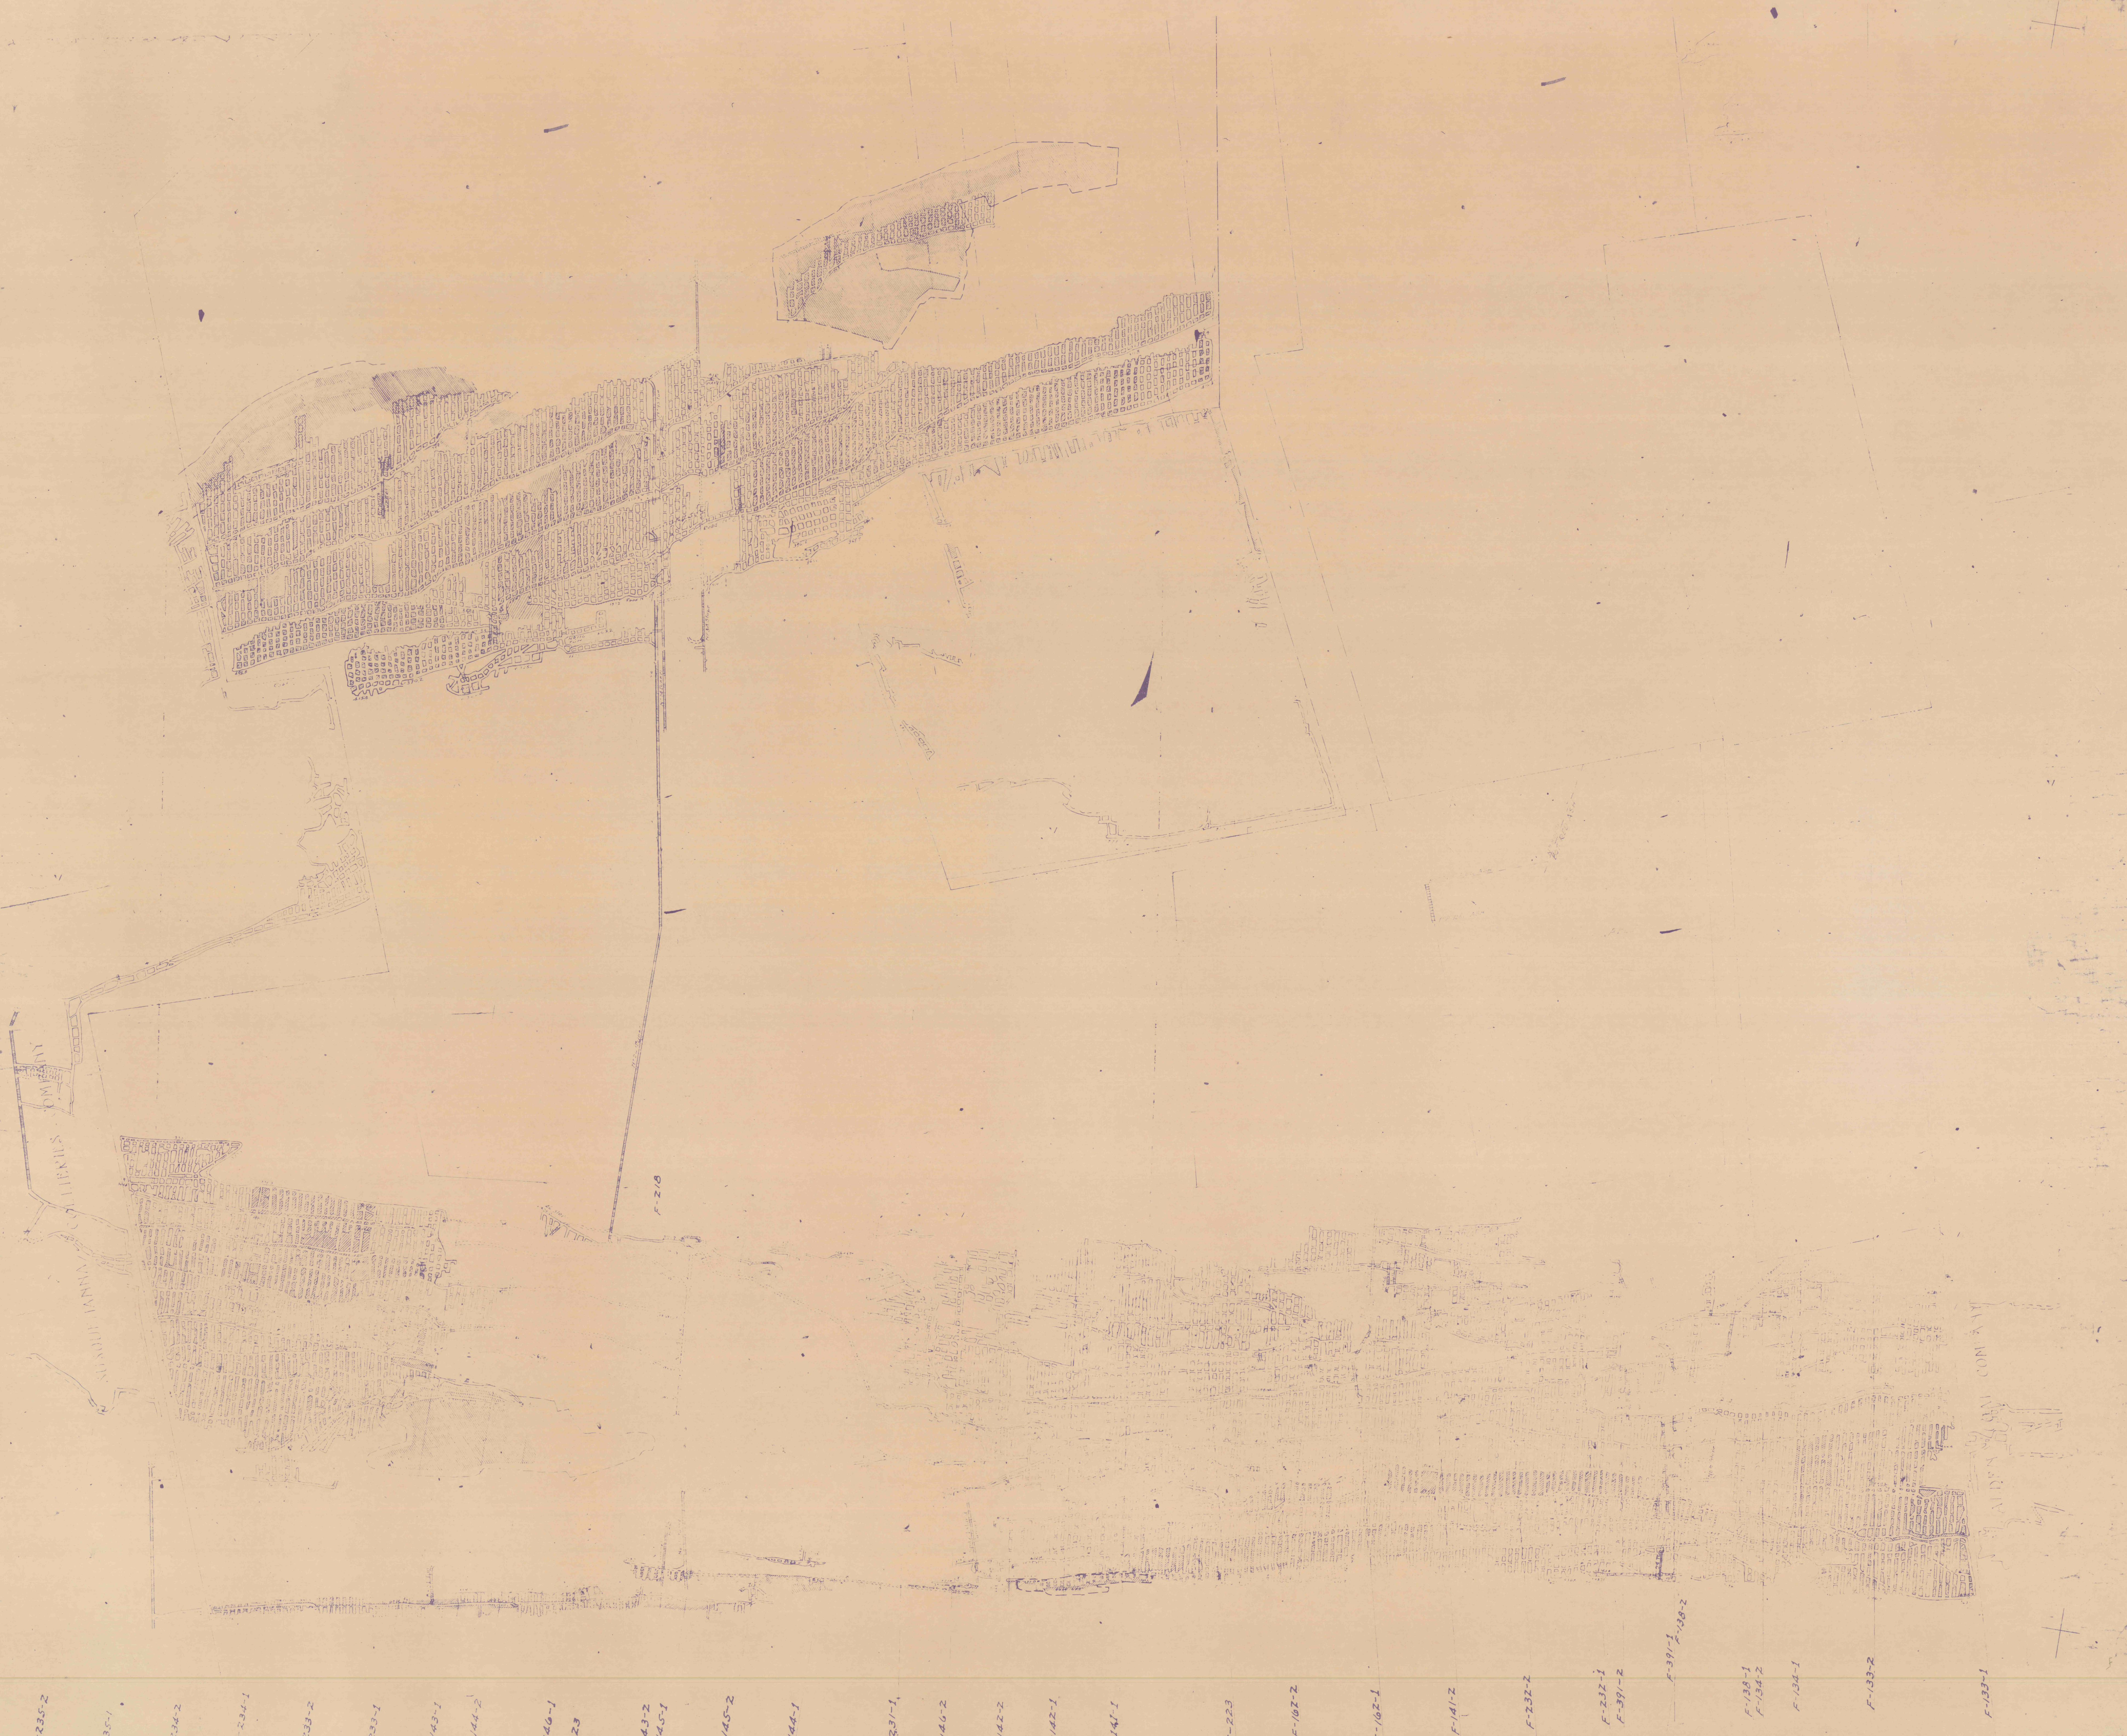

F-235-2
F-235-1
F-234-2
F-234-1
F-233-2
F-233-1
F-143-1
F-144-2
F-140-1
E-423
F-143-2
F-145-1
F-145-2
F-144-1
F-231-1
F-146-2
F-142-2
F-142-1
F-141-1
E-223
F-102-2
F-102-1
F-141-2
F-232-2
F-232-1
F-391-2
F-391-1
F-138-2
F-138-1
F-134-2
F-134-1
F-133-2
F-133-1

BOTTOM SPLIT - TOP RED ASH VEIN
WANAMIE NOS. 18 & 19 COLLIERIES
Scale 1" = 500'