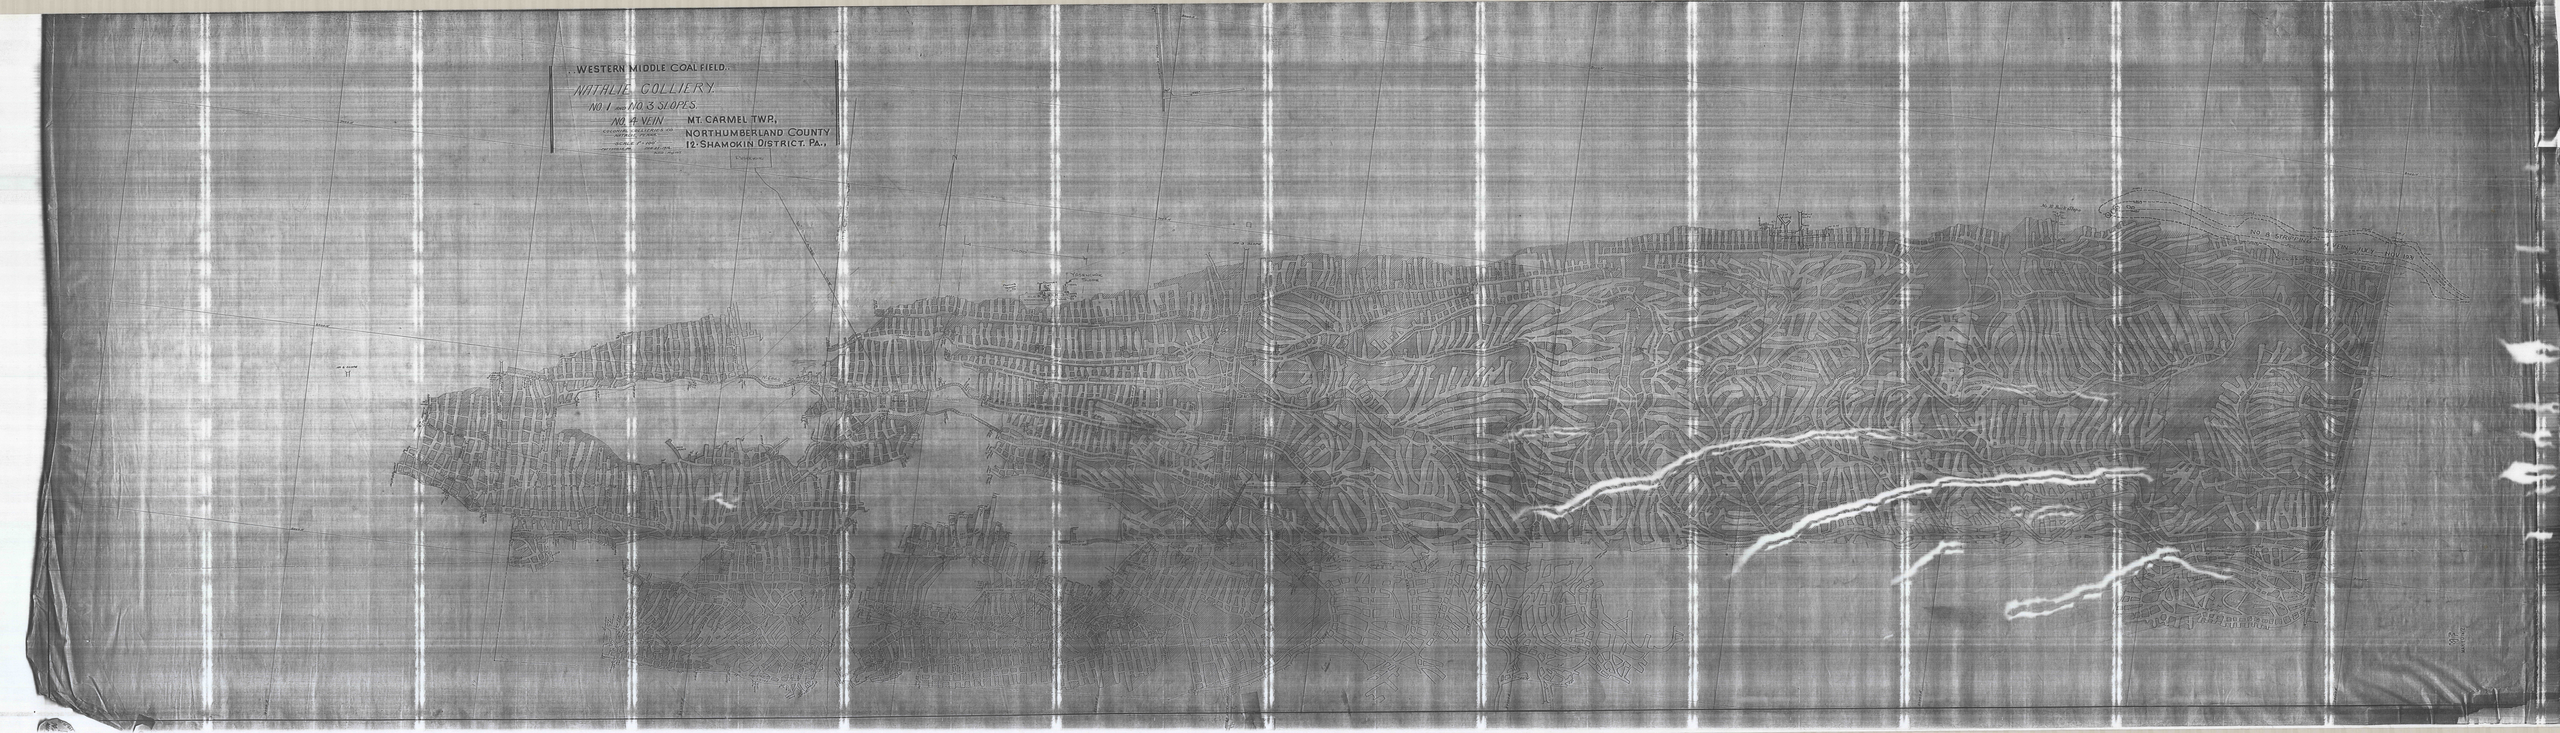

WESTERN MIDDLE COAL FIELD.
NITHLIE COLLIERY.
NO. 1 and NO. 3 SLOPES.
NO. 4 VEIN
MT. CARMEL TWP.,
NORTHUMBERLAND COUNTY
12 SHAMOKIN DISTRICT. PA.,