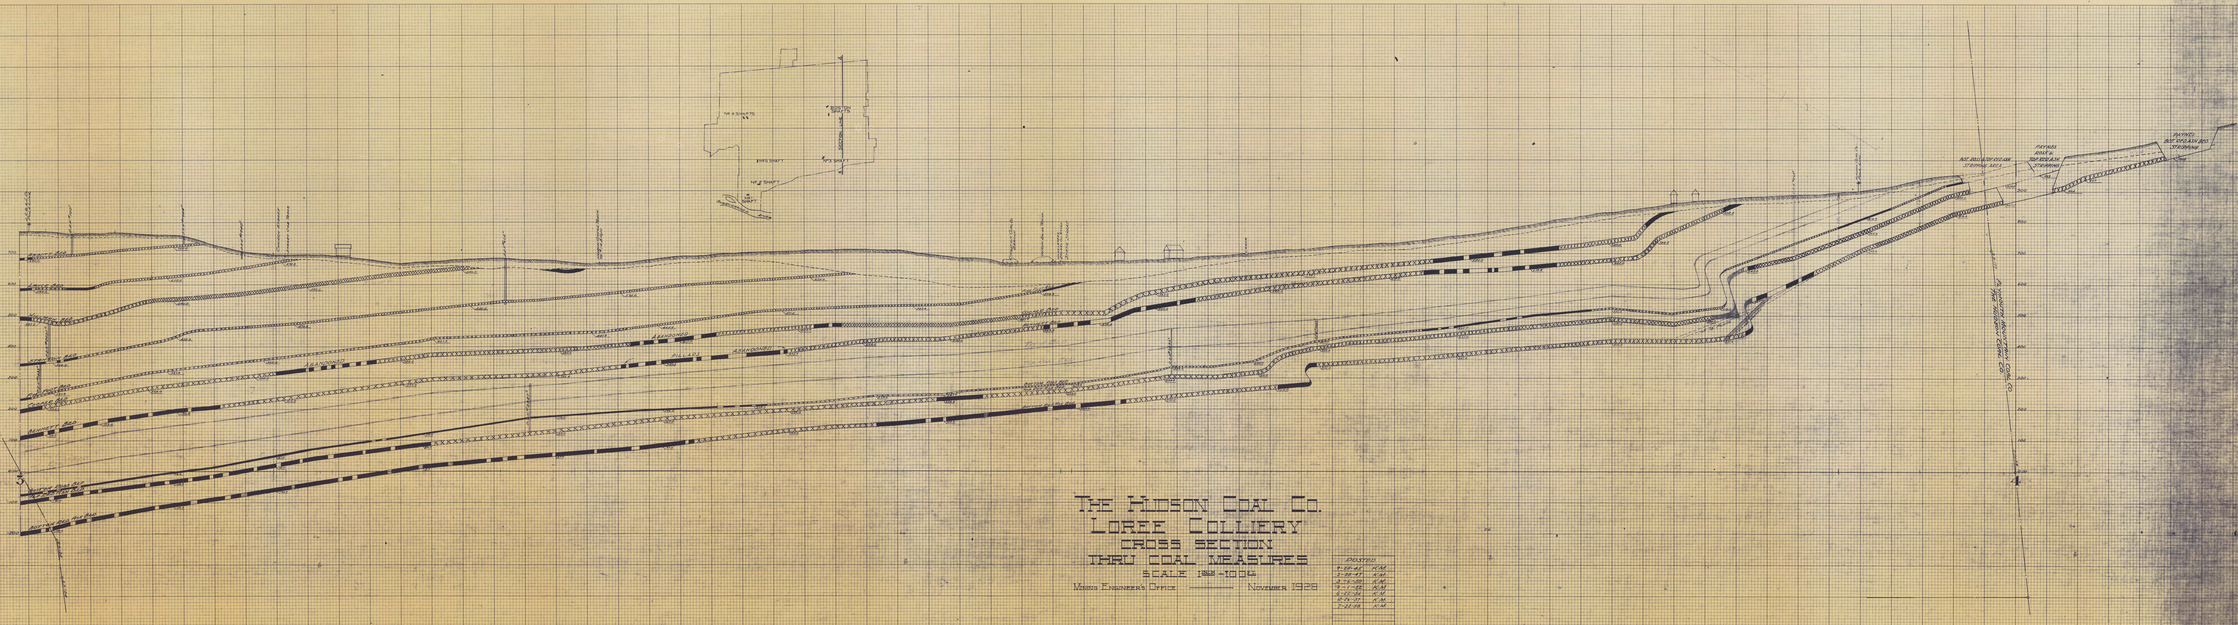

THE HUDSON COAL CO.
LOREE COLLIERY
CROSS SECTION
THRU COAL MEASURES

SCALE 1" = 100'

Mining Engineer's Office ——— November 1926


LOREE COLLIERY ——— CROSS SECTION 3-4

LOREE COLLIERY ——— CROSS SECTION 3-4