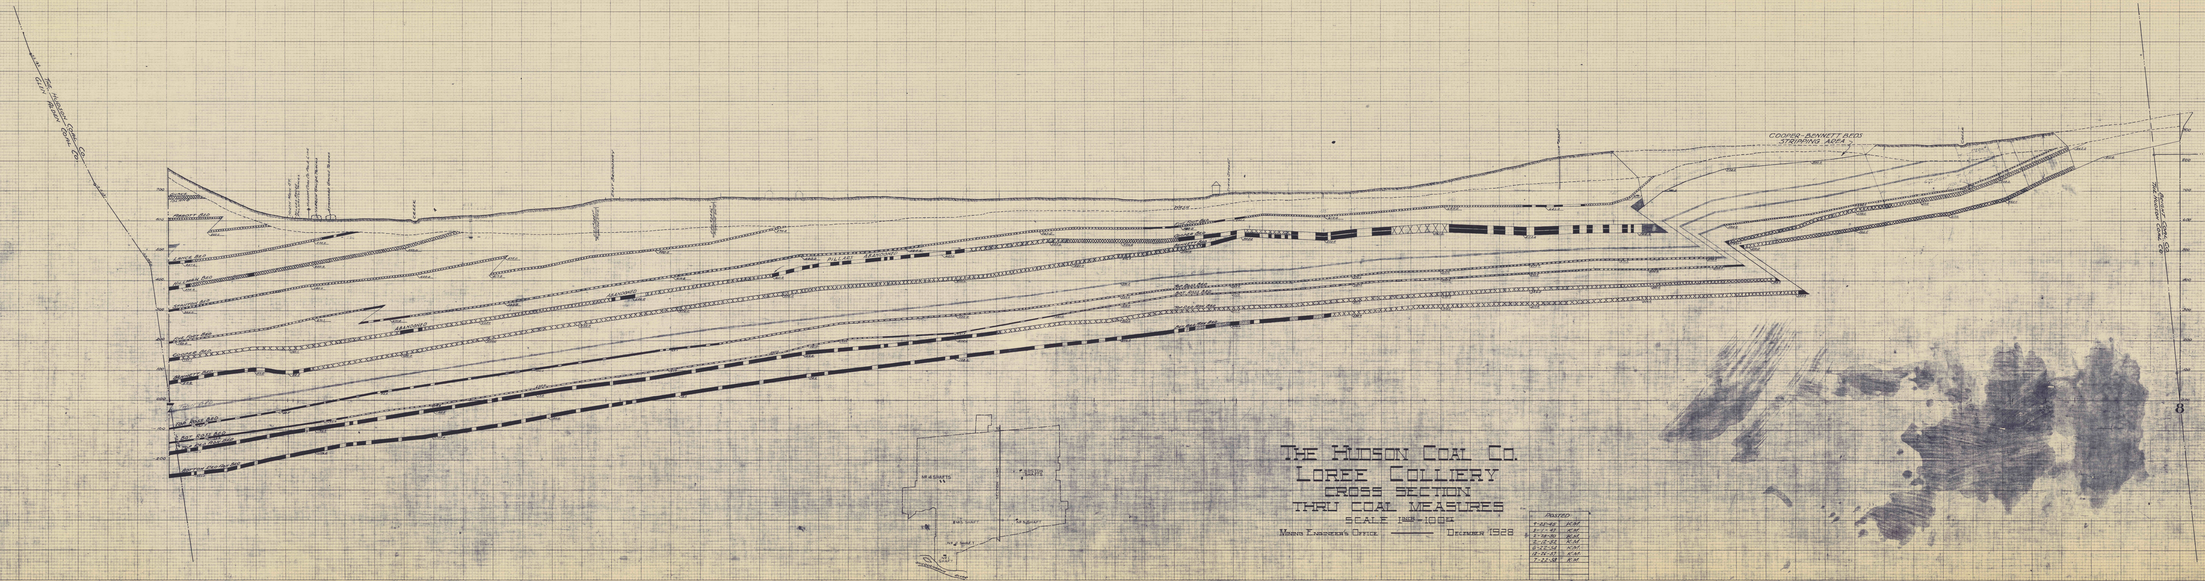

THE HUDSON COAL CO.
LOREE COLLIERY
CROSS SECTION
THRU COAL MEASURES

SCALE 1IN=100FT

MINING ENGINEER'S OFFICE ——— DECEMBER 1928

Abandoned	
1-4 & 4E	H.M.
2-3 & 3E	H.M.
3-4 & 4E	H.M.
5-7 & 7A	H.M.
6-7 & 7A	H.M.
6-8 & 8E	H.M.
7-7A & 8E	H.M.

LOREE COLLIERY ——— CROSS SECTION 8-8

CROSS SECTION 8-8 ——— LOREE COLLIERY