


PLYMOUTH

BLUE COAL CO.
BARBED COAL CO.
LANCE STRIPPING
PIT

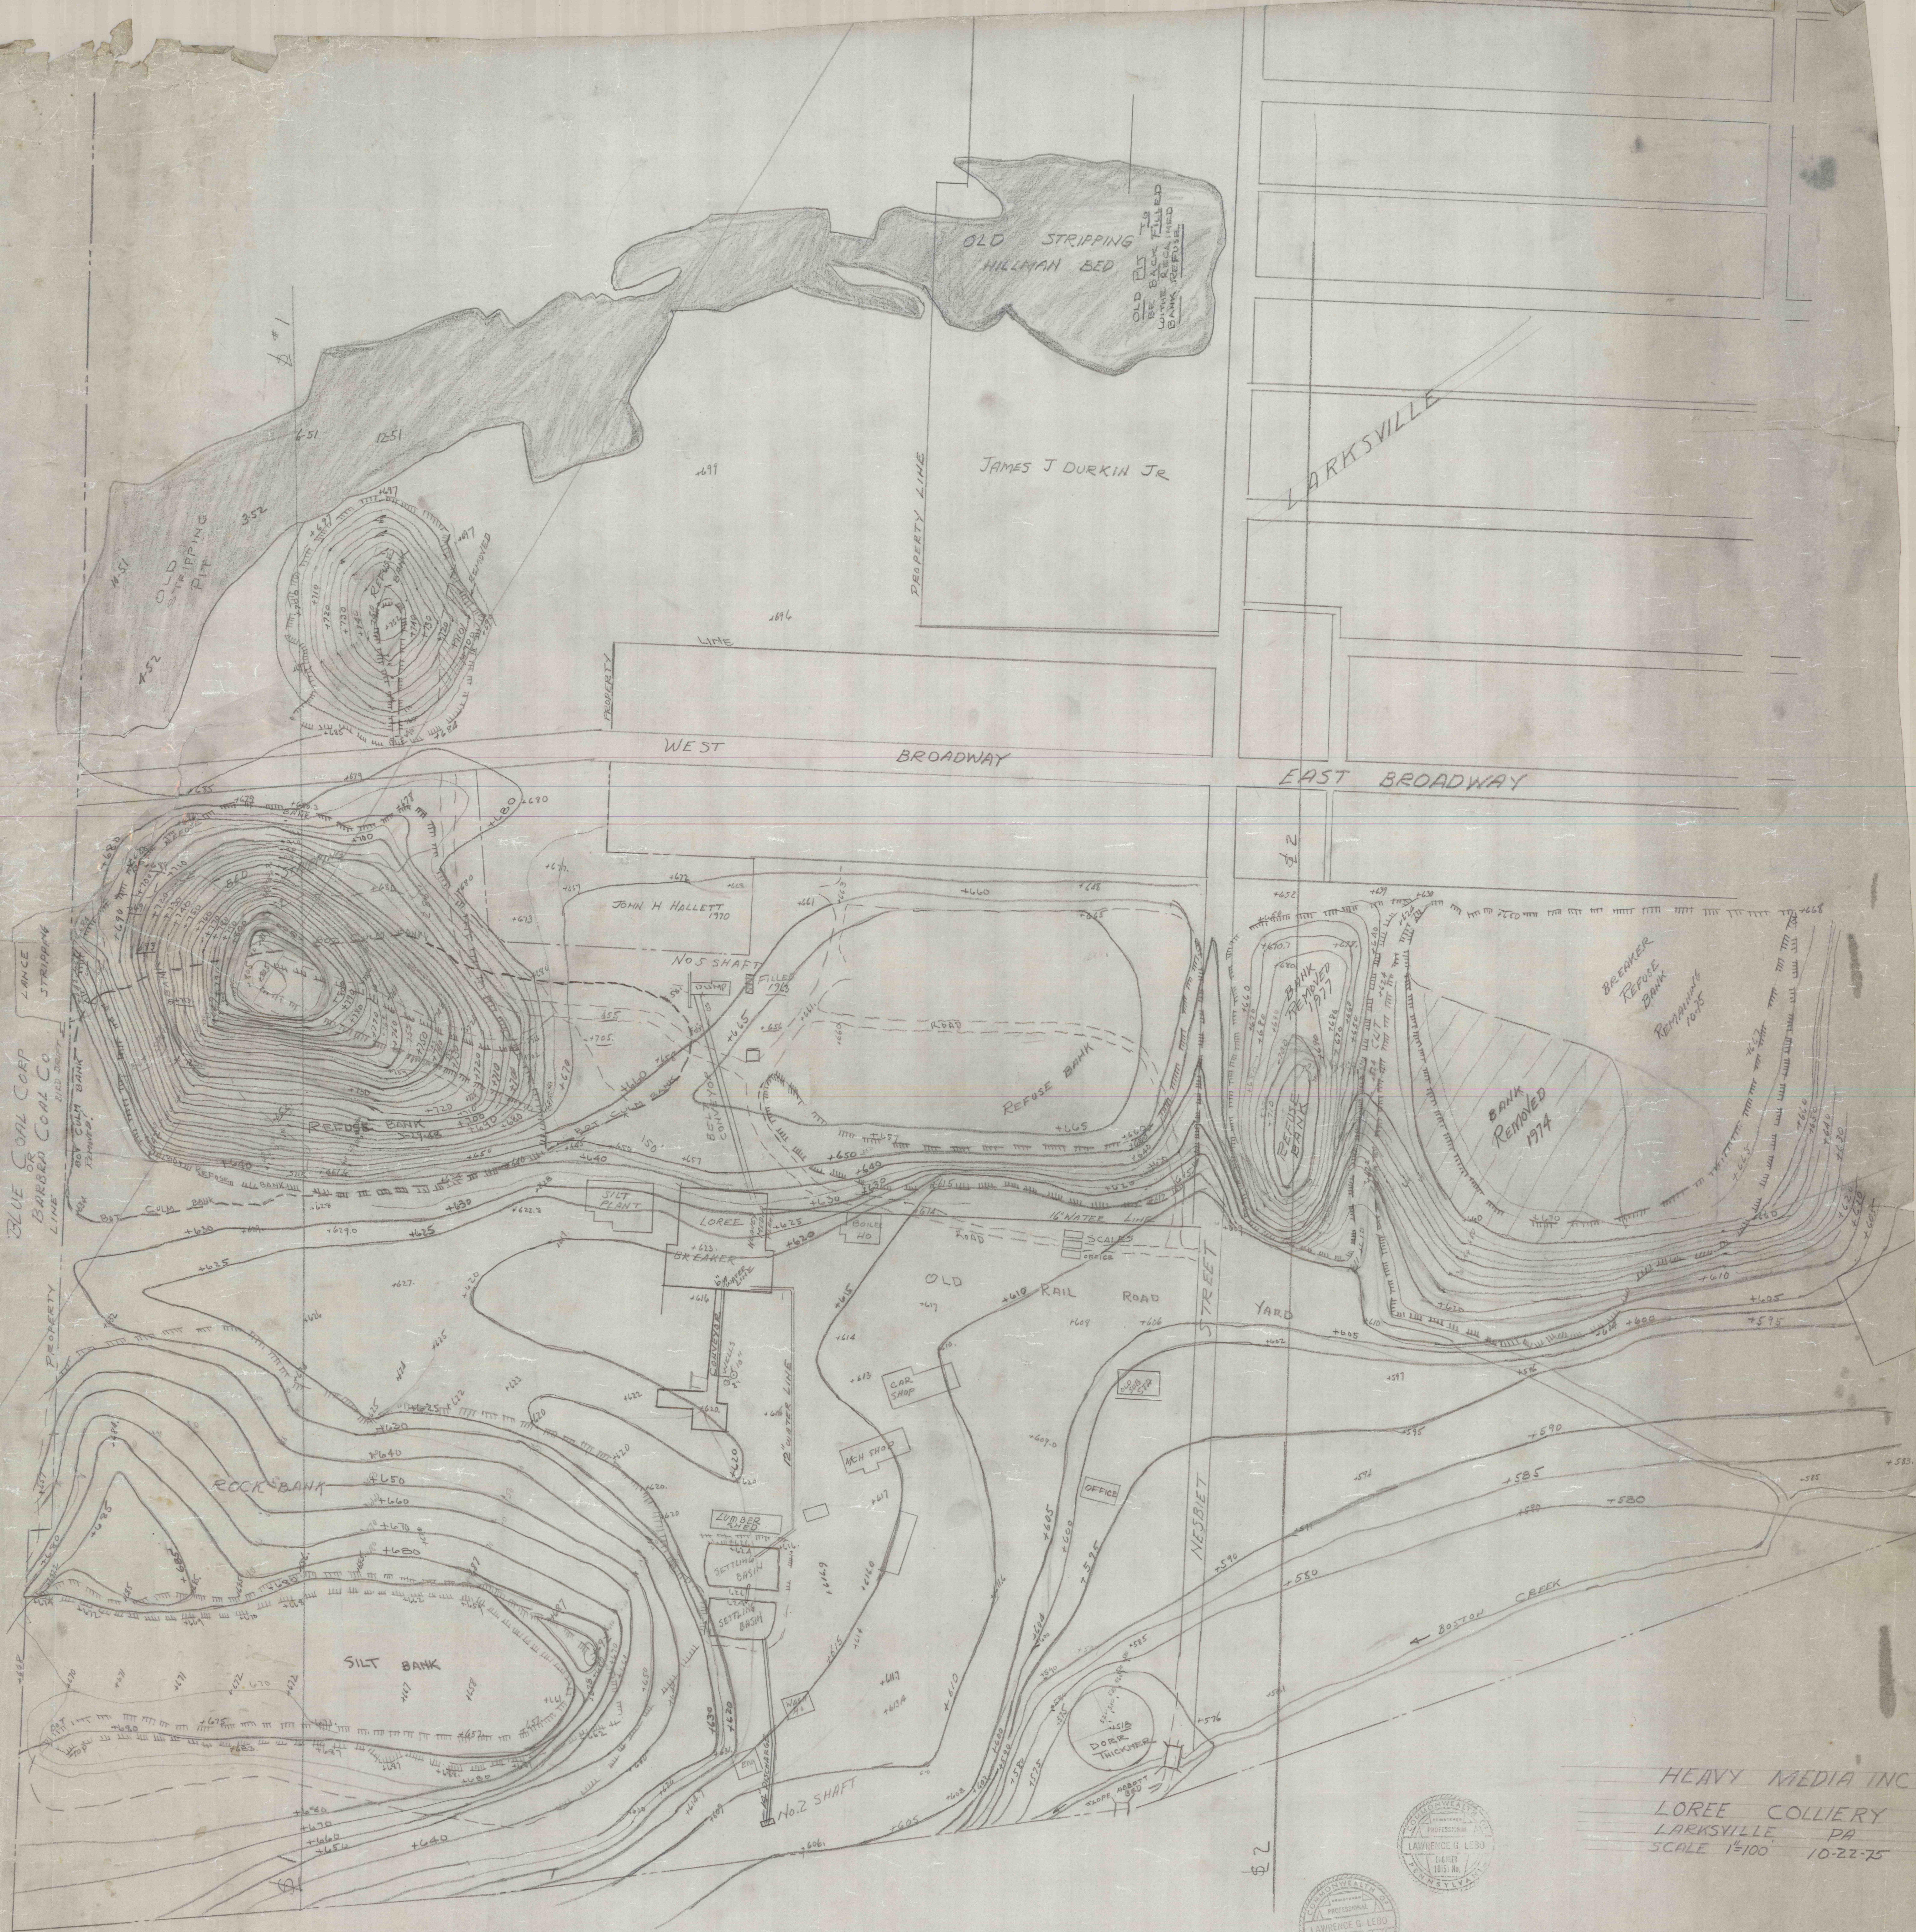

OLD STRIPPING
HILLMAN BED

OLD PIT
BE BACK FILLED
WITH RECLAIMED
BANK REFUSE

JAMES J DURKIN JR

LARKSVILLE

WEST BROADWAY

EAST BROADWAY

JOHN H HALLETT
1970

NO. 1 SHAFT

REFUSE BANK

BREAKER
REFUSE BANK
REMAINING
1975

BANK
REMOVED
1974

ROCK BANK

SILT BANK

CAR SHOP

MCH SHOP

LUMBER
SHED

SETTLING
BASIN

SETTLING
BASIN

NO. 2 SHAFT

OFFICE

DOCK
THICKER

HEAVY MEDIA INC

LOREE COLLIERY

LARKSVILLE PA

SCALE 1"=100' 10-22-75

