


WESTERN MIDDLE COAL FIELD, MT. CARMEL TWP., NORTHUMBERLAND COUNTY PA., 12 SHAMOKIN DISTRICT
Natalie Colliery - (Colonial Collieries Company - Operators)
Map showing the mine workings from No. 4 Slope and the relative position of Section Lines A-B and C.
Scale: 1 inch = 100 feet.
January, 1910
William S. Pugh,
Mining Engr., Pottsville

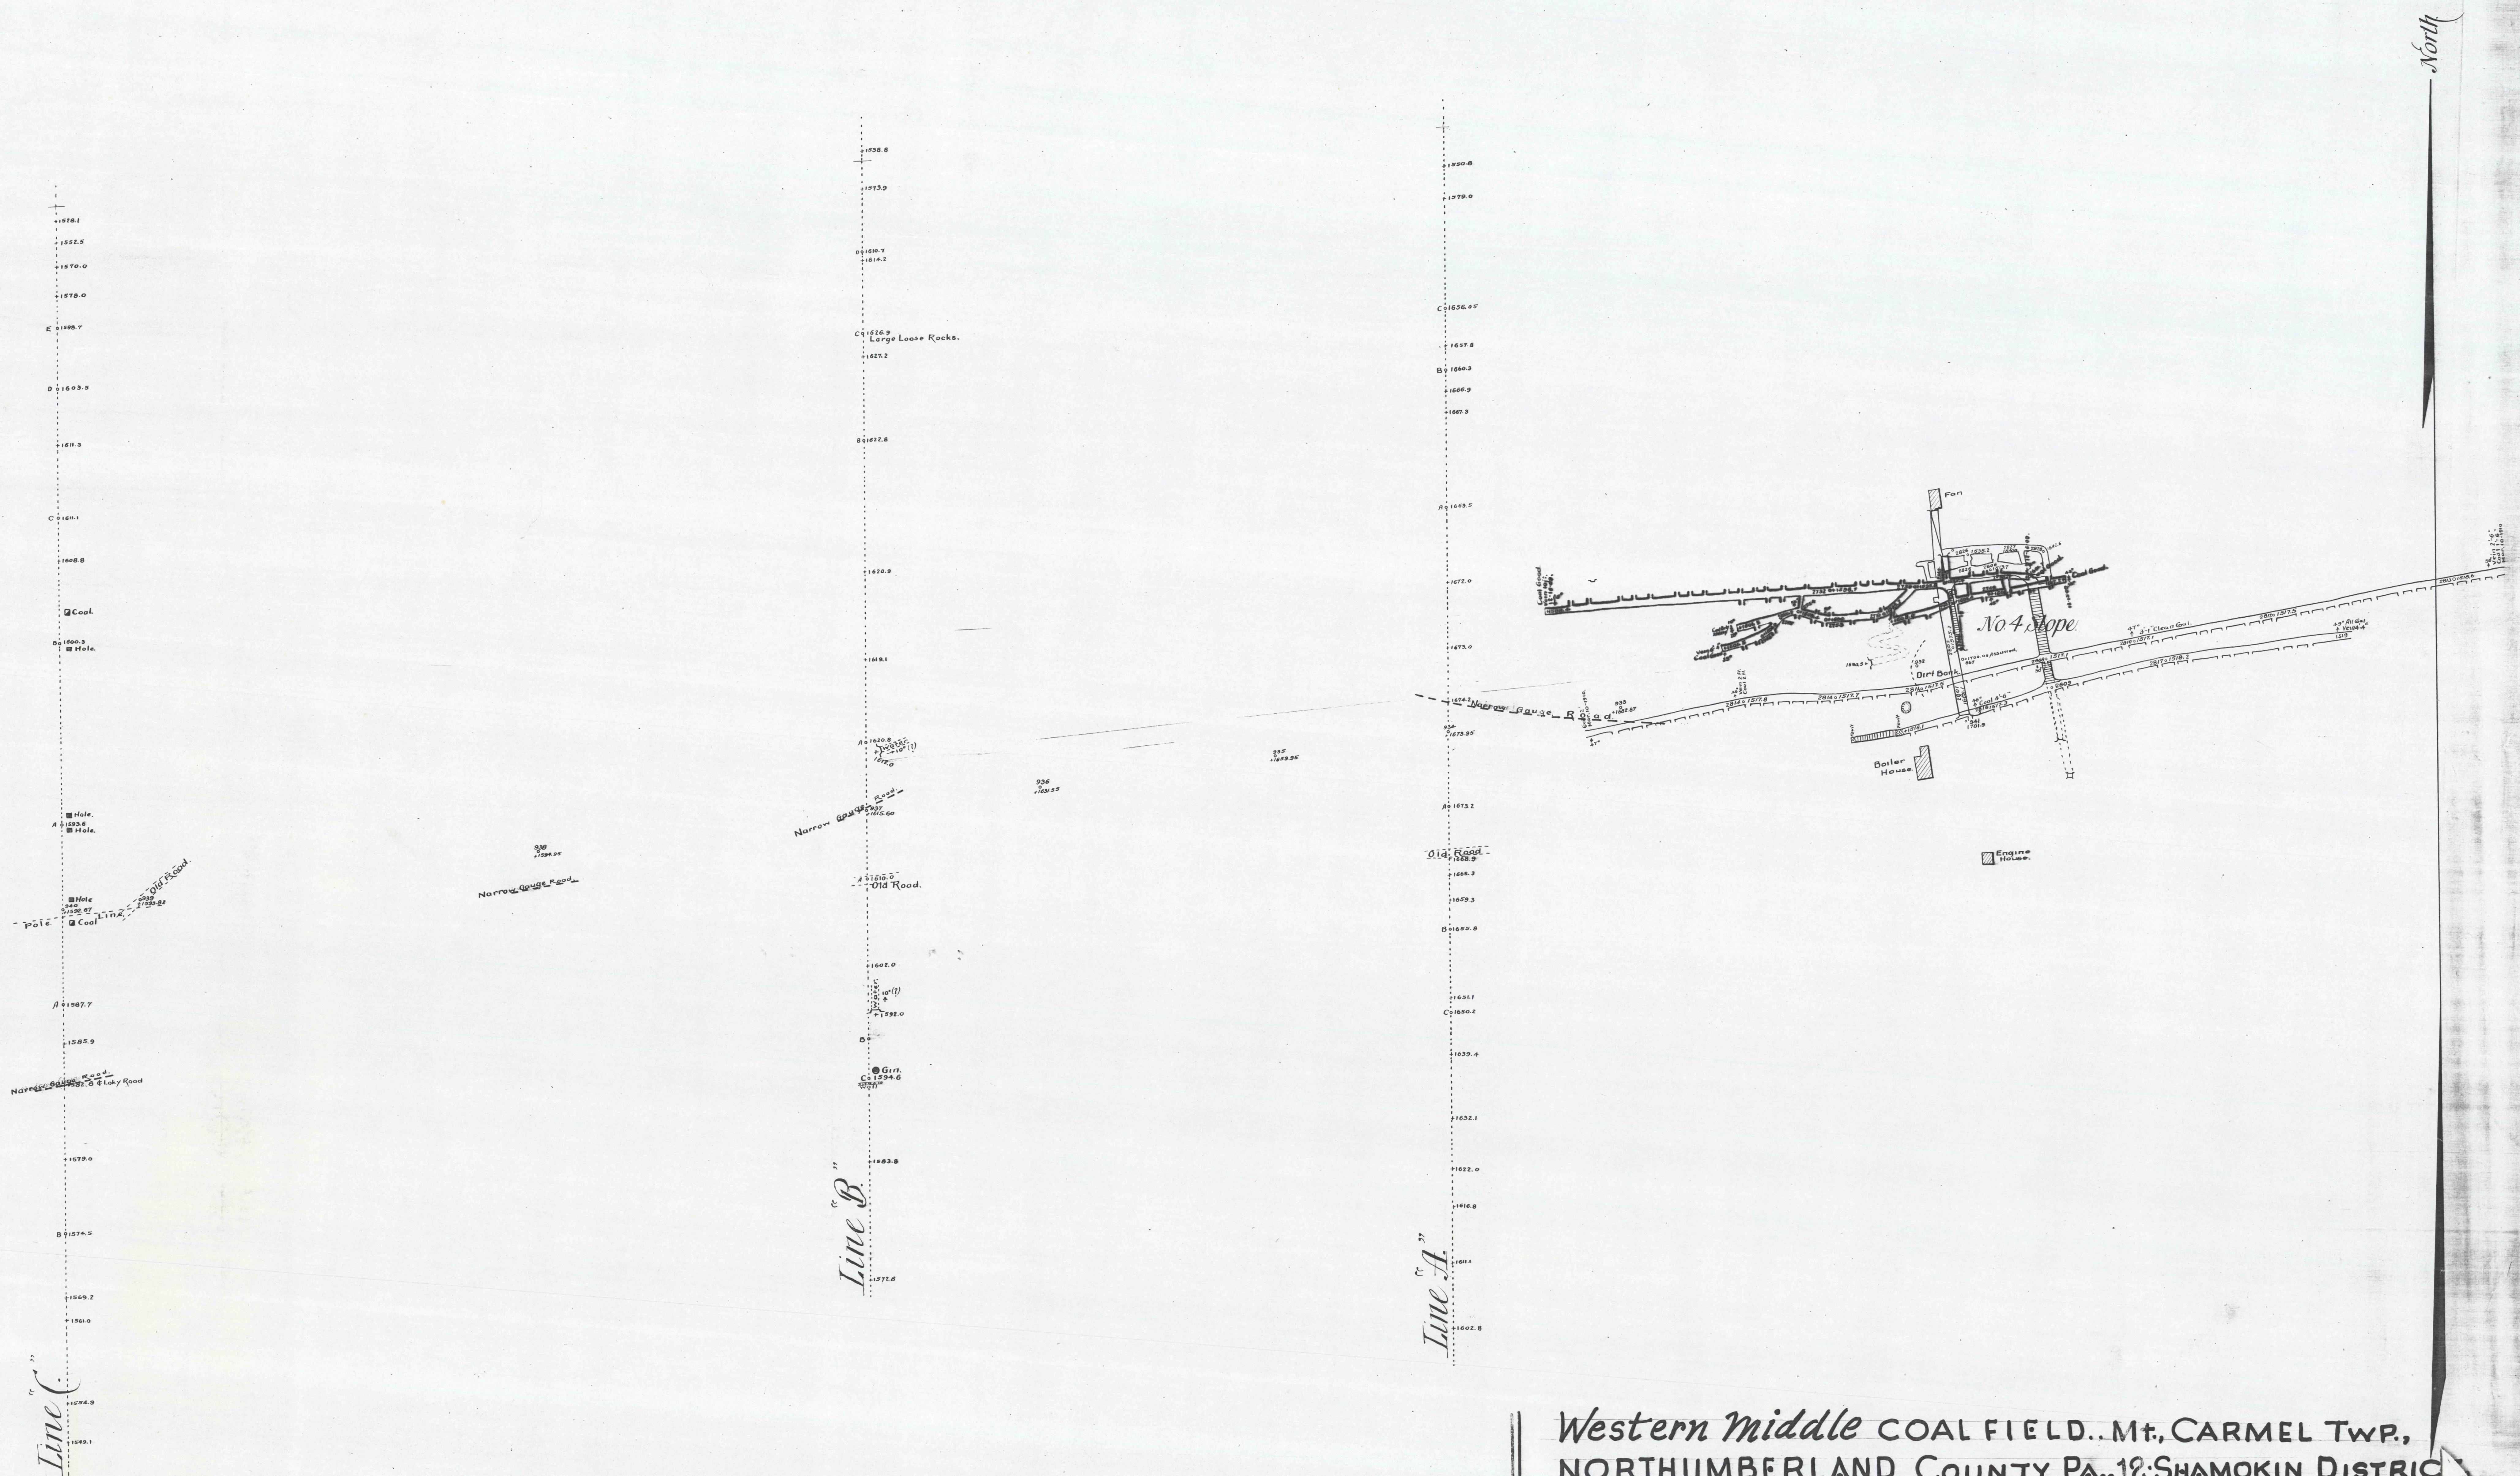

Western Middle COAL FIELD..MT. CARMEL TWP.,
NORTHUMBERLAND COUNTY PA., 12 SHAMOKIN DISTRICT
Natalie Colliery - (Colonial Collieries Company - Operators.
Map showing the mine workings from No. 4 Slope and the relative
position of Section Lines-A-B and C.
•Scale: 1 inch = 100 feet. ~ January, 1910 ~ William S. Pugh,
Mining Engr., Pottsville

2540