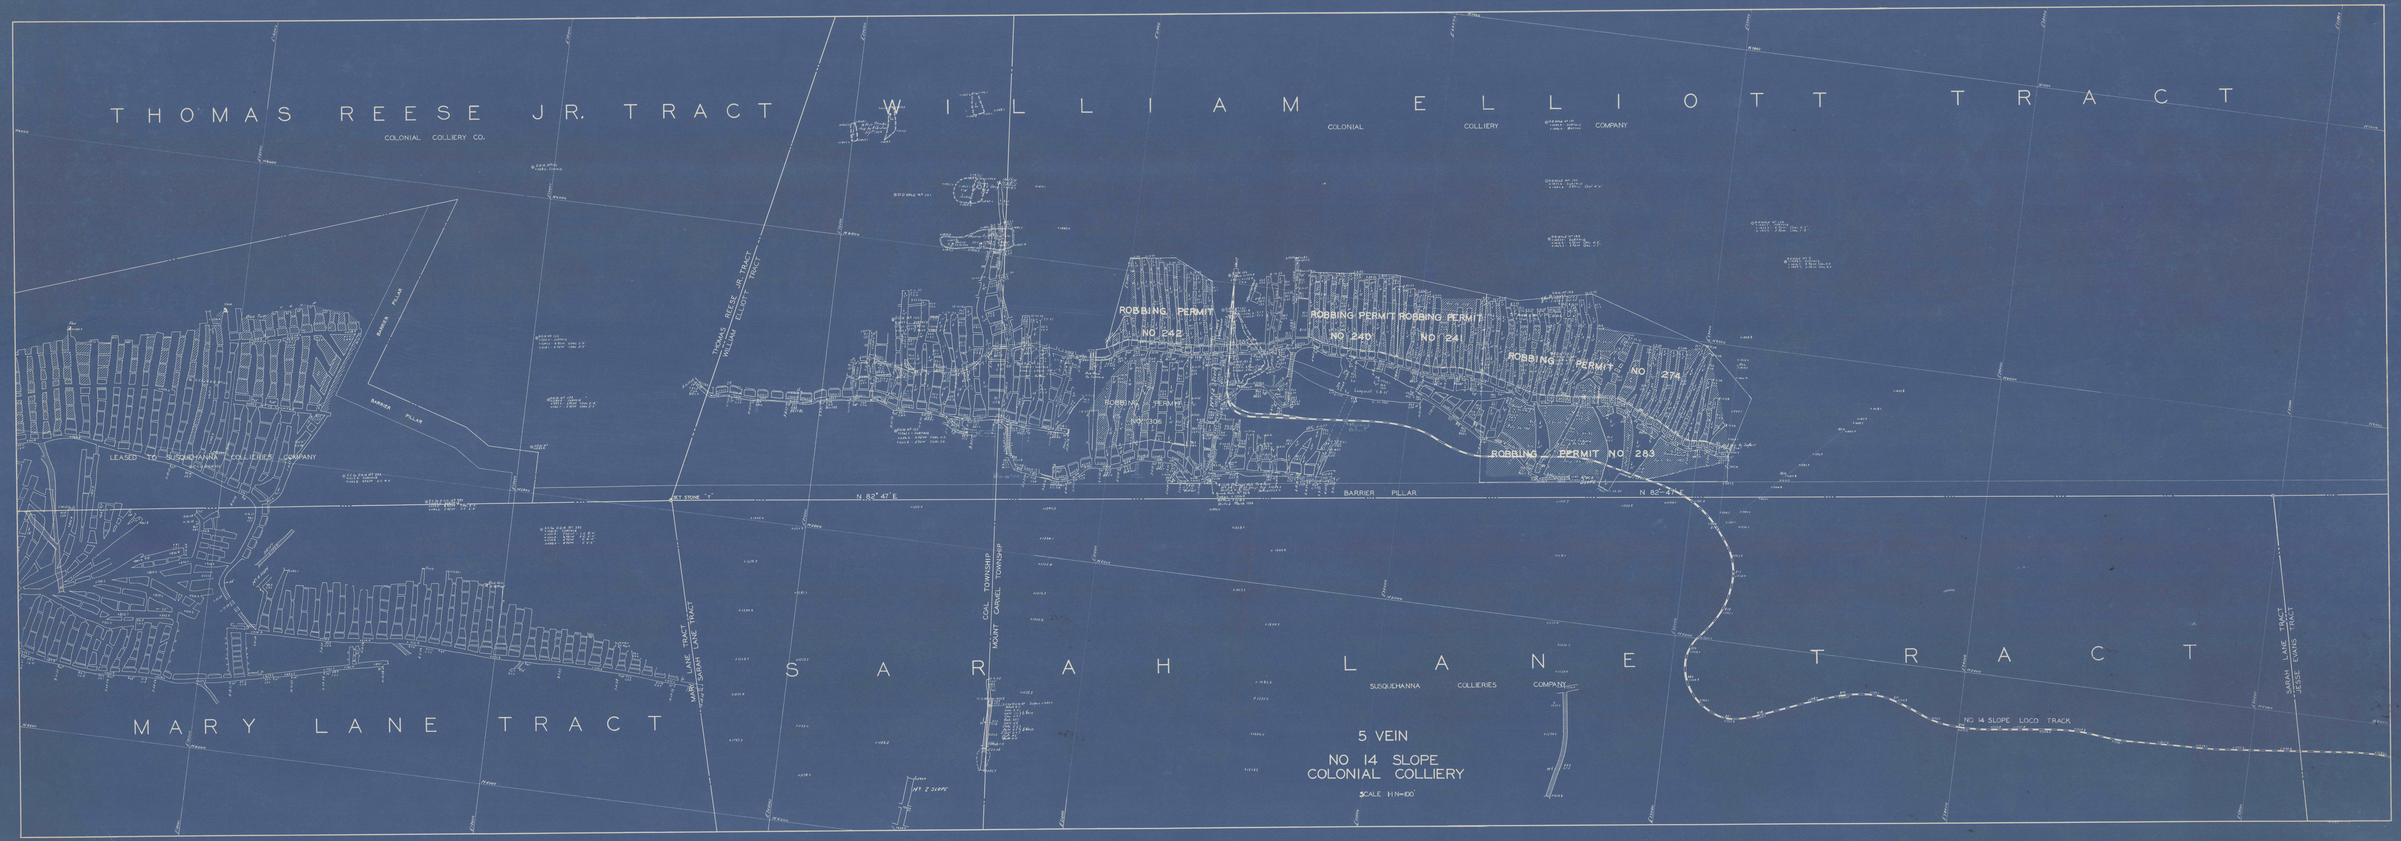

THOMAS REESE JR. TRACT
COLONIAL COLLIERY CO.
WILLIAM ELLIOTT TRACT
COLONIAL COLLIERY COMPANY
THOMAS REESE JR. TRACT
WILLIAM ELLIOTT TRACT
ROBBING PERMIT NO 242
ROBBING PERMIT NO 240
ROBBING PERMIT NO 241
ROBBING PERMIT NO 274
ROBBING PERMIT NO 283
BARRIER PILLAR
BARRIER PILLAR
LEASED TO SUSQUEHANNA COLLIERIES COMPANY
N 82° 47' E
N 82° 47' E
BARRIER PILLAR
MARY LANE TRACT
SARAH LANE TRACT
COAL TOWNSHIP
MOUNT CARMEL TOWNSHIP
MARY LANE TRACT
SARAH LANE TRACT
SUSQUEHANNA COLLIERIES COMPANY
SARAH LANE TRACT
JESSE EVANS TRACT
NO 14 SLOPE LOCO TRACK
No 2 SLOPE
5 VEIN
NO 14 SLOPE
COLONIAL COLLIERY
SCALE 1 IN = 100'