


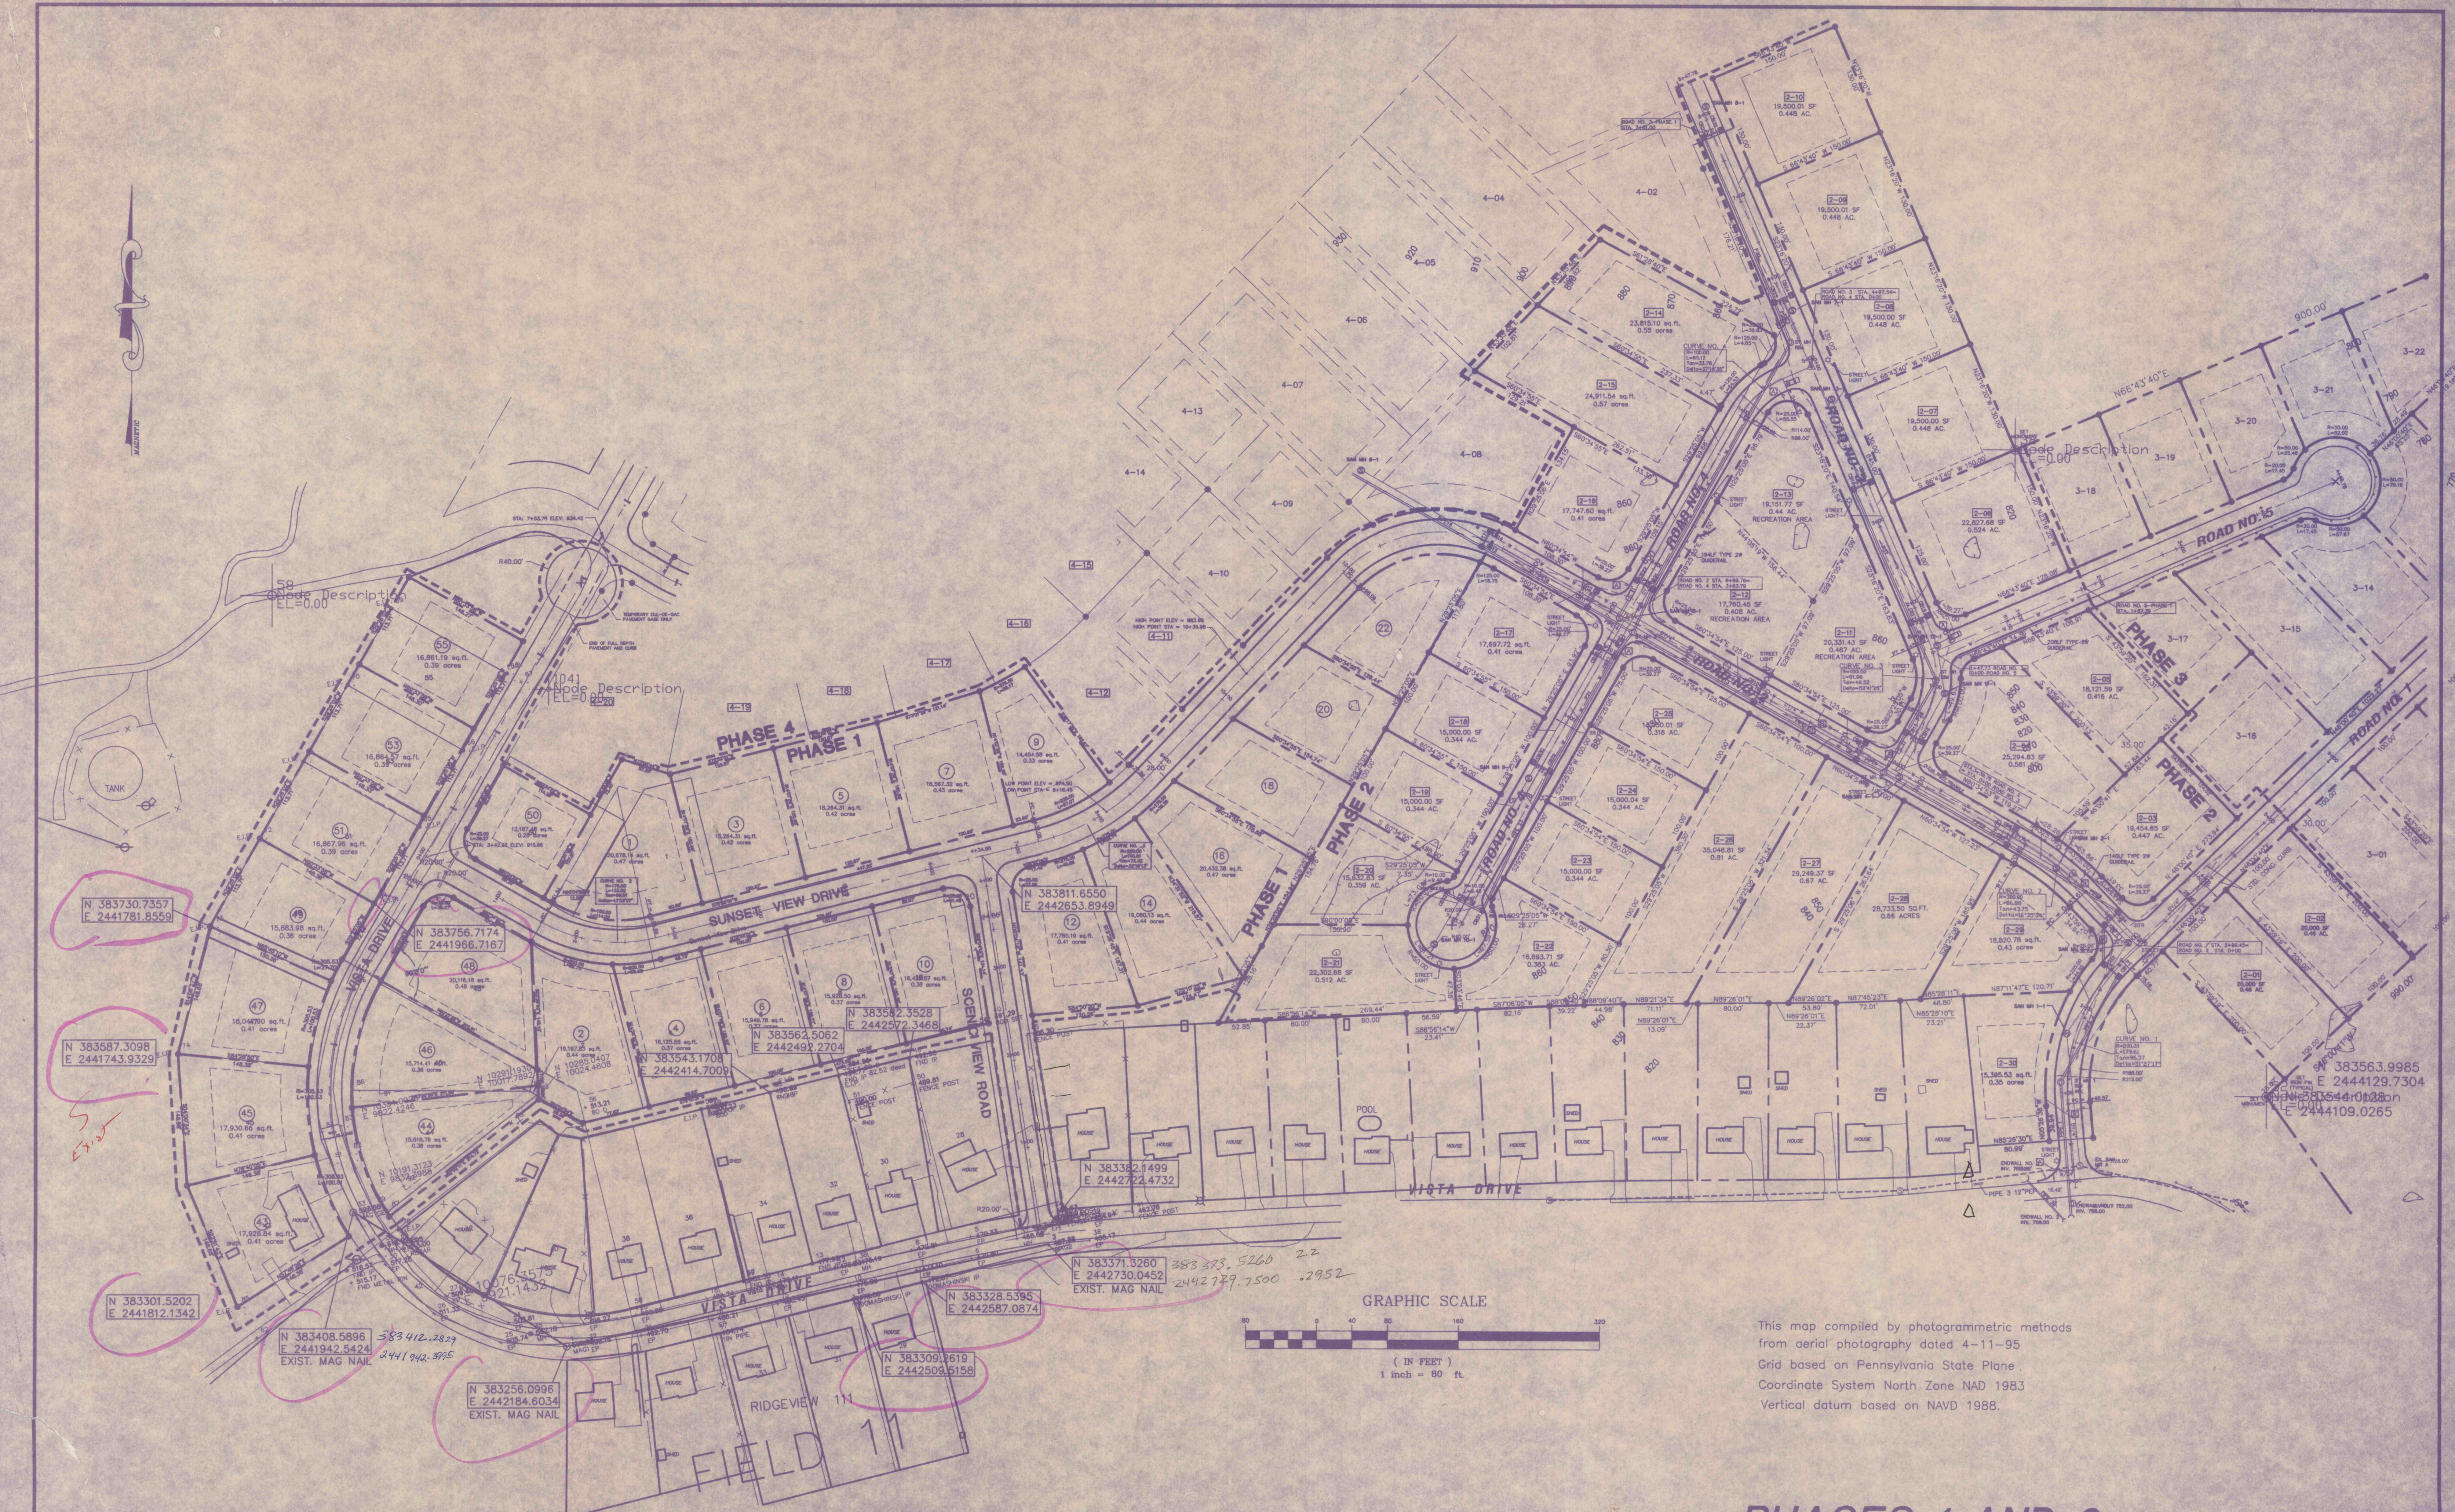

# PHASES 1 AND 2 SITE PLAN

**MICHAEL J. PASONICK, JR., INC.**  
CONSULTING ENGINEERS AND SURVEYORS  
165 NORTH WILKES-BARRE BOULEVARD  
WILKES-BARRE, PENNSYLVANIA 18702  
PHONE: (570) 823-4710 FAX: (570) 823-4727

REVISIONS  
**WHITNEY POINT SUBDIVISION**  
NEWPORT TOWNSHIP, LUZERNE COUNTY, PENNSYLVANIA

|                      |                |            |             |
|----------------------|----------------|------------|-------------|
| DRAWN BY<br>T. JOHNS | DATE           | JOB NO.    | SHEET NO.   |
| CHECKED BY           | SCALE<br>NOTED | SURVEY NO. | <b>S1-2</b> |

This map compiled by photogrammetric methods  
from aerial photography dated 4-11-95  
Grid based on Pennsylvania State Plane  
Coordinate System North Zone NAD 1983  
Vertical datum based on NAVD 1988.