


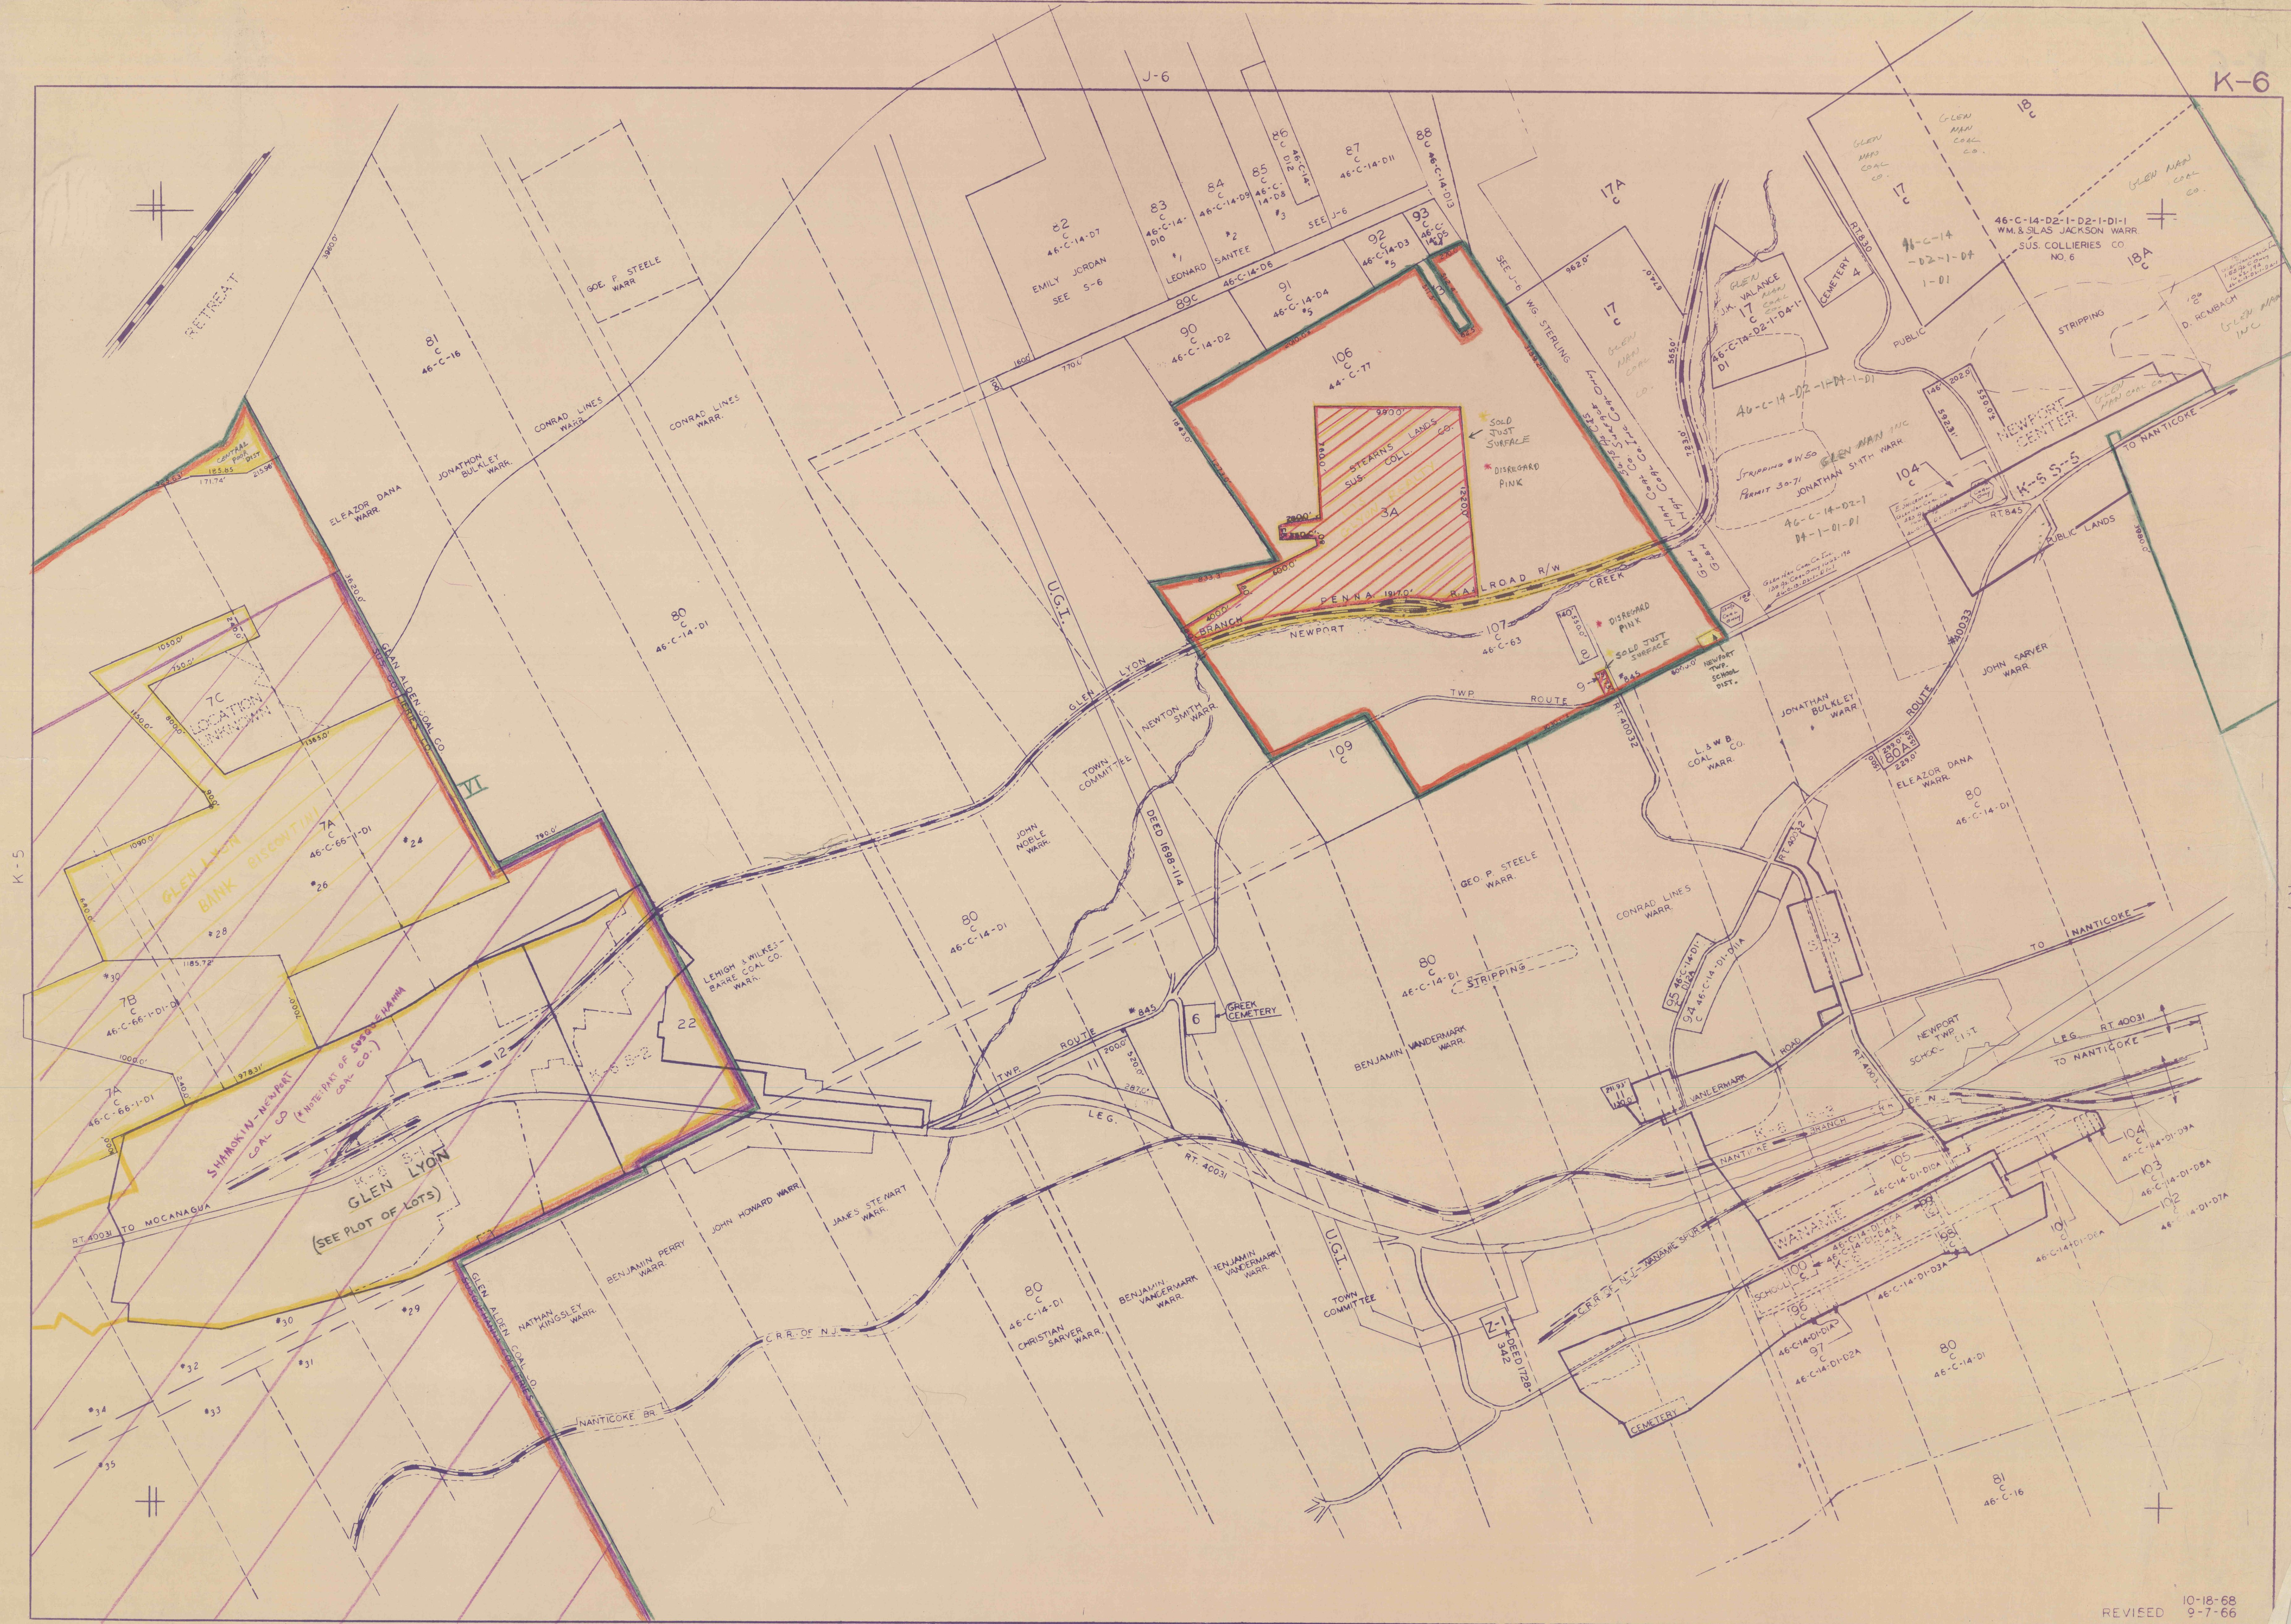

THIS MAP PREPARED FOR ASSESSMENT PURPOSES ONLY, AND IS NOT DESIGNED TO PROVIDE ENGINEERING DATA.

L-6

YELLOW - SOLD SURFACE  
PURPLE - SOLD COAL

GREEN - SURFACE  
RED - COAL  
PINK - SOLD SURFACE AND COAL

10-18-68  
9-7-66  
REVISED  
GLEN LYON, NEWPORT TWP, WANAMIE  
LUZERNE COUNTY, PENNA.  
ASSESSMENT EQUALIZATION PROJECT  
SCALE: 1" = 400' MAP No. K-6