



LEGEND

- SURFACE CHANNEL
 - PIPE UNDERDRAIN
 - I+1270 INVERT ELEVATION
 - 1300 FINAL GRADE (REVISED PHASE II-A)
 - 1300 APPROVED FINAL GRADE
- SEE SHEET 4 FOR ADDED NOTES.

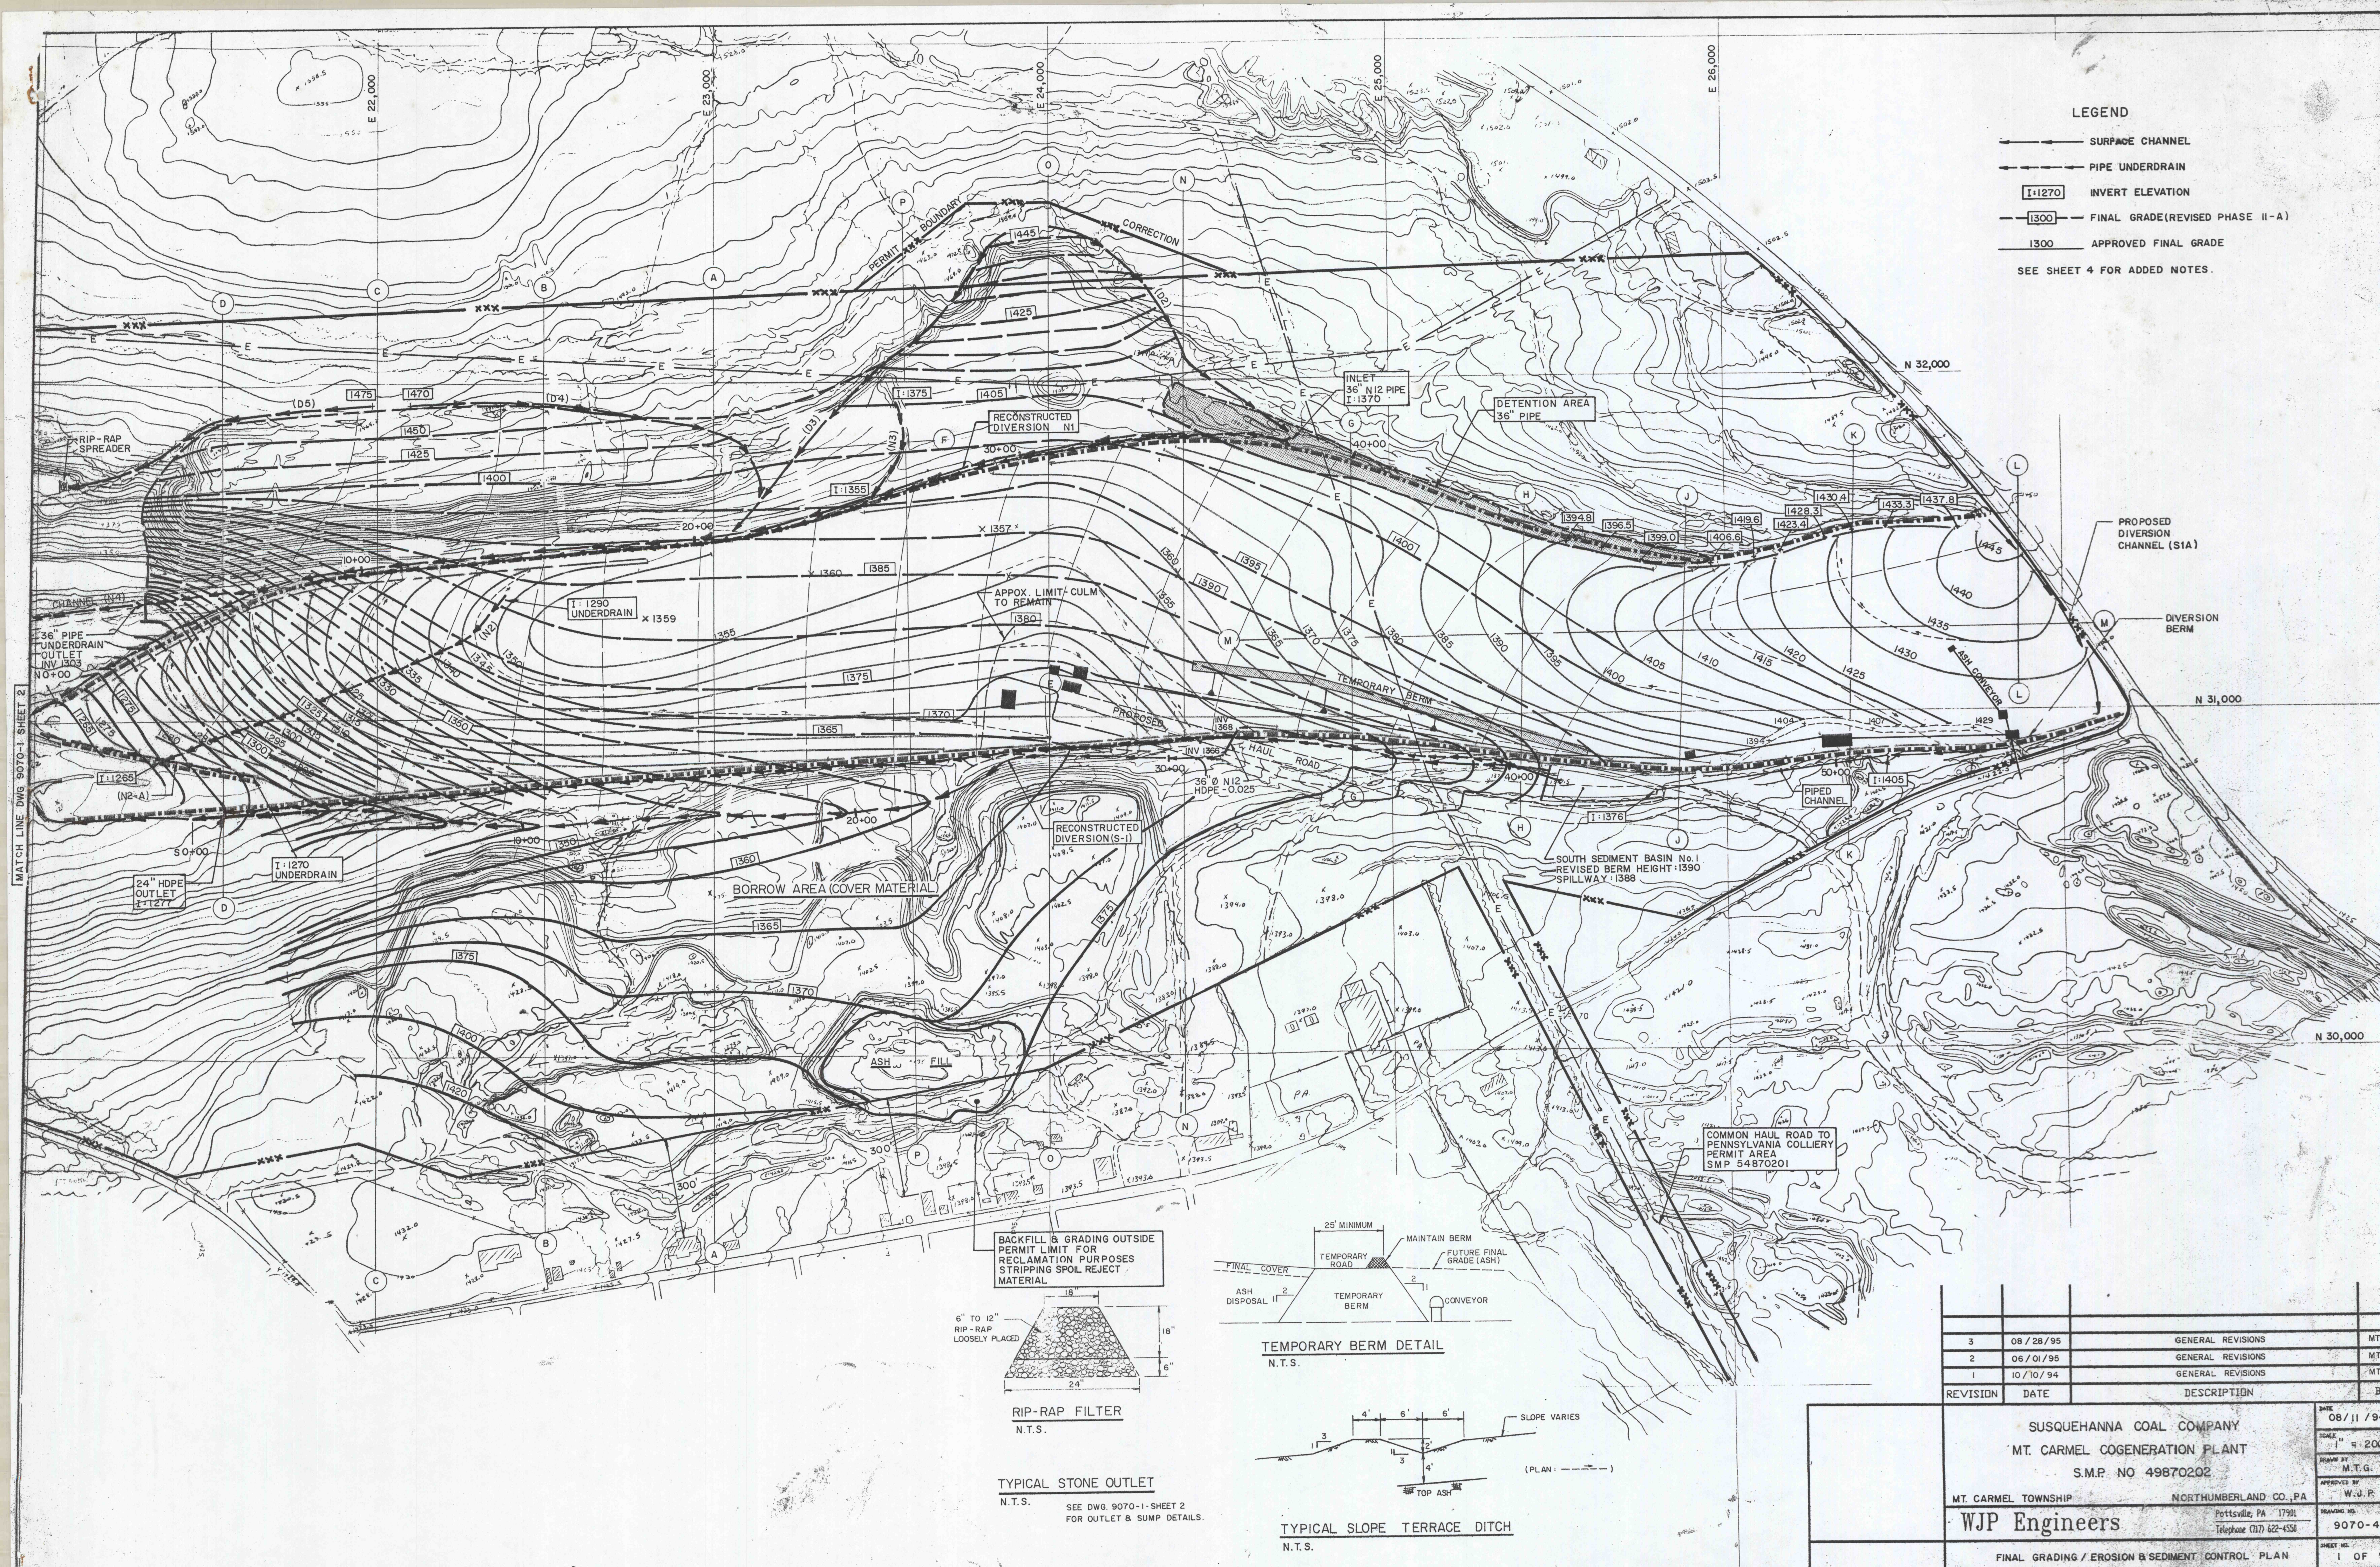

REVISION	DATE	DESCRIPTION	BY
3	08/28/95	GENERAL REVISIONS	MTG
2	06/01/95	GENERAL REVISIONS	MTG
1	10/10/94	GENERAL REVISIONS	MTG

SUSQUEHANNA COAL COMPANY		DATE	08/11/94
MT. CARMEL COGENERATION PLANT		SCALE	1" = 200'
S.M.P. NO 49870202		DRAWN BY	M.T.G.
MT. CARMEL TOWNSHIP		APPROVED BY	W.J.P.
NORTHUMBERLAND CO., PA		DRAWING NO.	9070-4
Pottsville, PA 17901		SHEET NO.	1 OF 9
Telephone (717) 622-4558			
WJP Engineers			
FINAL GRADING / EROSION & SEDIMENT CONTROL PLAN			

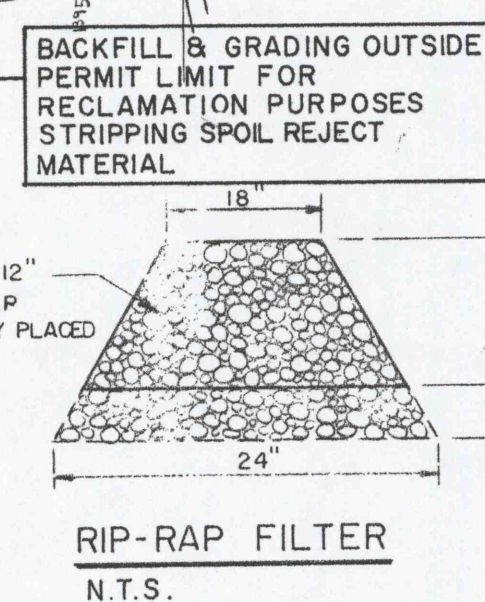

SEE DWG. 9070-1-SHEET 2
FOR OUTLET & SUMP DETAILS.

