




SECTION M-M

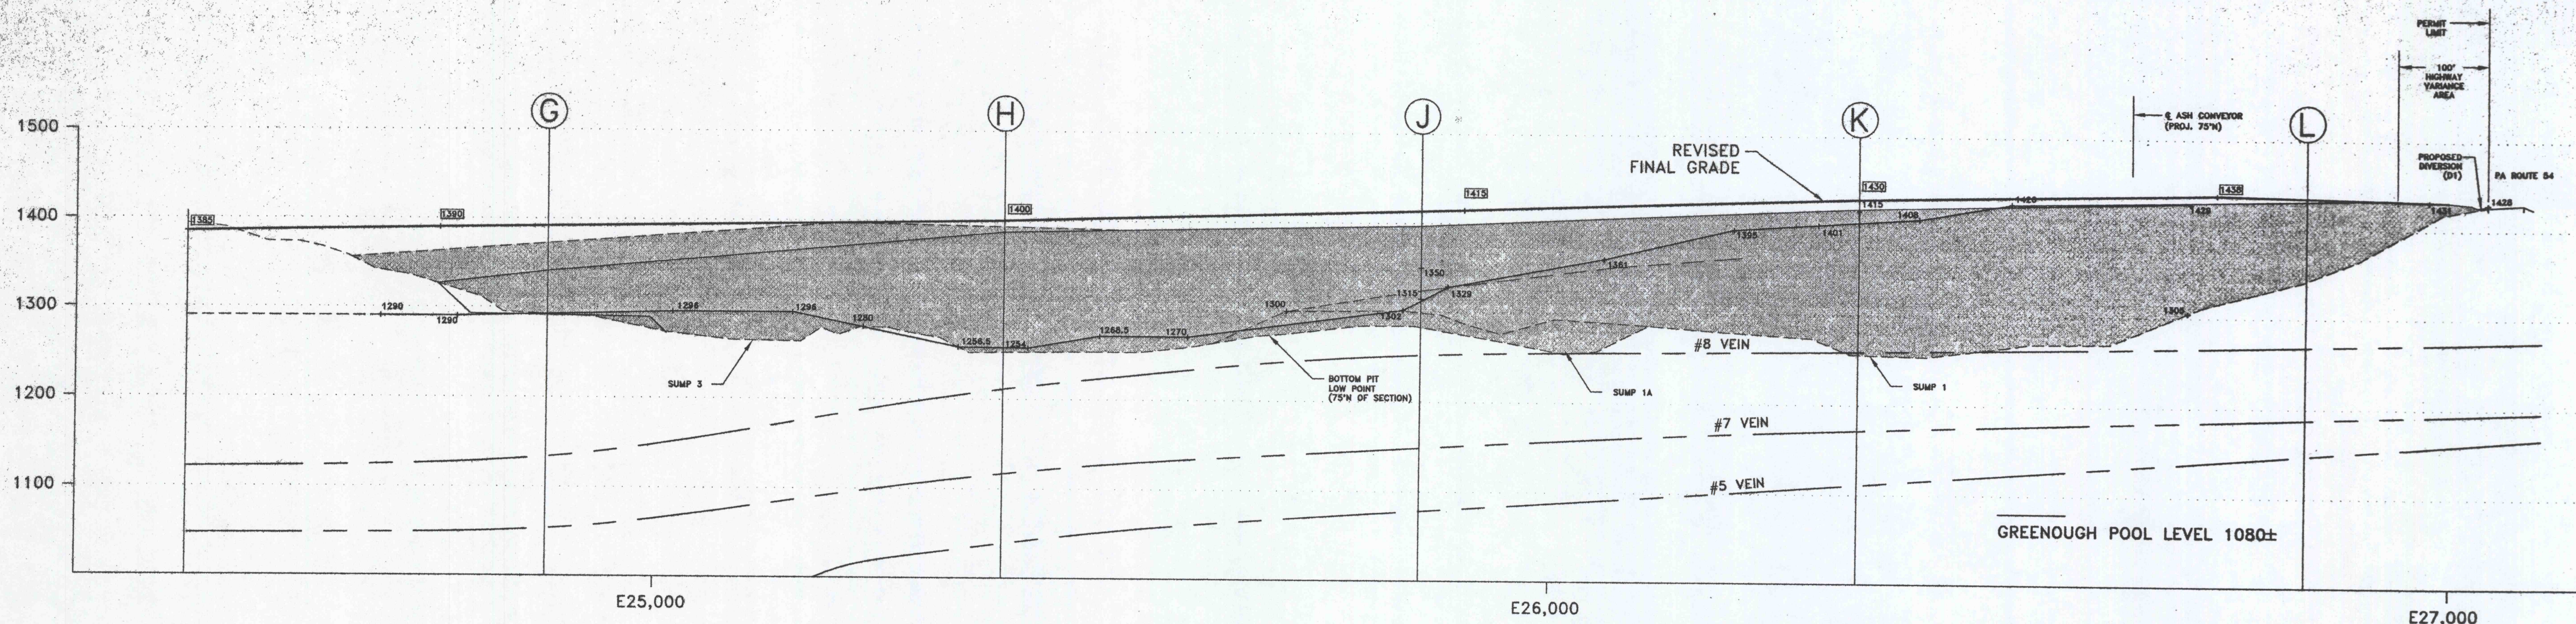

SECTION L-L

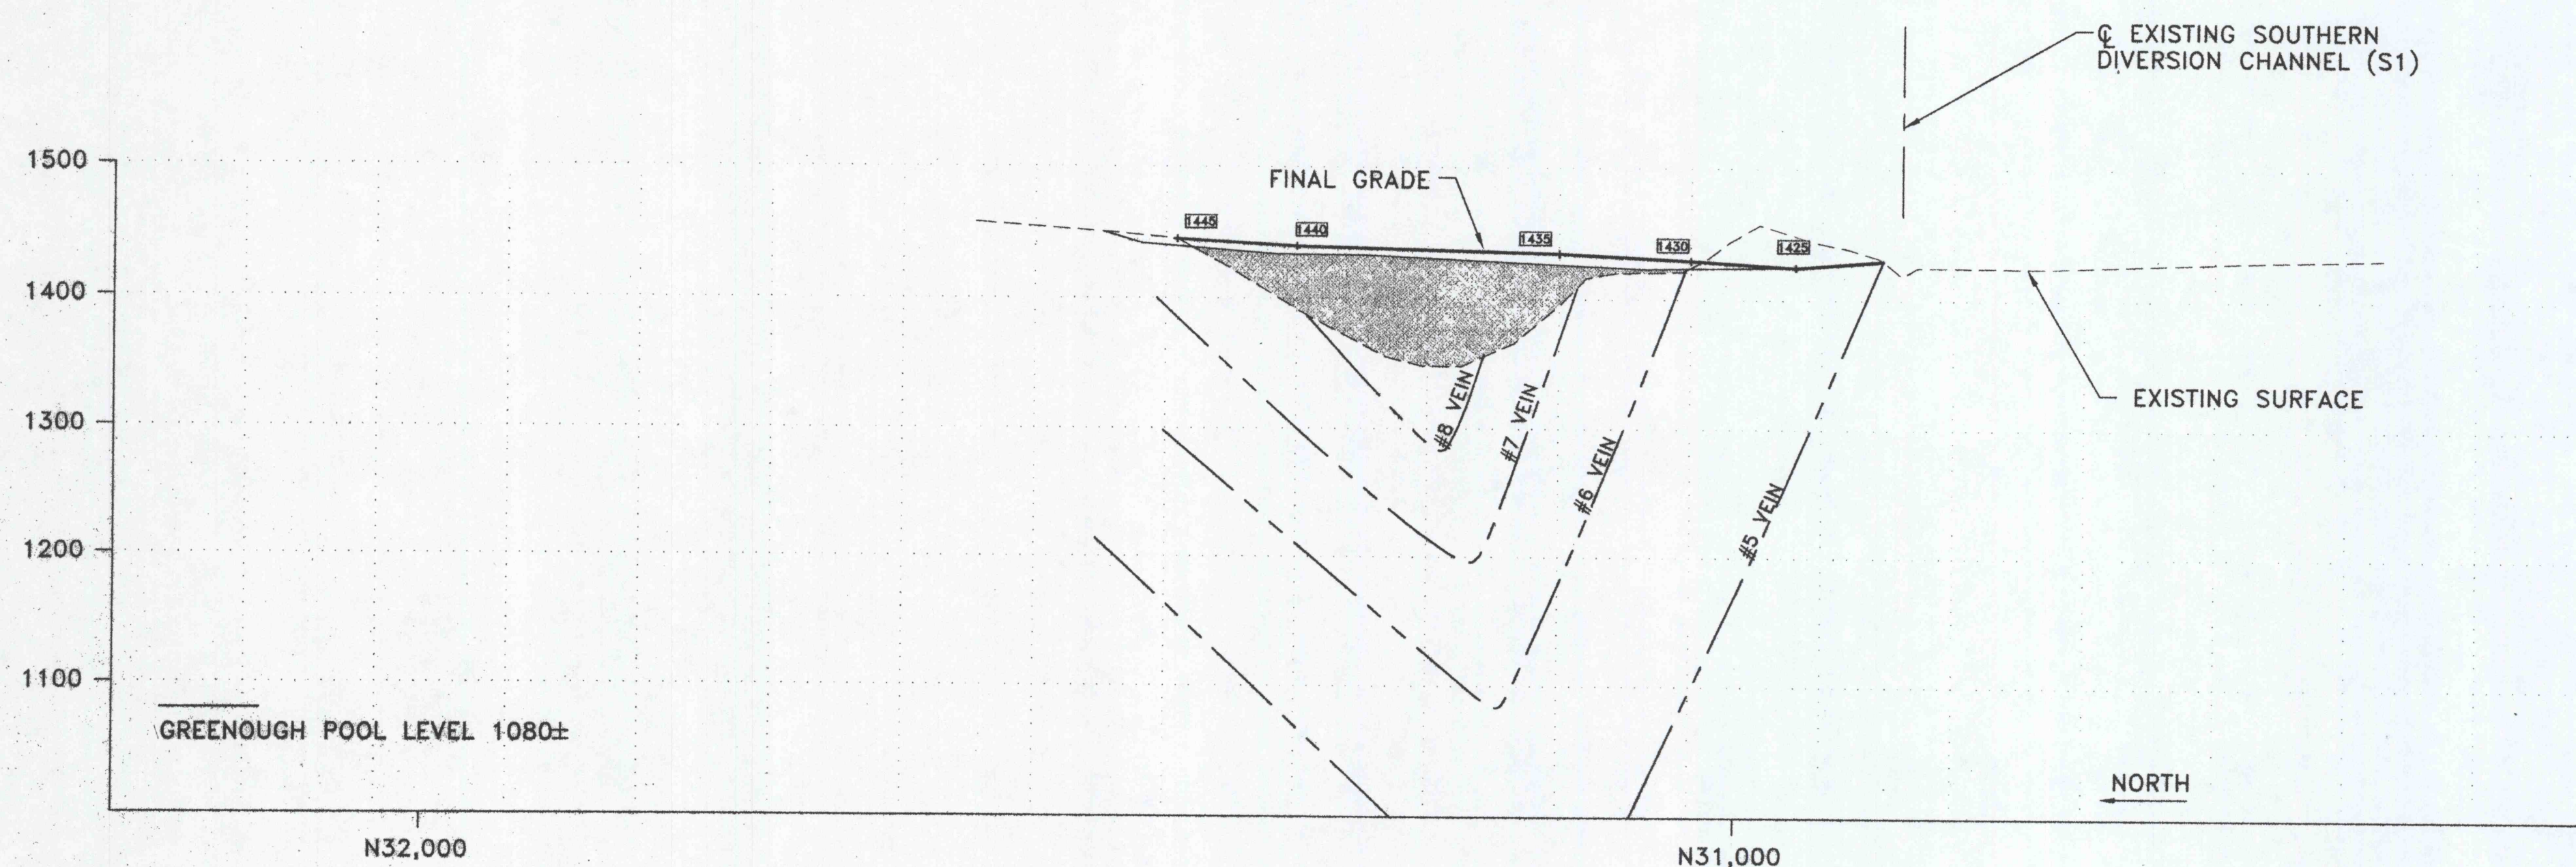

SECTION K-K

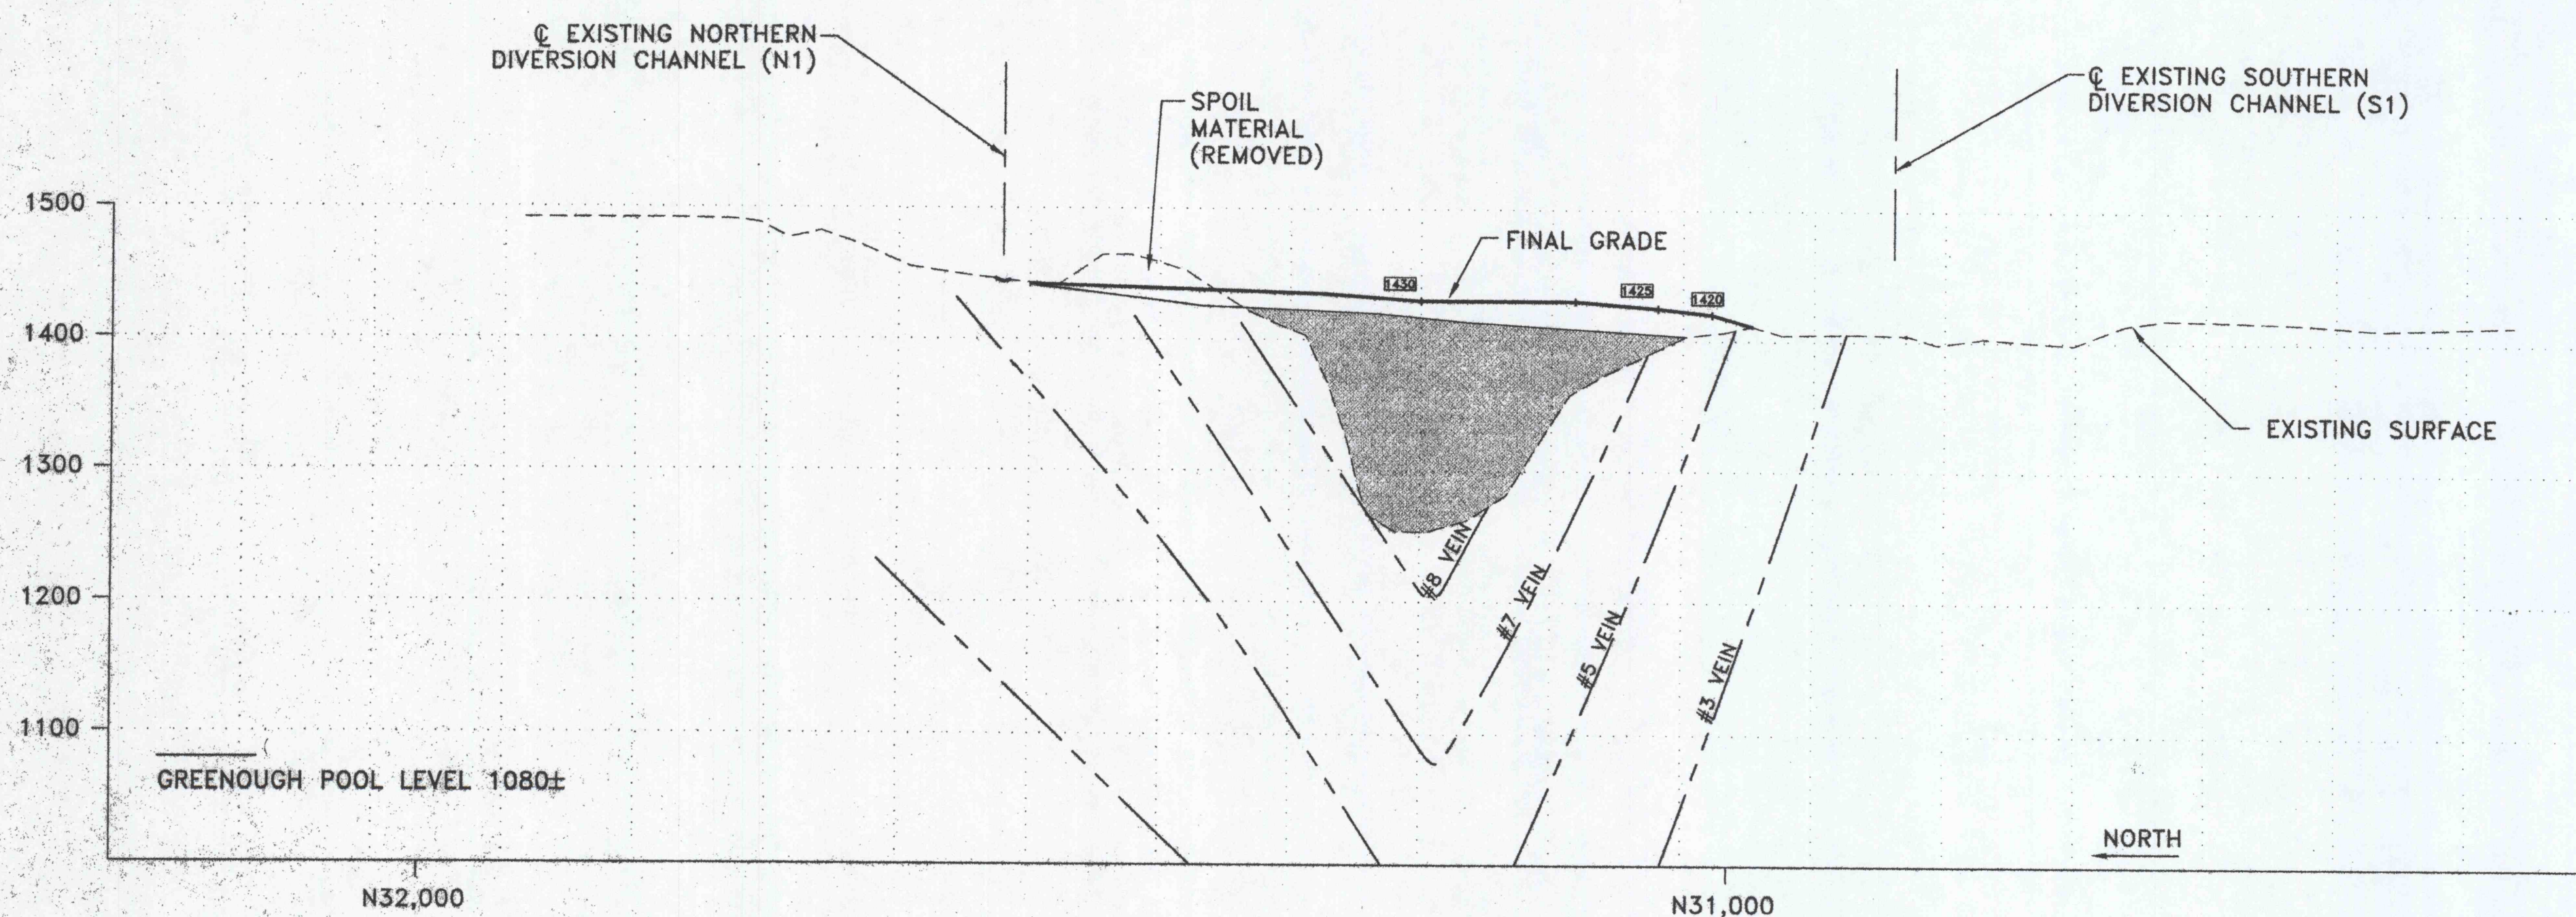

ASH AND FILL IN PLACE AS OF 2/10/95

REVISION	DATE	DESCRIPTION	MTG	BY
1	06/01/95	GENERAL REVISIONS	MTG	
SUSQUEHANNA COAL COMPANY MT. CARMEL COGENERATION PLANT SMP #49870202				DATE 10/10/94
MT. CARMEL TOWNSHIP NORTHUMBERLAND COUNTY, PA				SCALE 1" = 100'
WJP Engineers				DRAWN BY AFJ
Pottsville, PA 17901 Telephone (717) 622-4550				APPROVED BY WJP
ASH DISPOSAL CROSS SECTIONS				DRAWING NO. 9070-4
				SHEET NO. 5 OF 9