


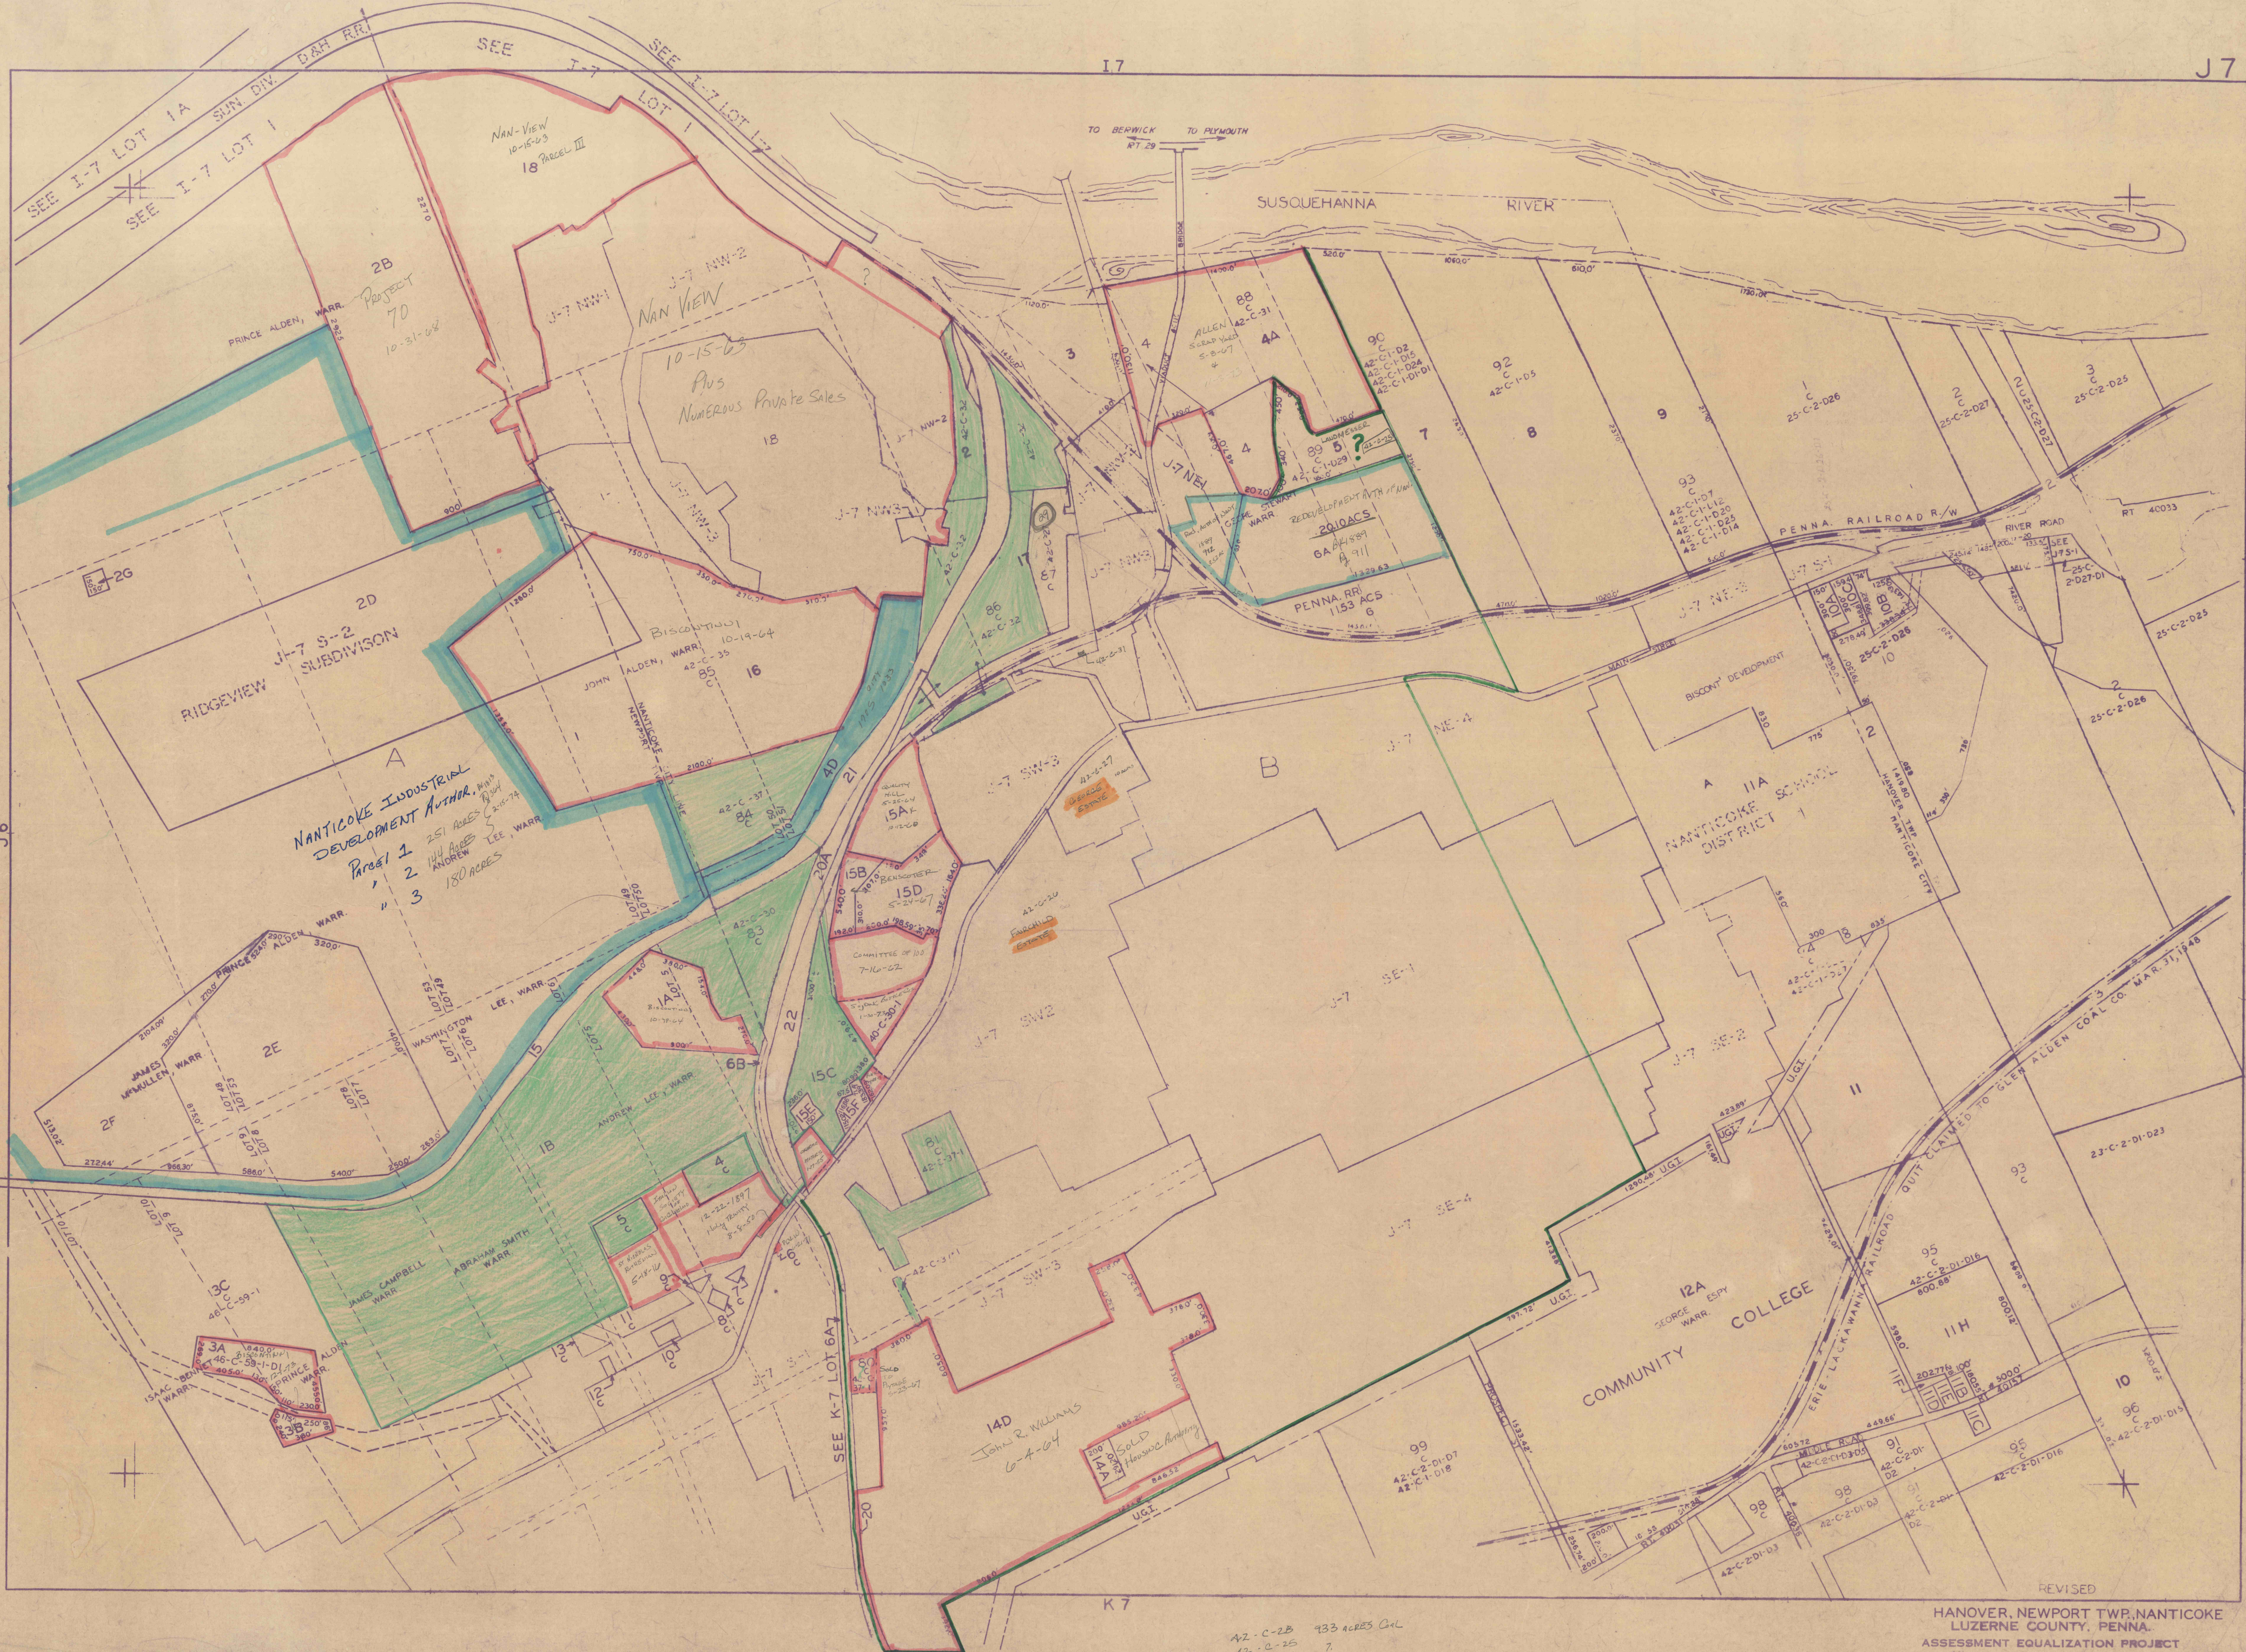

THIS MAP PREPARED FOR ASSESSMENT PURPOSES ONLY, AND IS NOT DESIGNED TO PROVIDE ENGINEERING DATA.

REVISED
HANOVER, NEWPORT TWP., NANTICOKE
LUZERNE COUNTY, PENNA.
ASSESSMENT EQUALIZATION PROJECT
SCALE 1"=400' MAP No. J 7