


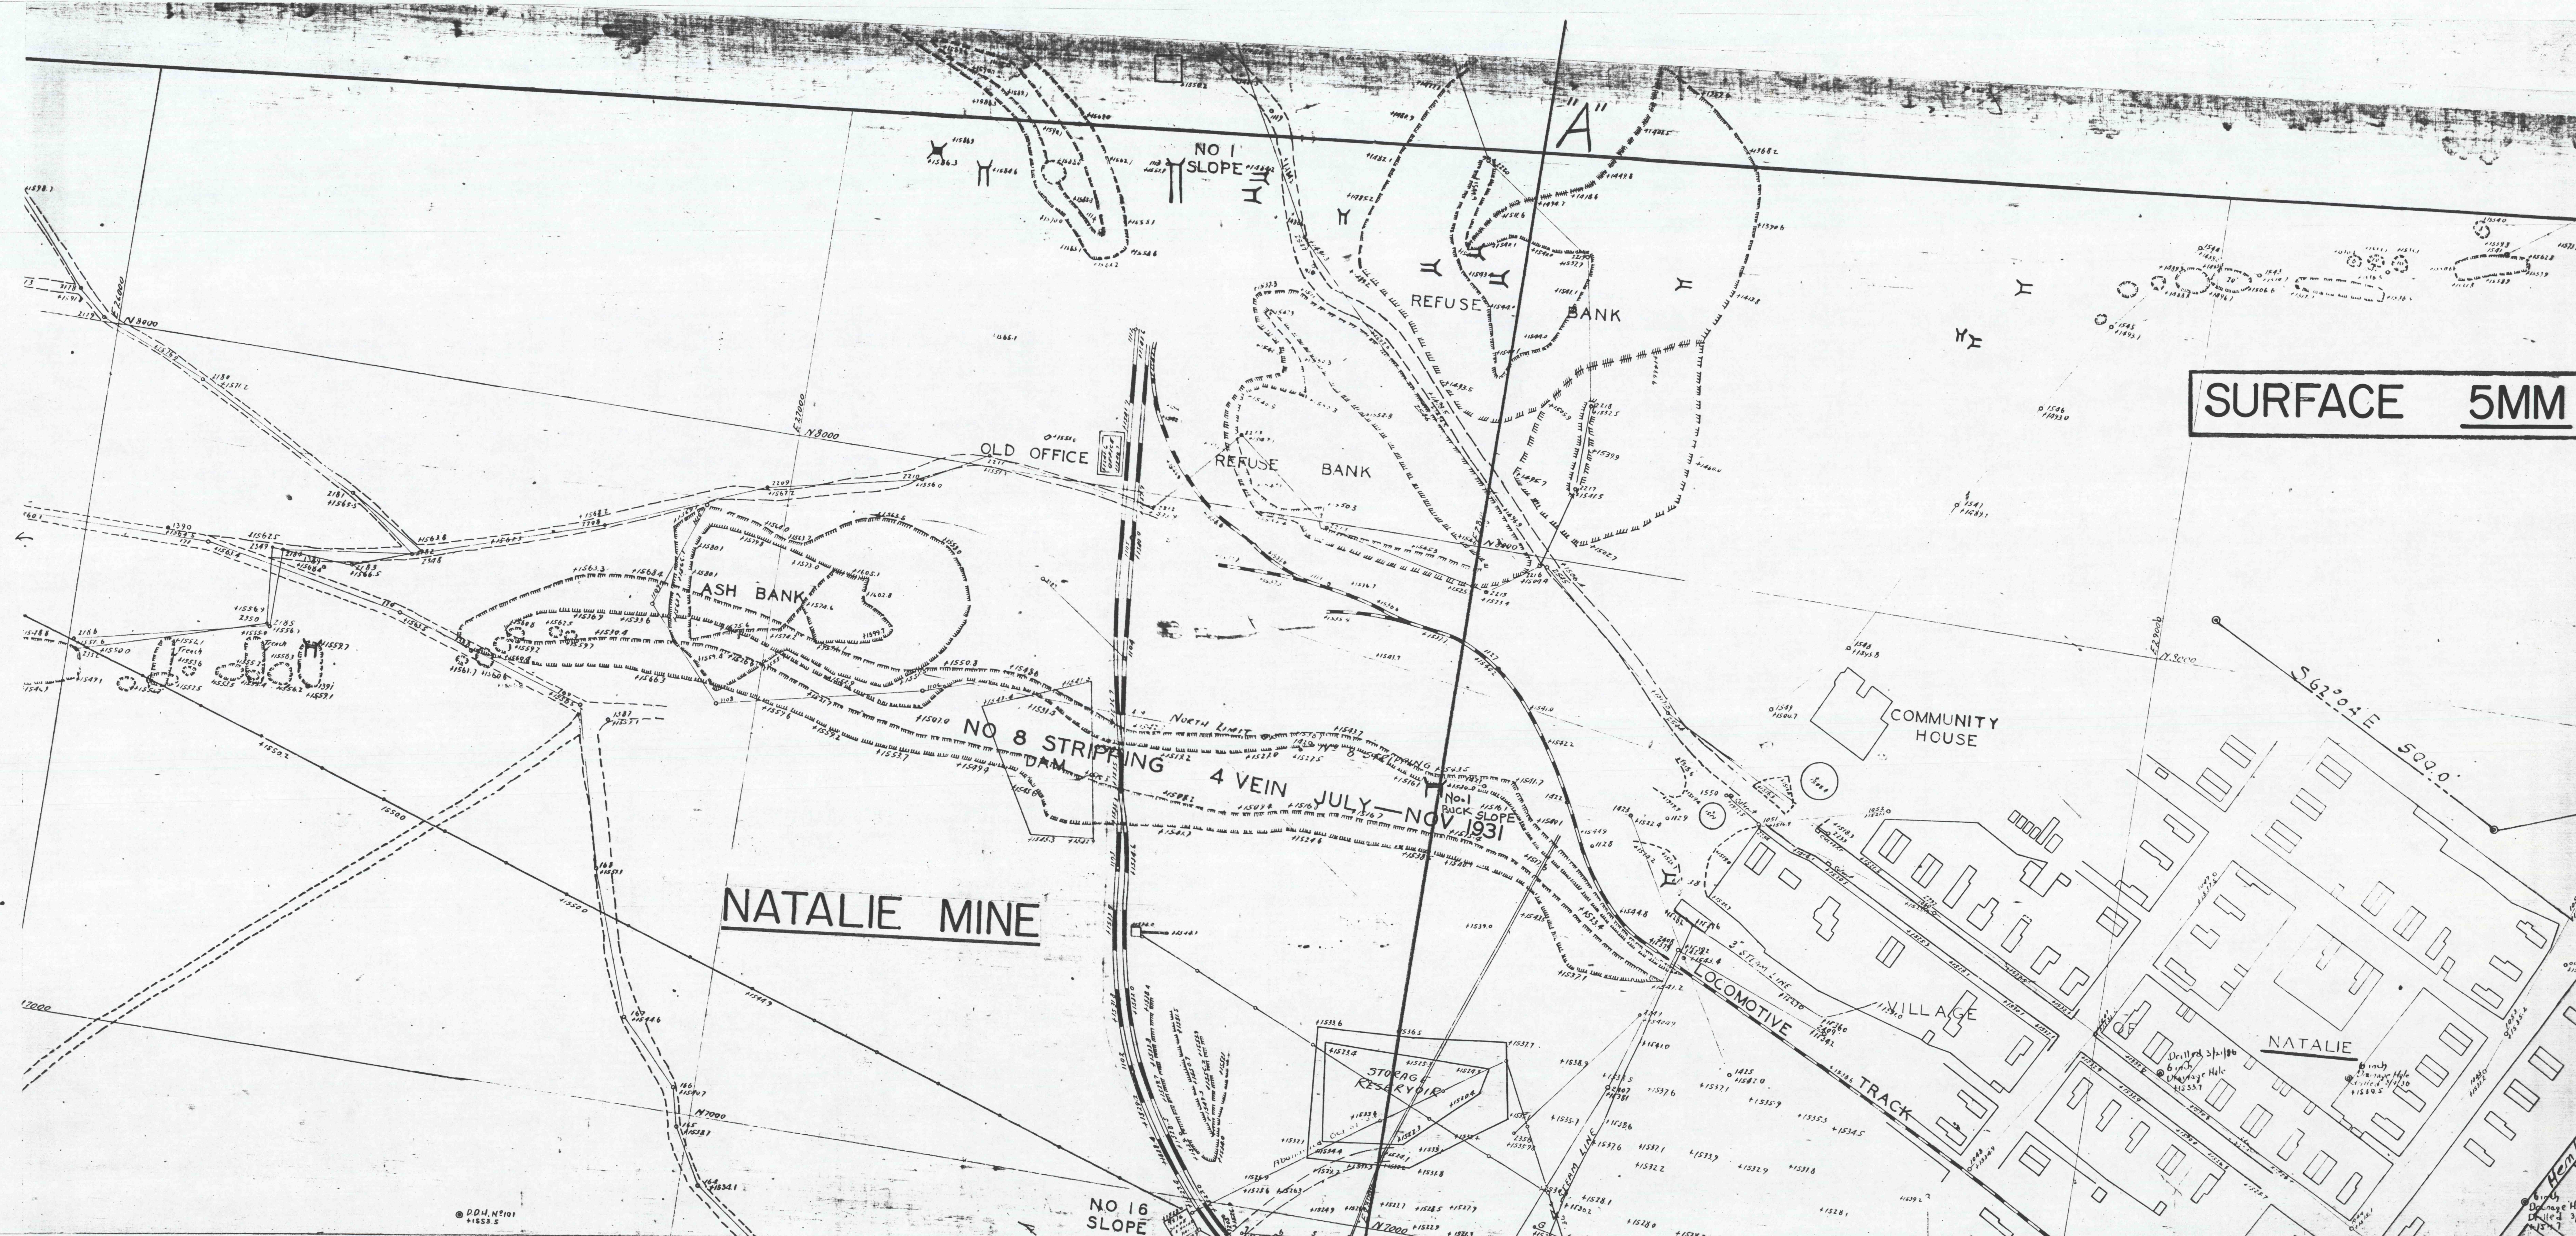

SURFACE 5MM

NATALIE MINE

NO 16 SLOPE

JULY - NOV 1931
NO 1 RUCK SLOPE

COMMUNITY HOUSE

NATALIE

LOCOMOTIVE

STORAGE RESERVOIR

OLD OFFICE

REFUSE BANK

REFUSE BANK

FLASH BANK

NO 8 STRIPPING DAM

NATALIE TRACK