


NO. 4 VEIN
(Repetition)

5MM

"A"

PATTERSON COLLIERY

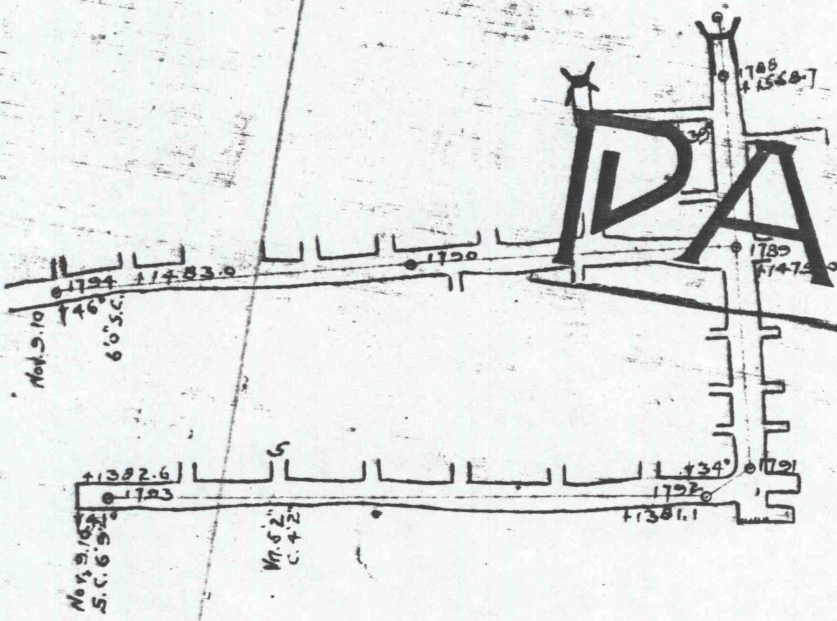

27,000

Powder House

Boiler House

JUNE 7 1894

Breaker

No. 1 Slope Engine House

Carpenr Shop

Supply House

Machine Shop

No. 1 Lloyd Slope

Store

Saw Mill

Stable

Blacksmith

