


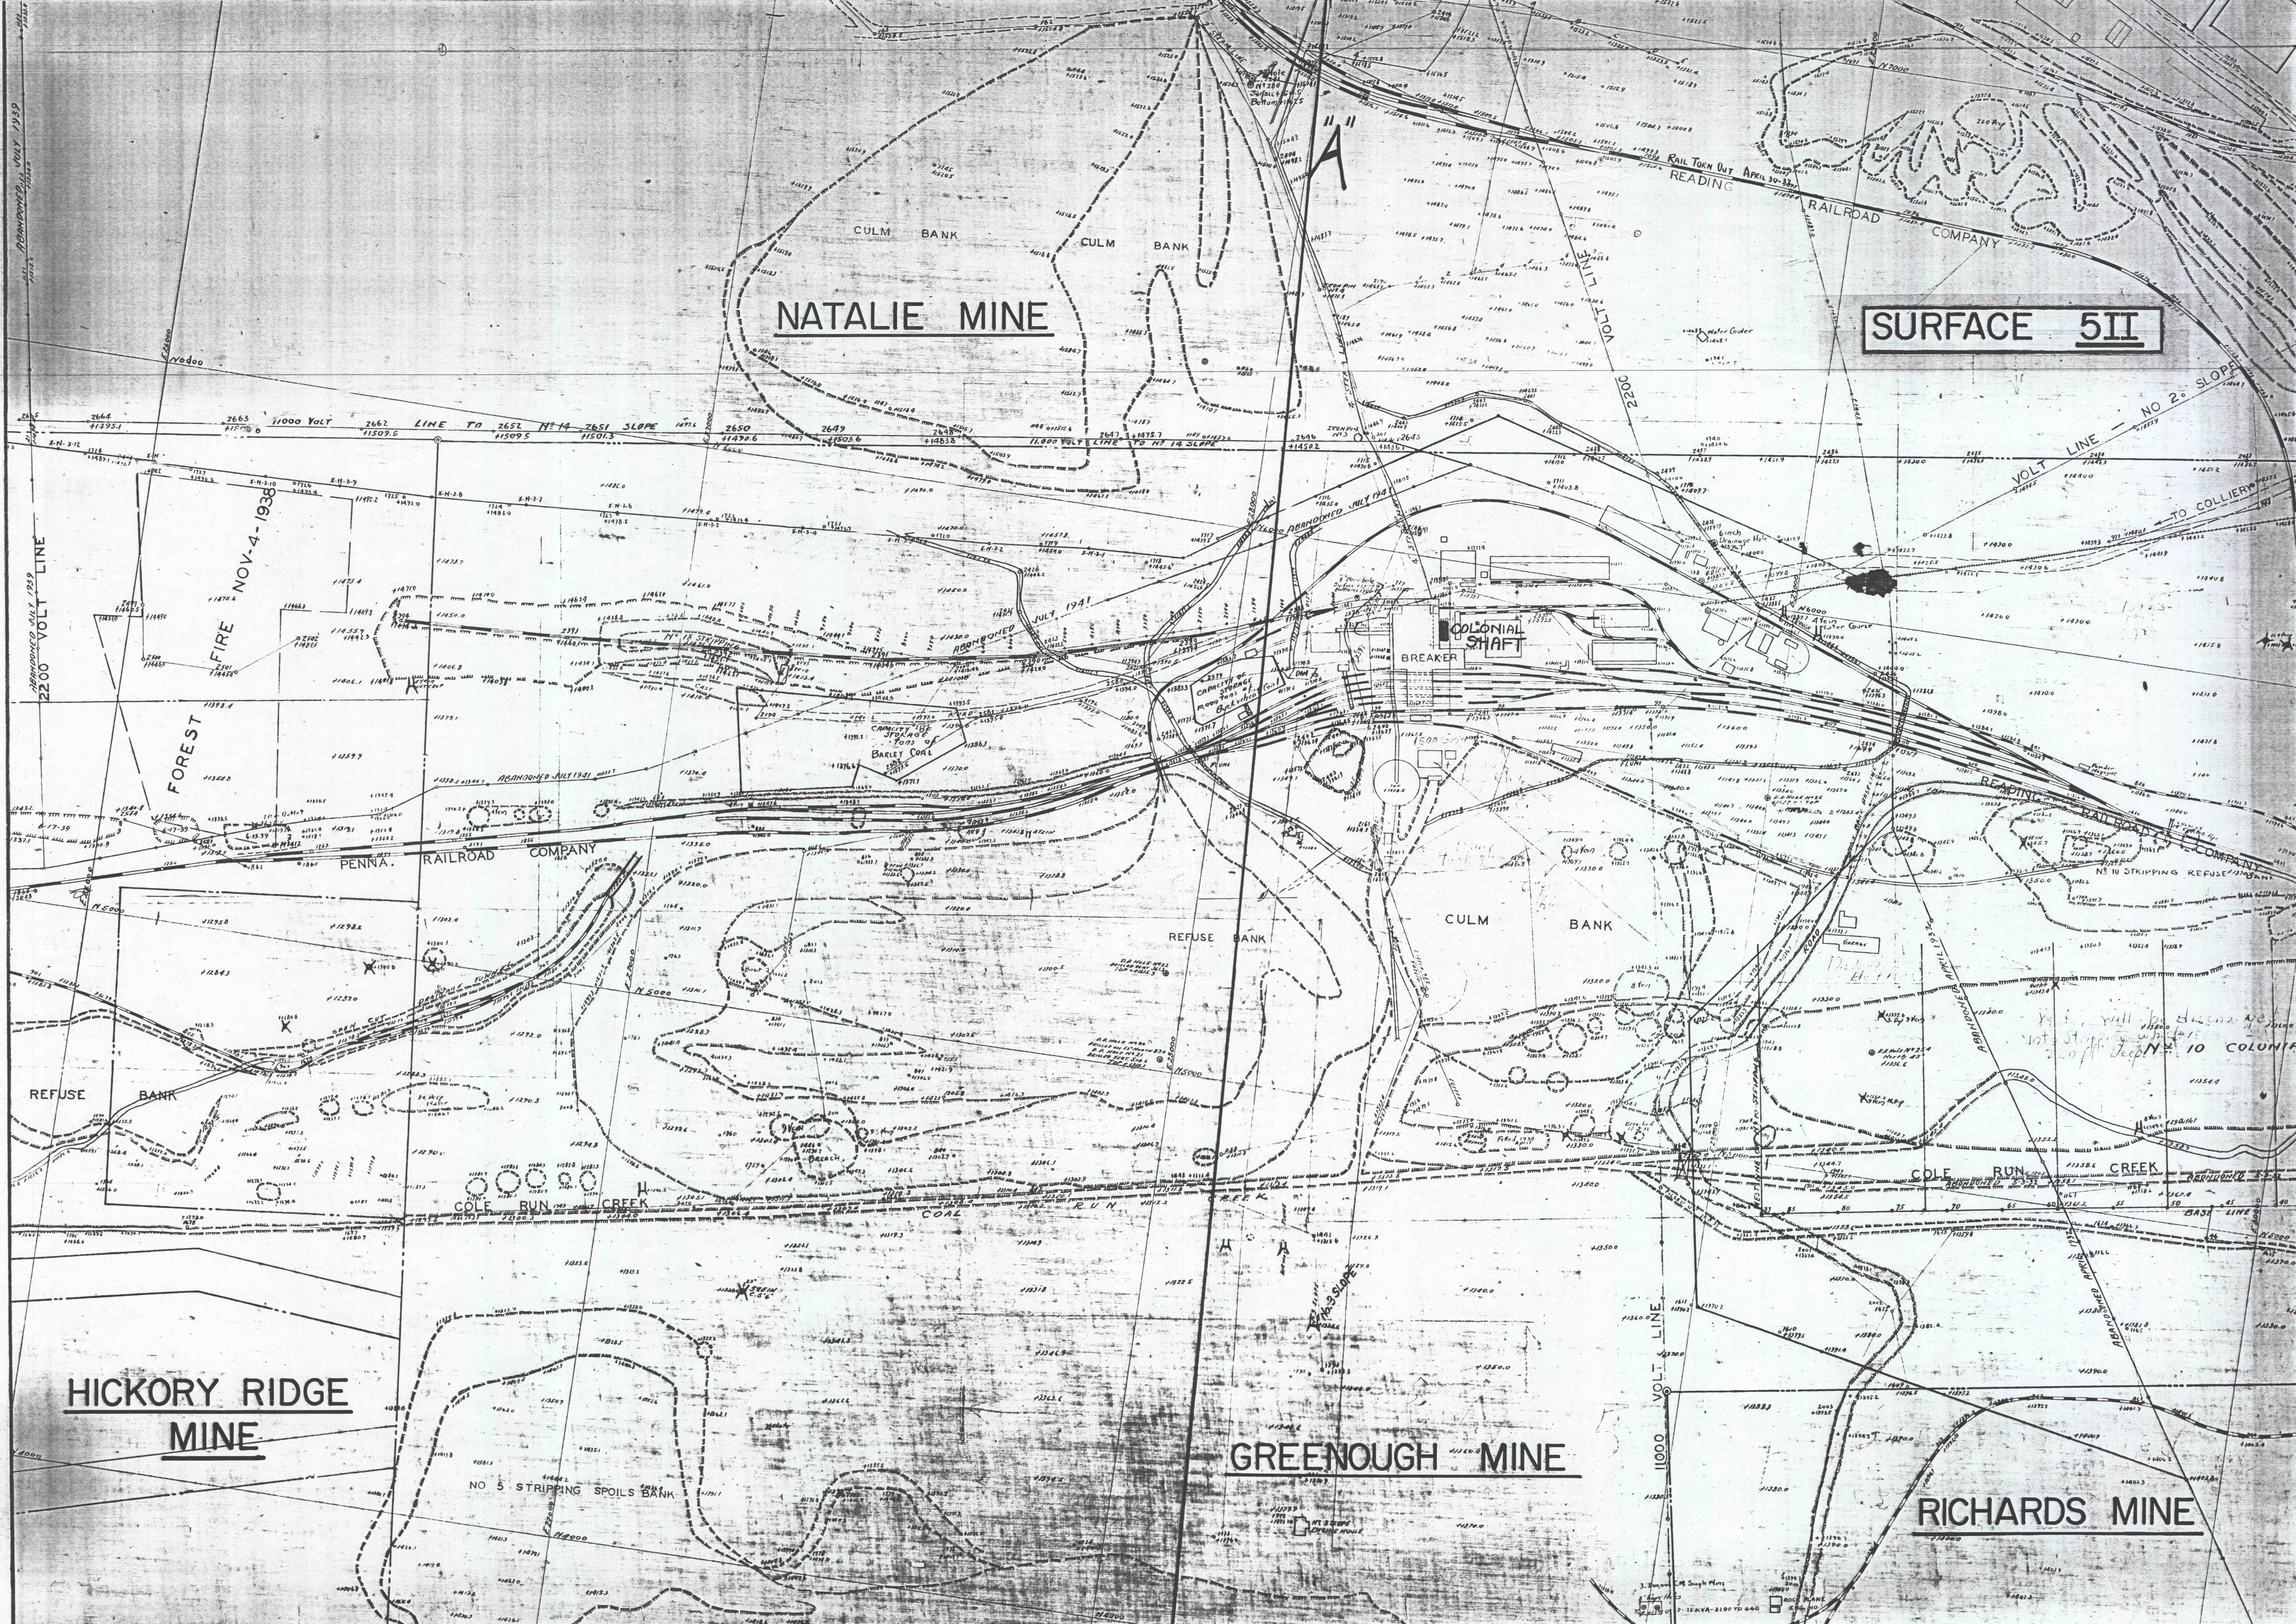

NATALIE MINE

SURFACE 5II

HICKORY RIDGE
MINE

GREENOUGH MINE

RICHARDS MINE

COLONIAL SHAFT

BREAKER

FOREST

FIRE NOV-4-1938

PENN. RAILROAD COMPANY

REFUSE BANK

REFUSE BANK

CULM BANK

COLE RUN CREEK

COLE RUN CREEK

NO 5 STRIPPING SPOILS BANK

VOLT LINE

VOLT LINE NO 2 SLOPE

RAILROAD COMPANY

RAILROAD COMPANY

ABANDONED JULY 1939

ABANDONED JULY 1939

ABANDONED JULY 1939

ABANDONED JULY 1939