


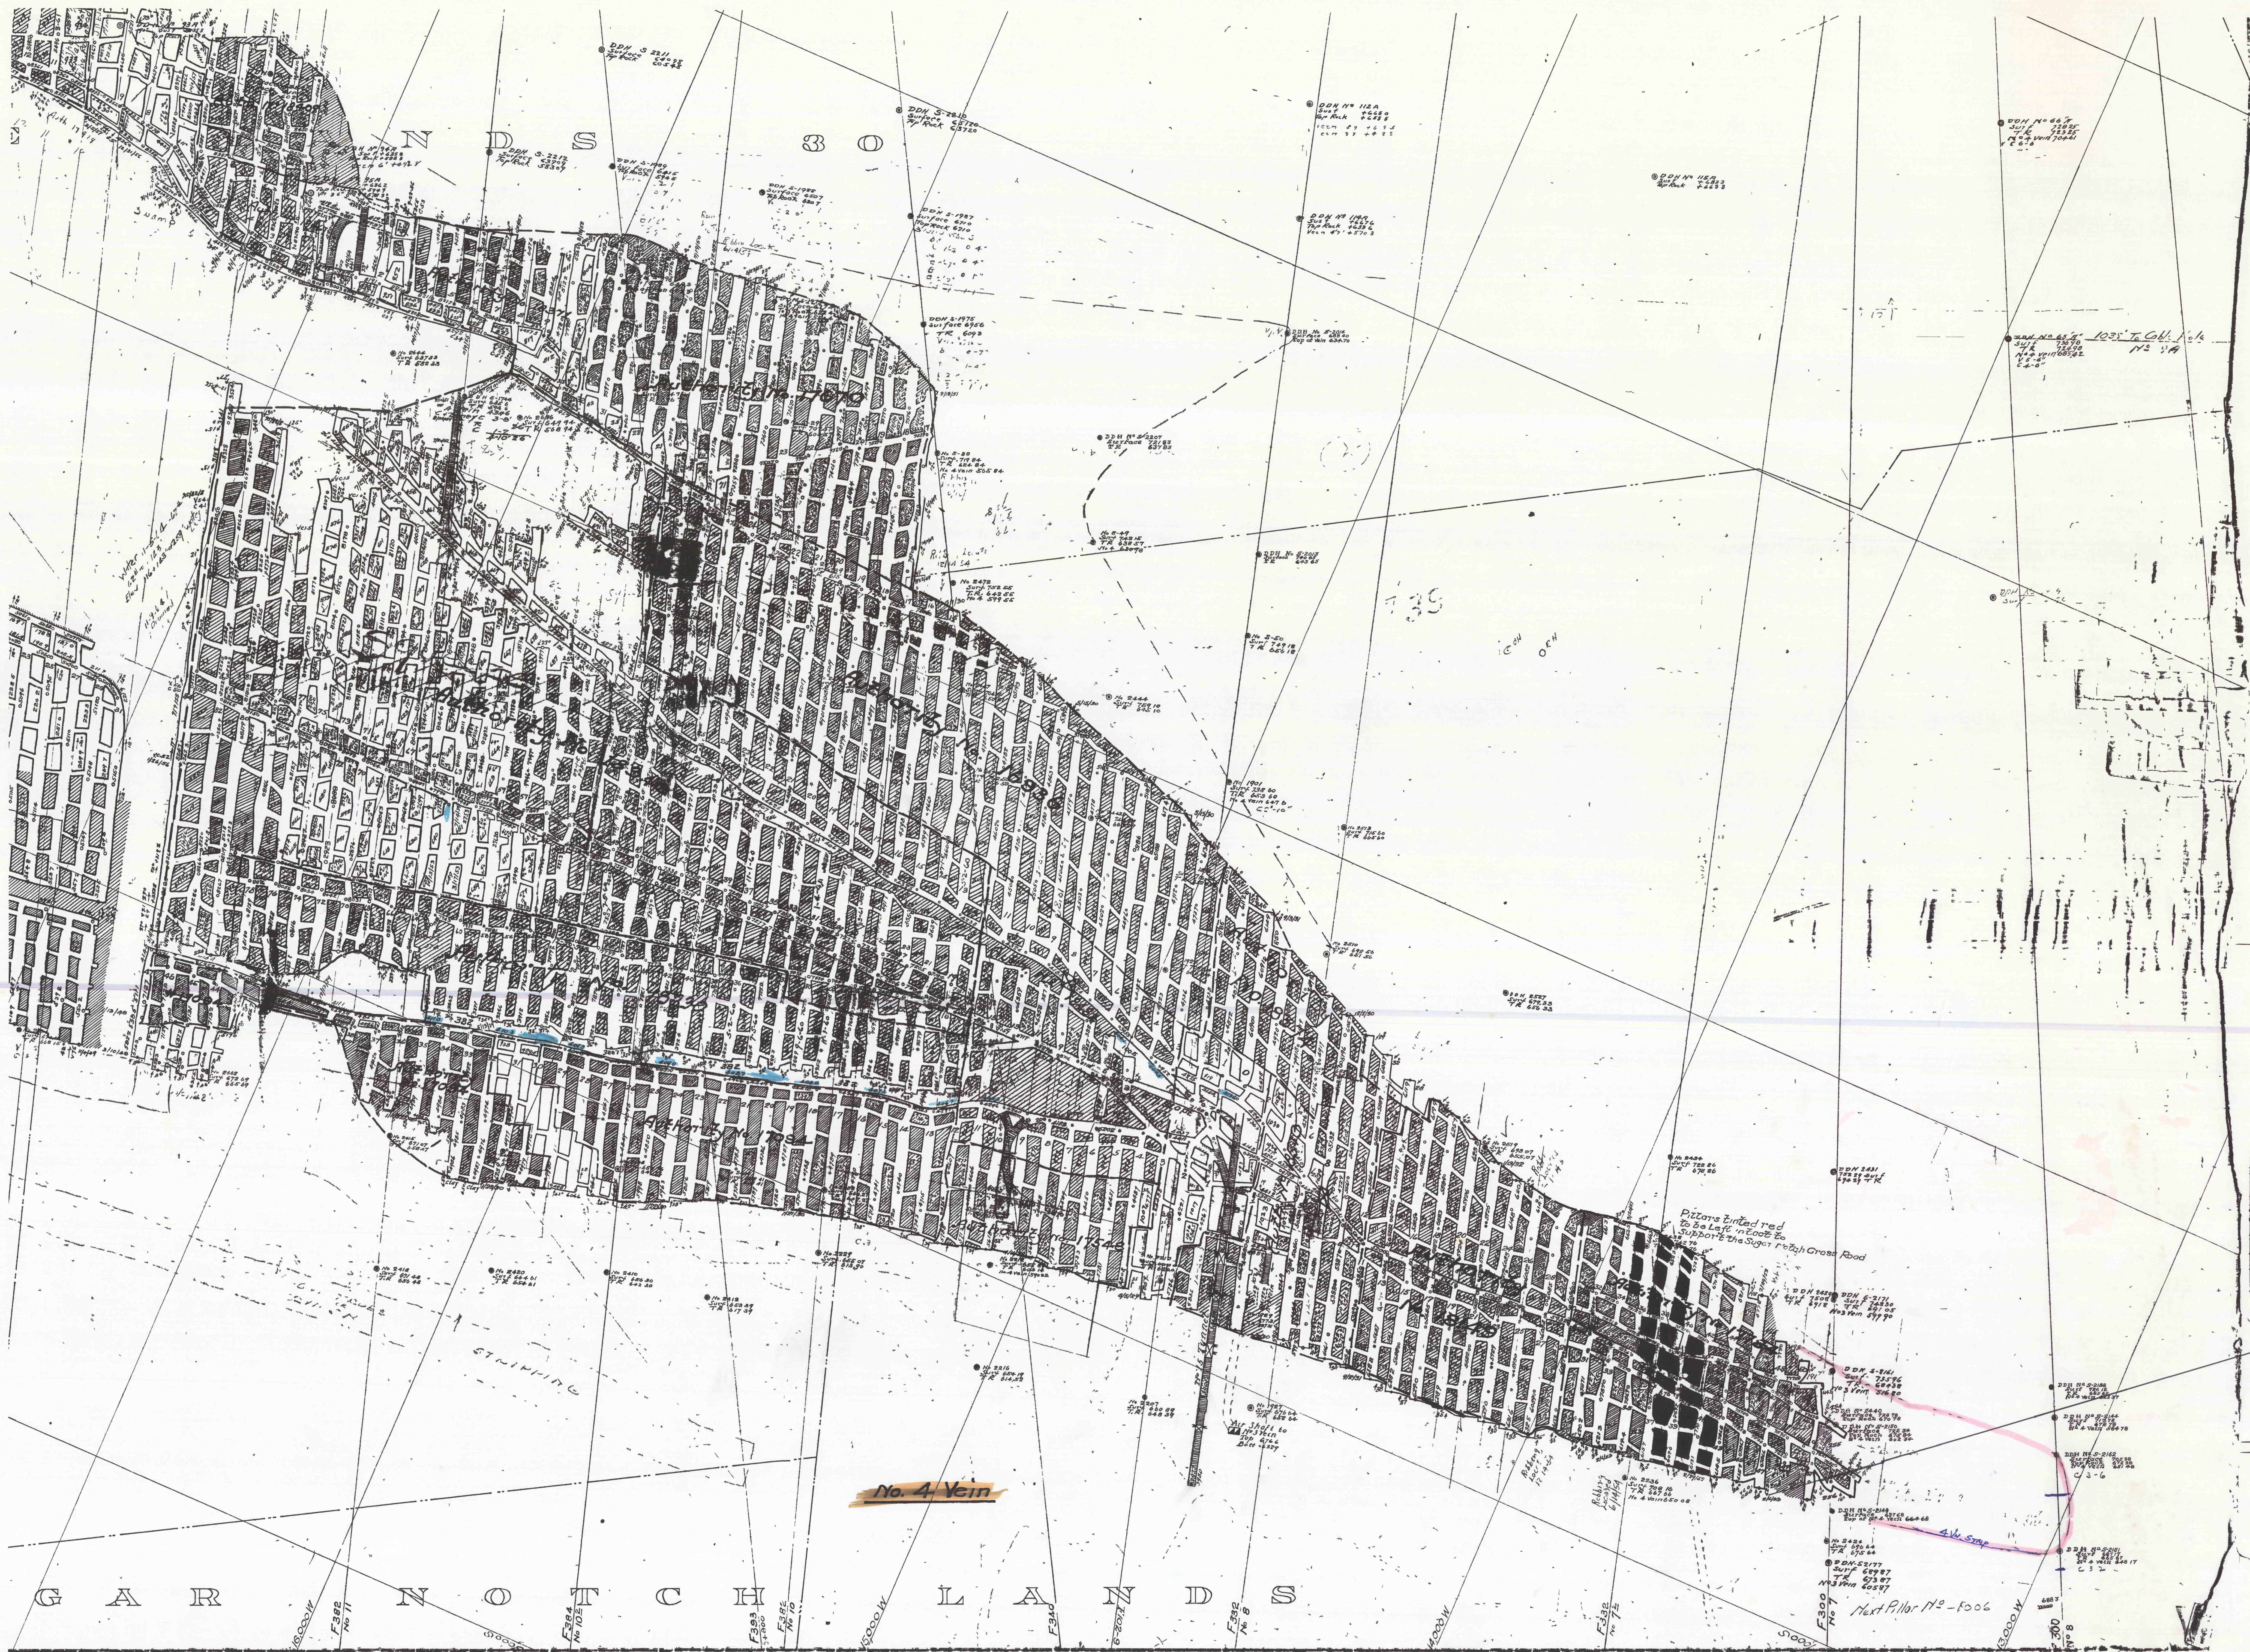

No. 4 Vein

G A R N O T H L A N D S

Next Pillar No. 1006

NOT STRIPPED