



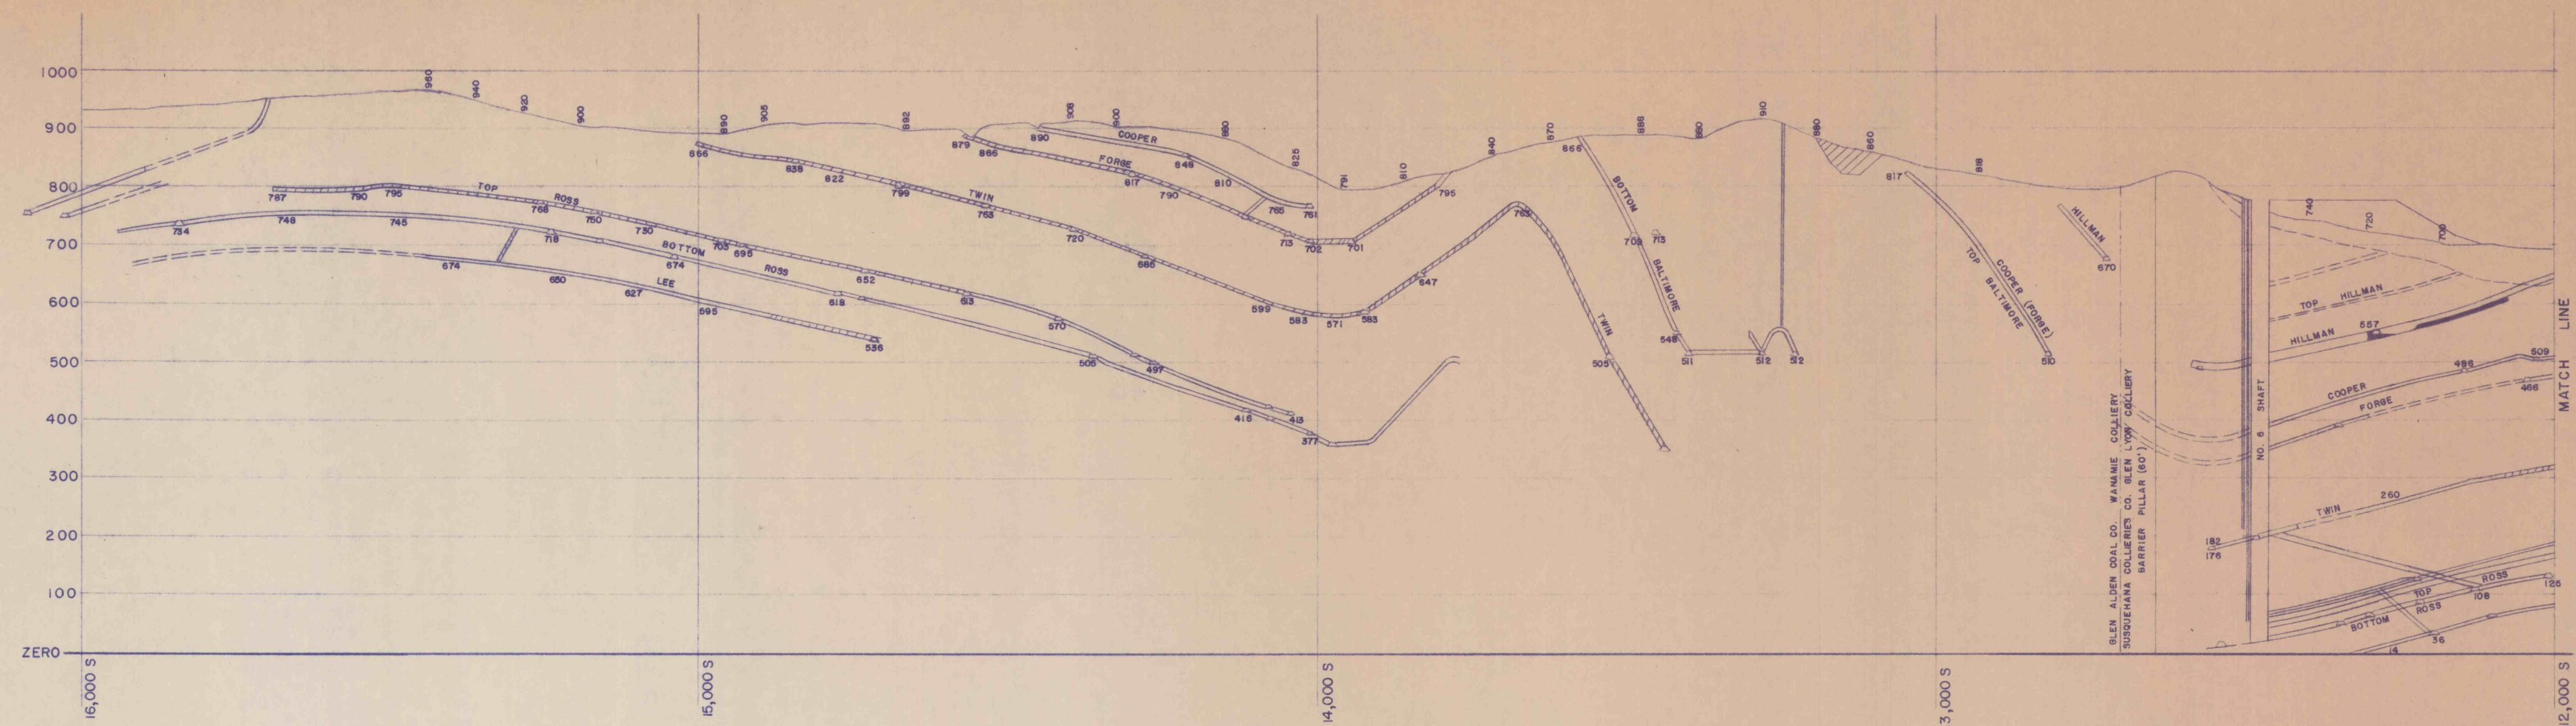

SL ?

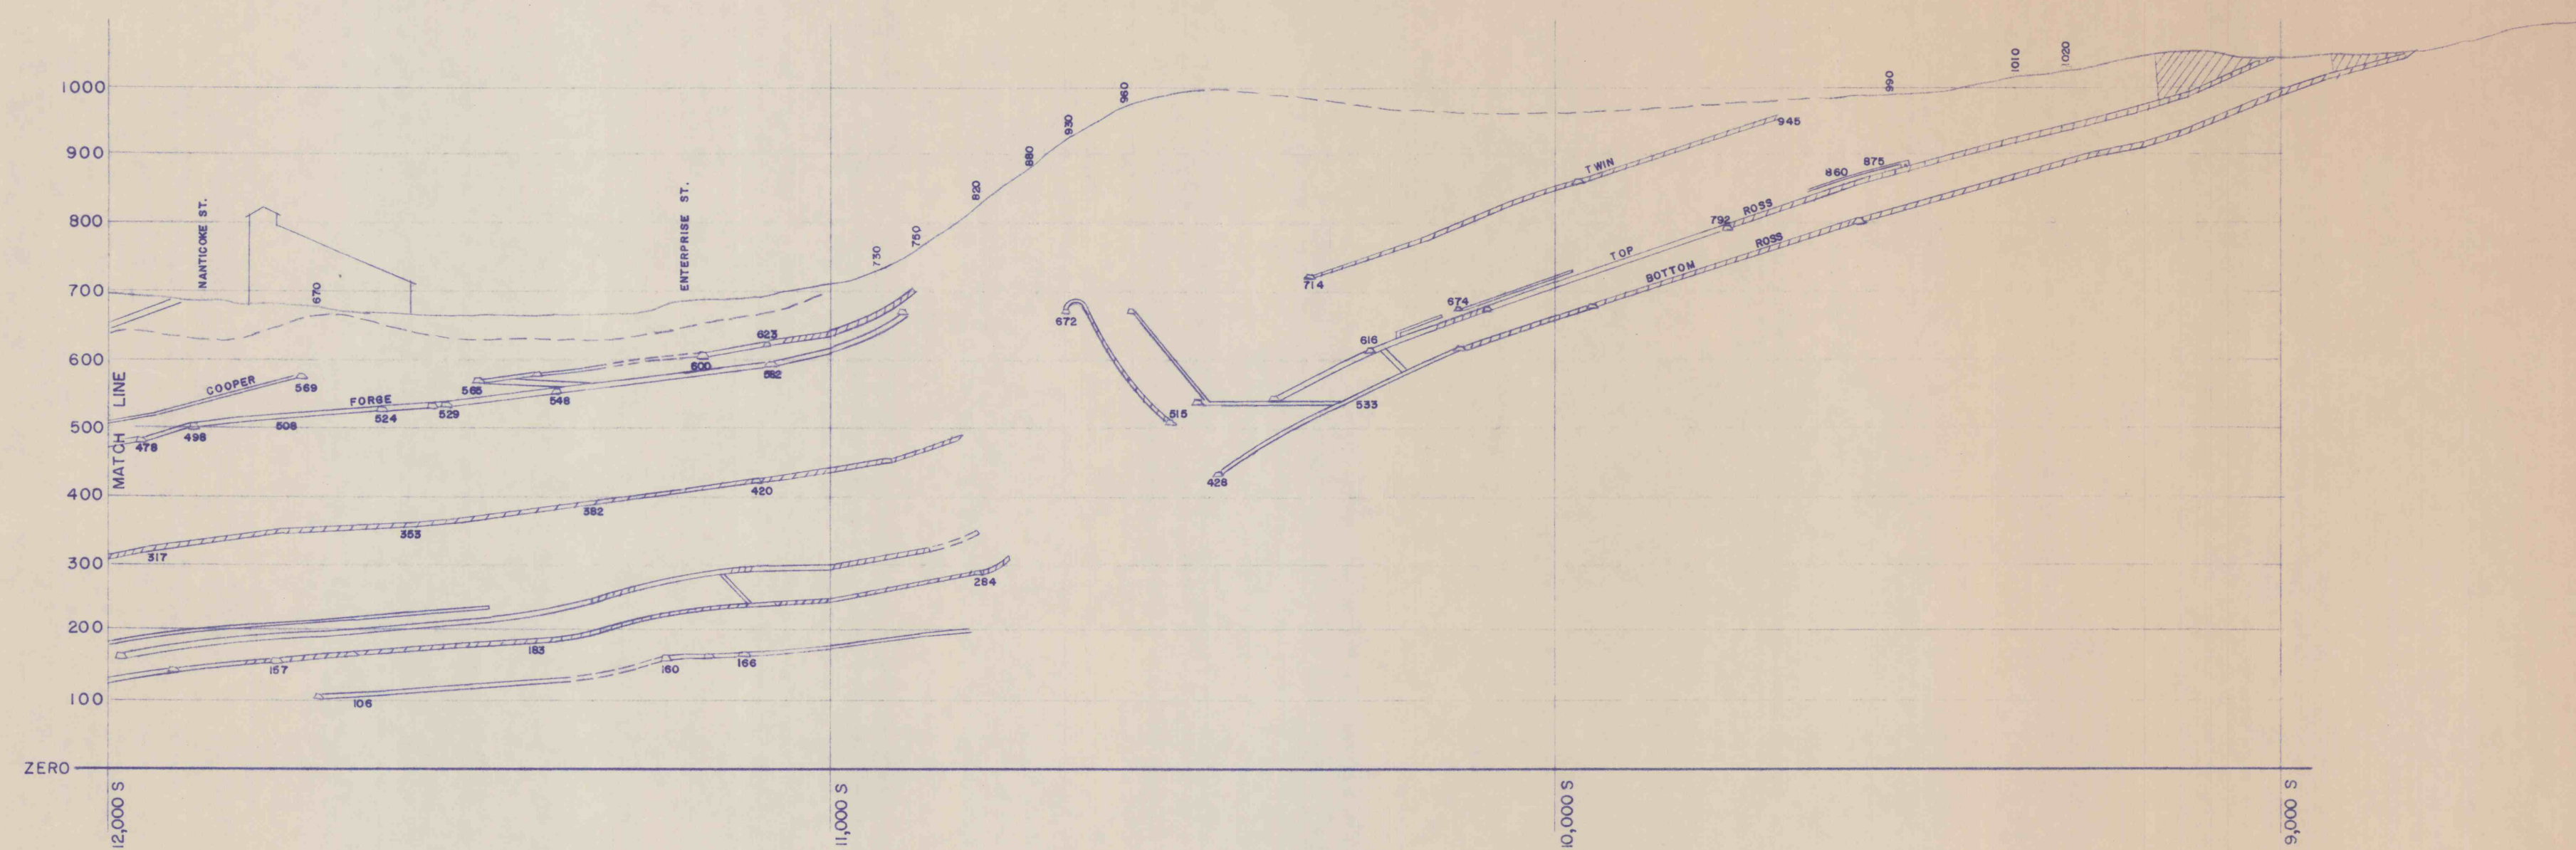



