
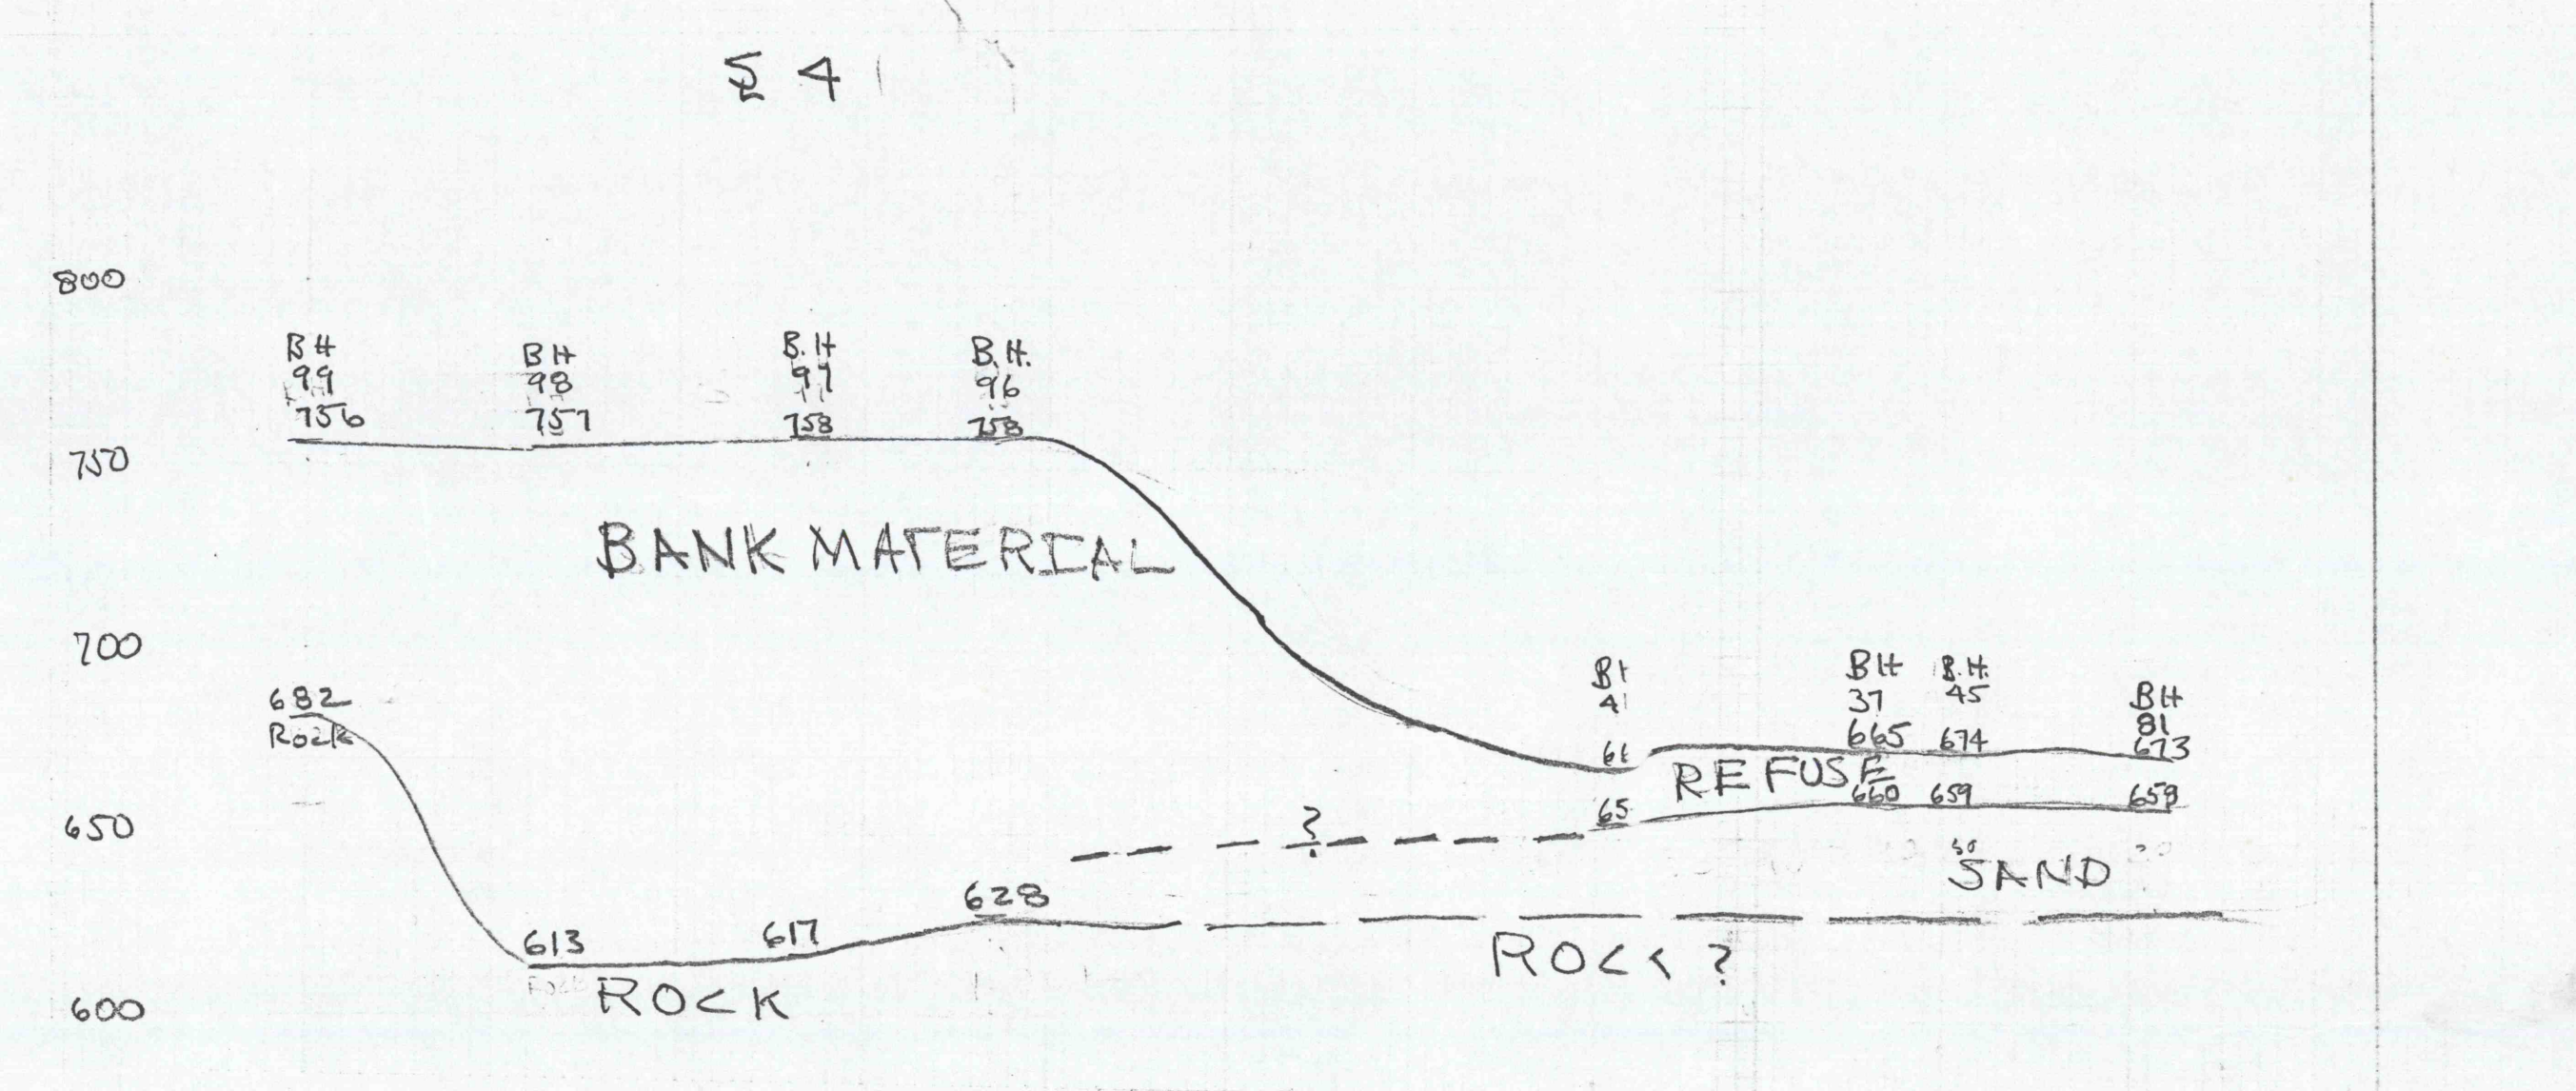
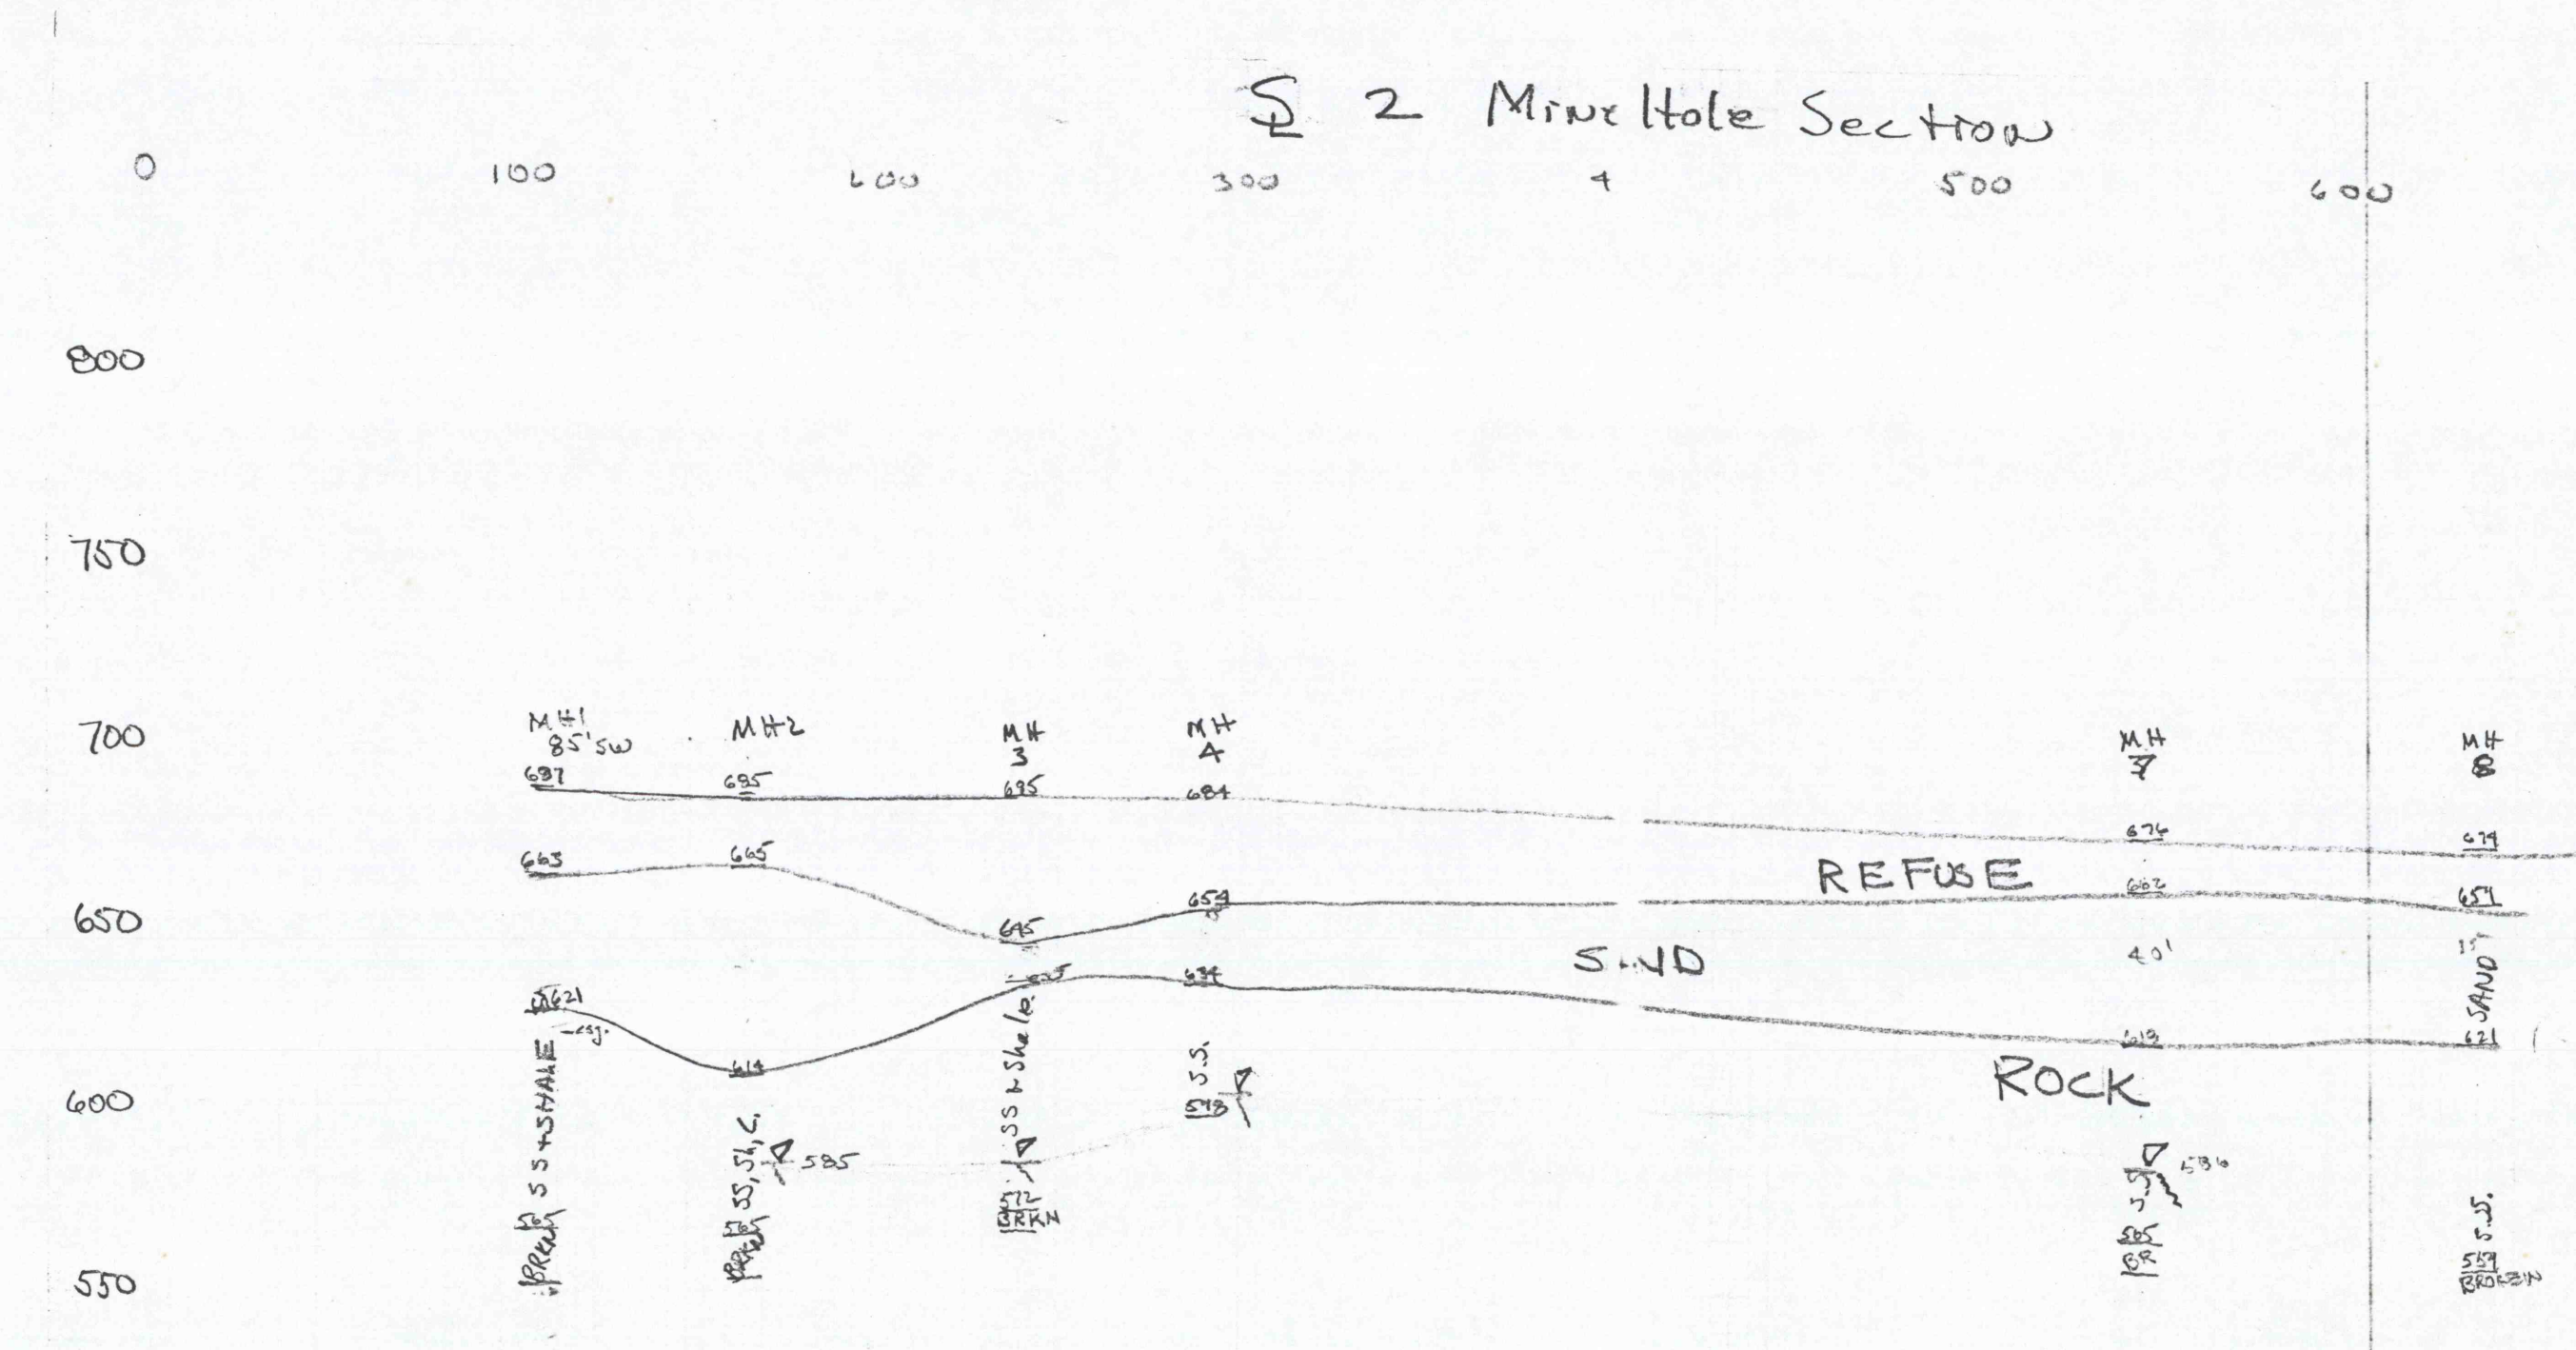
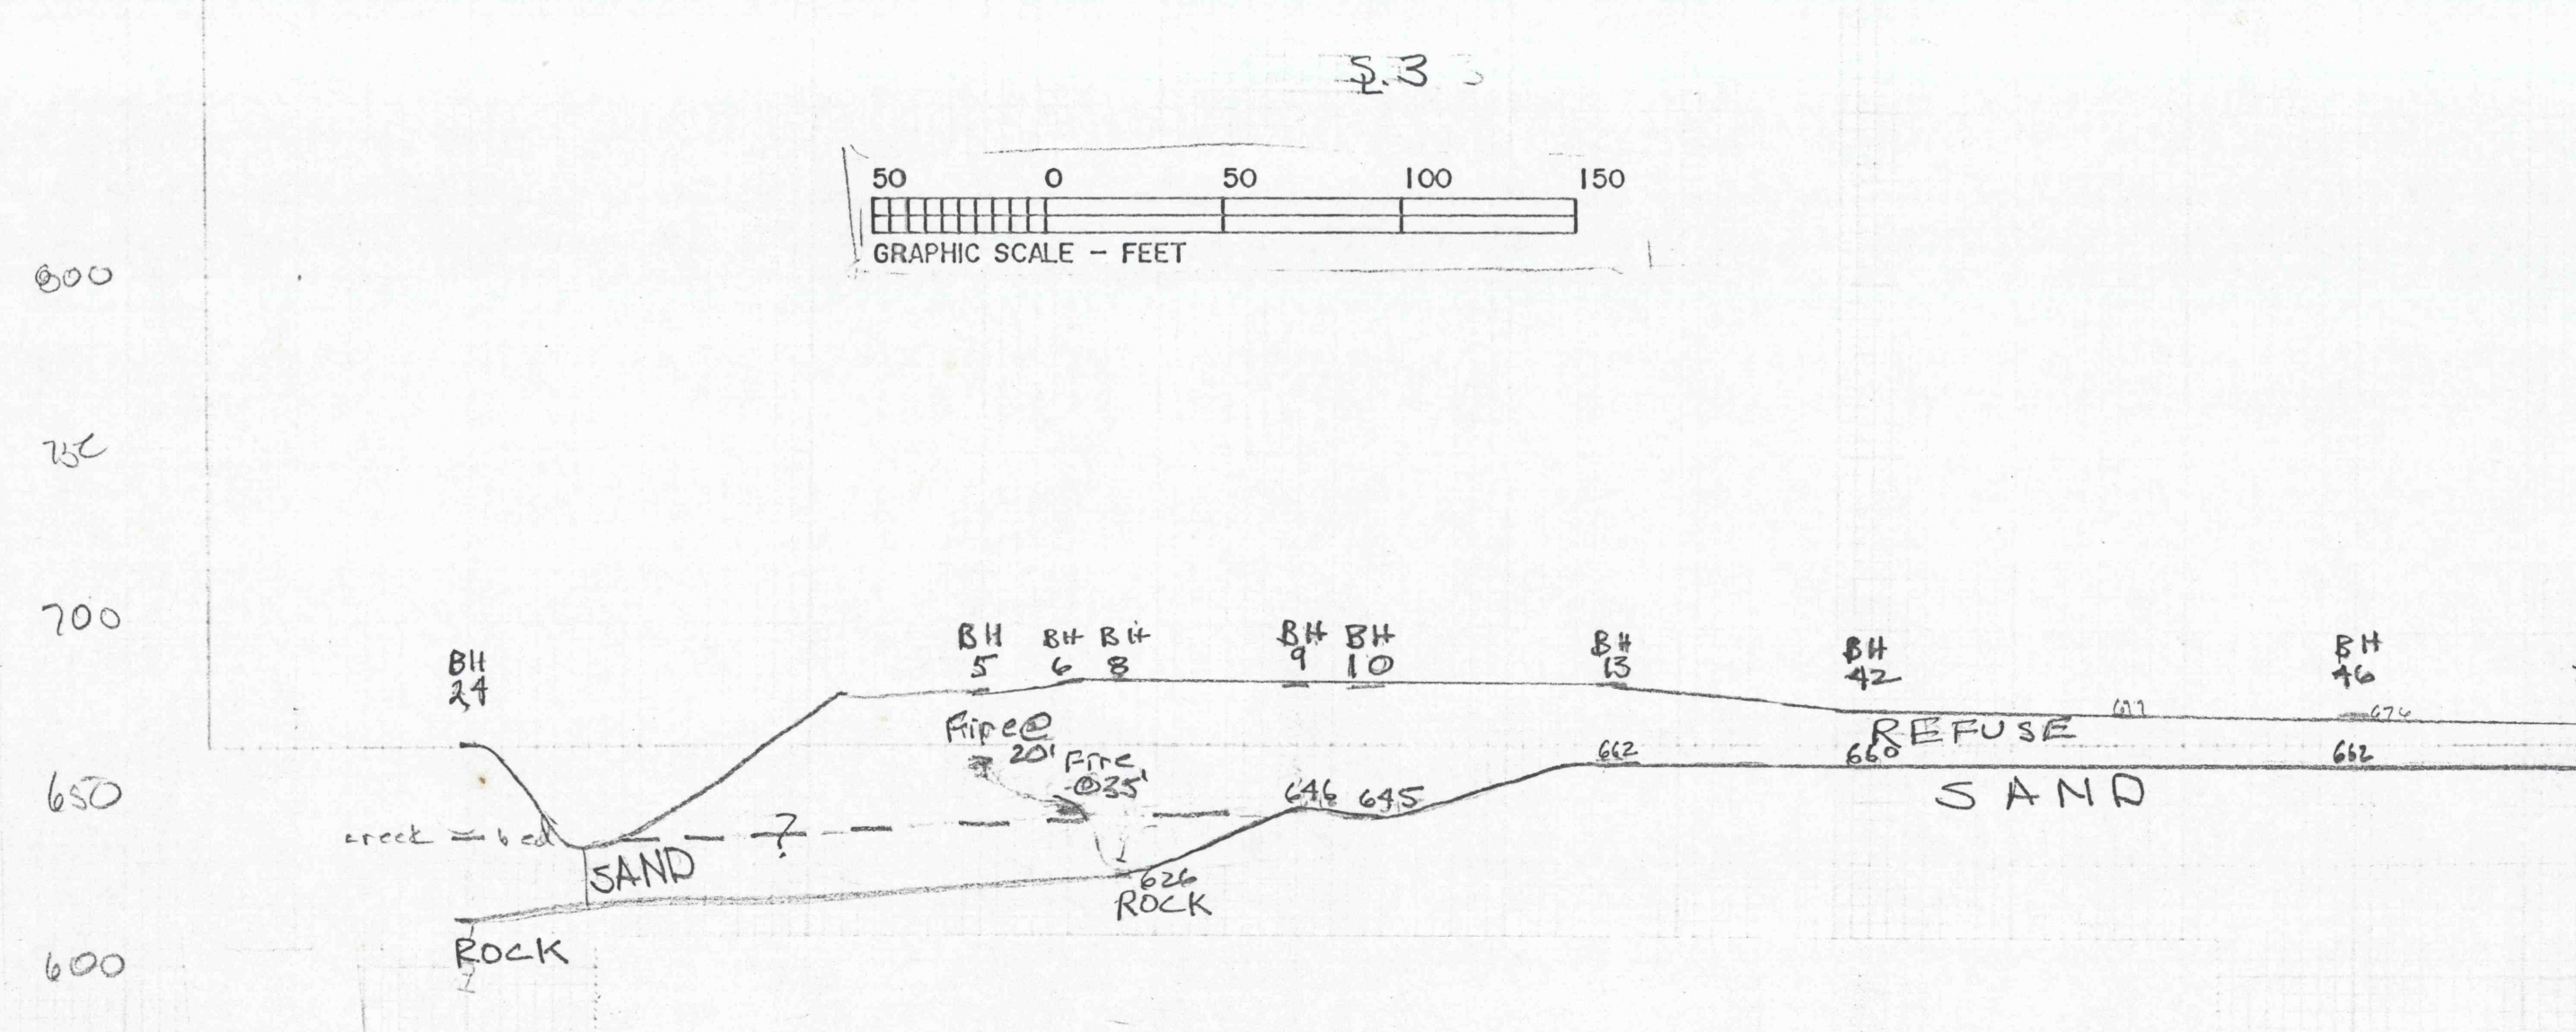
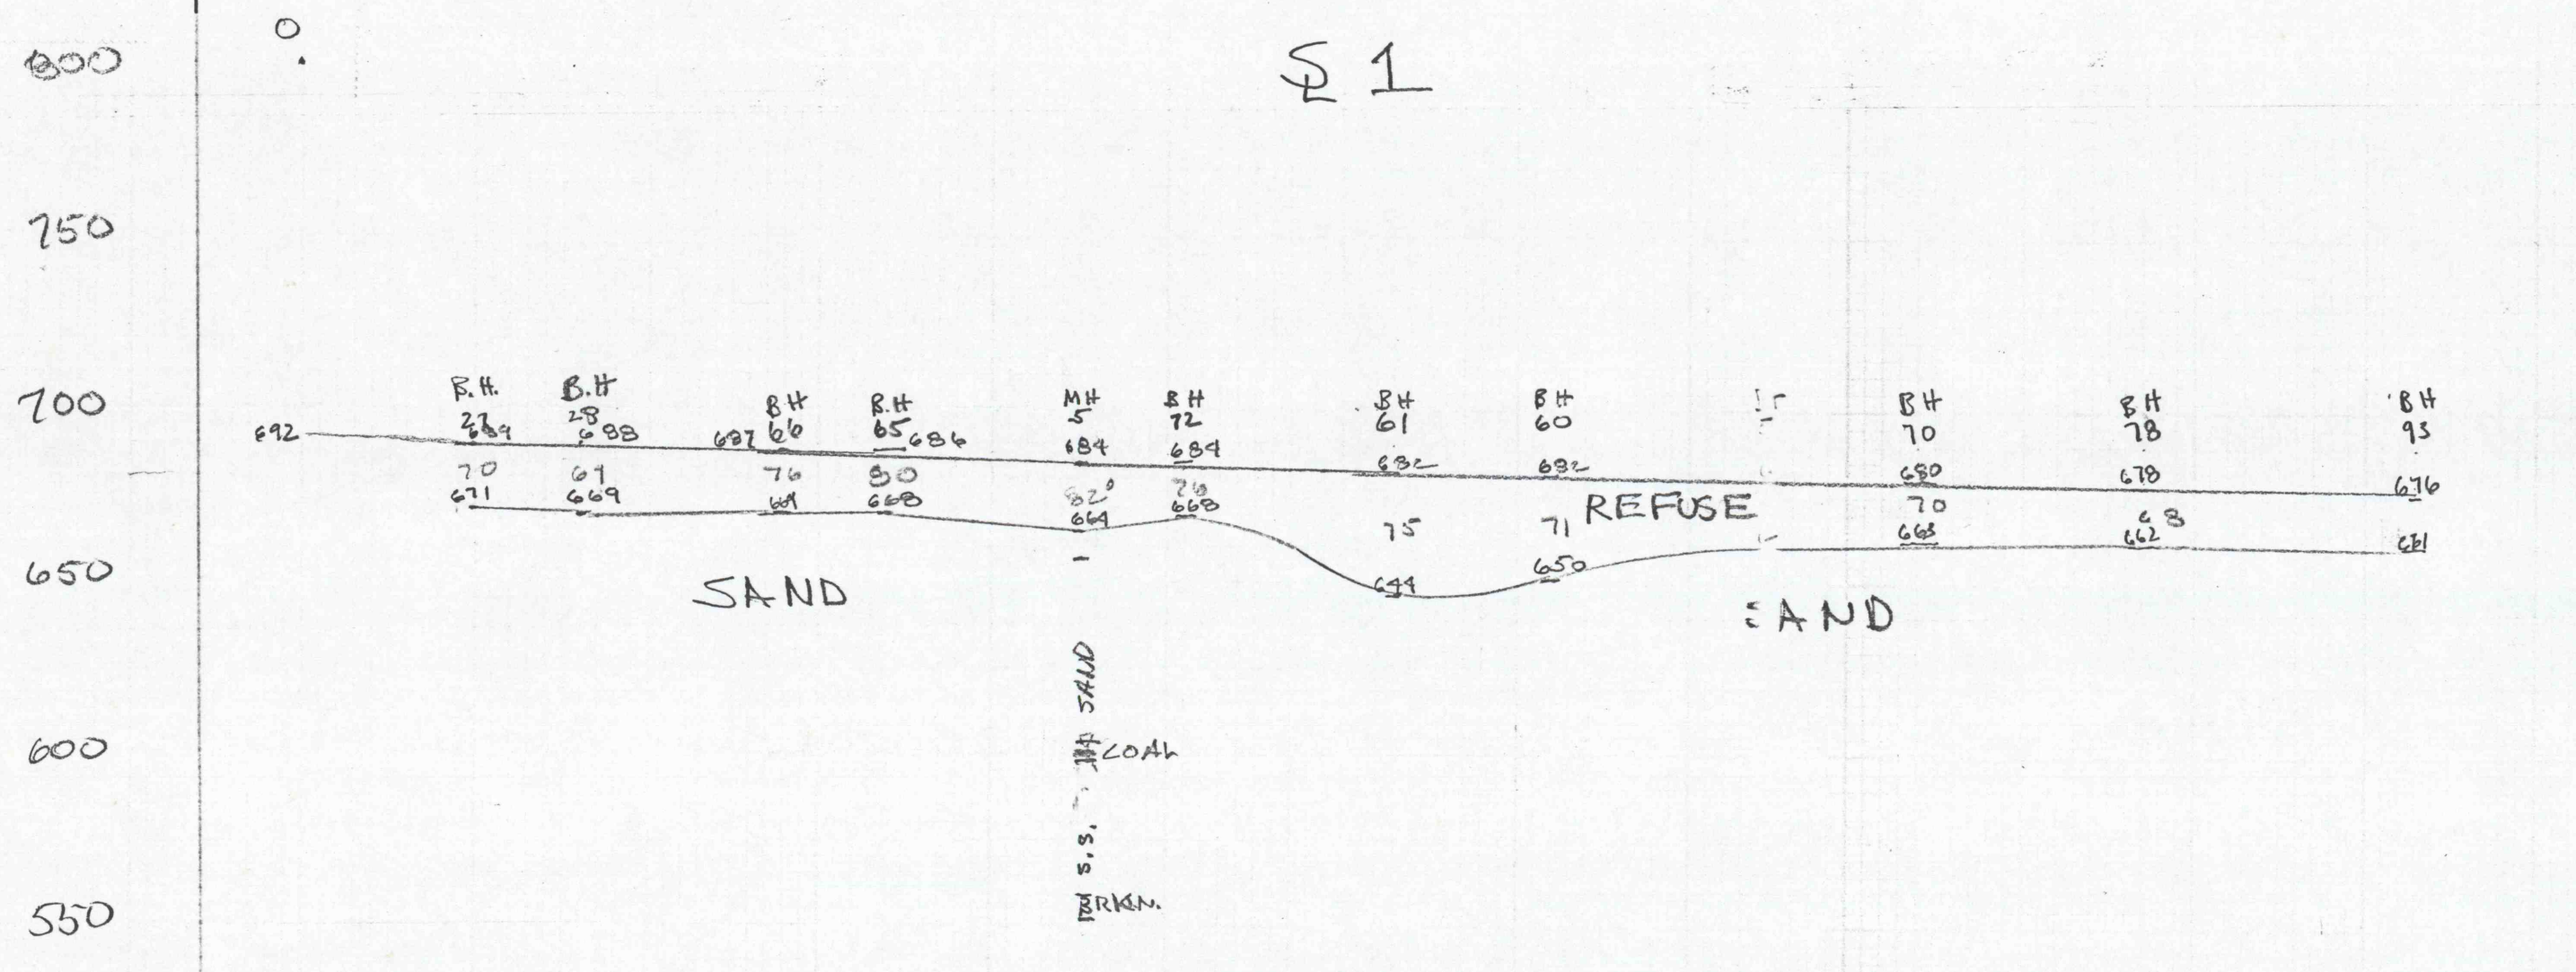
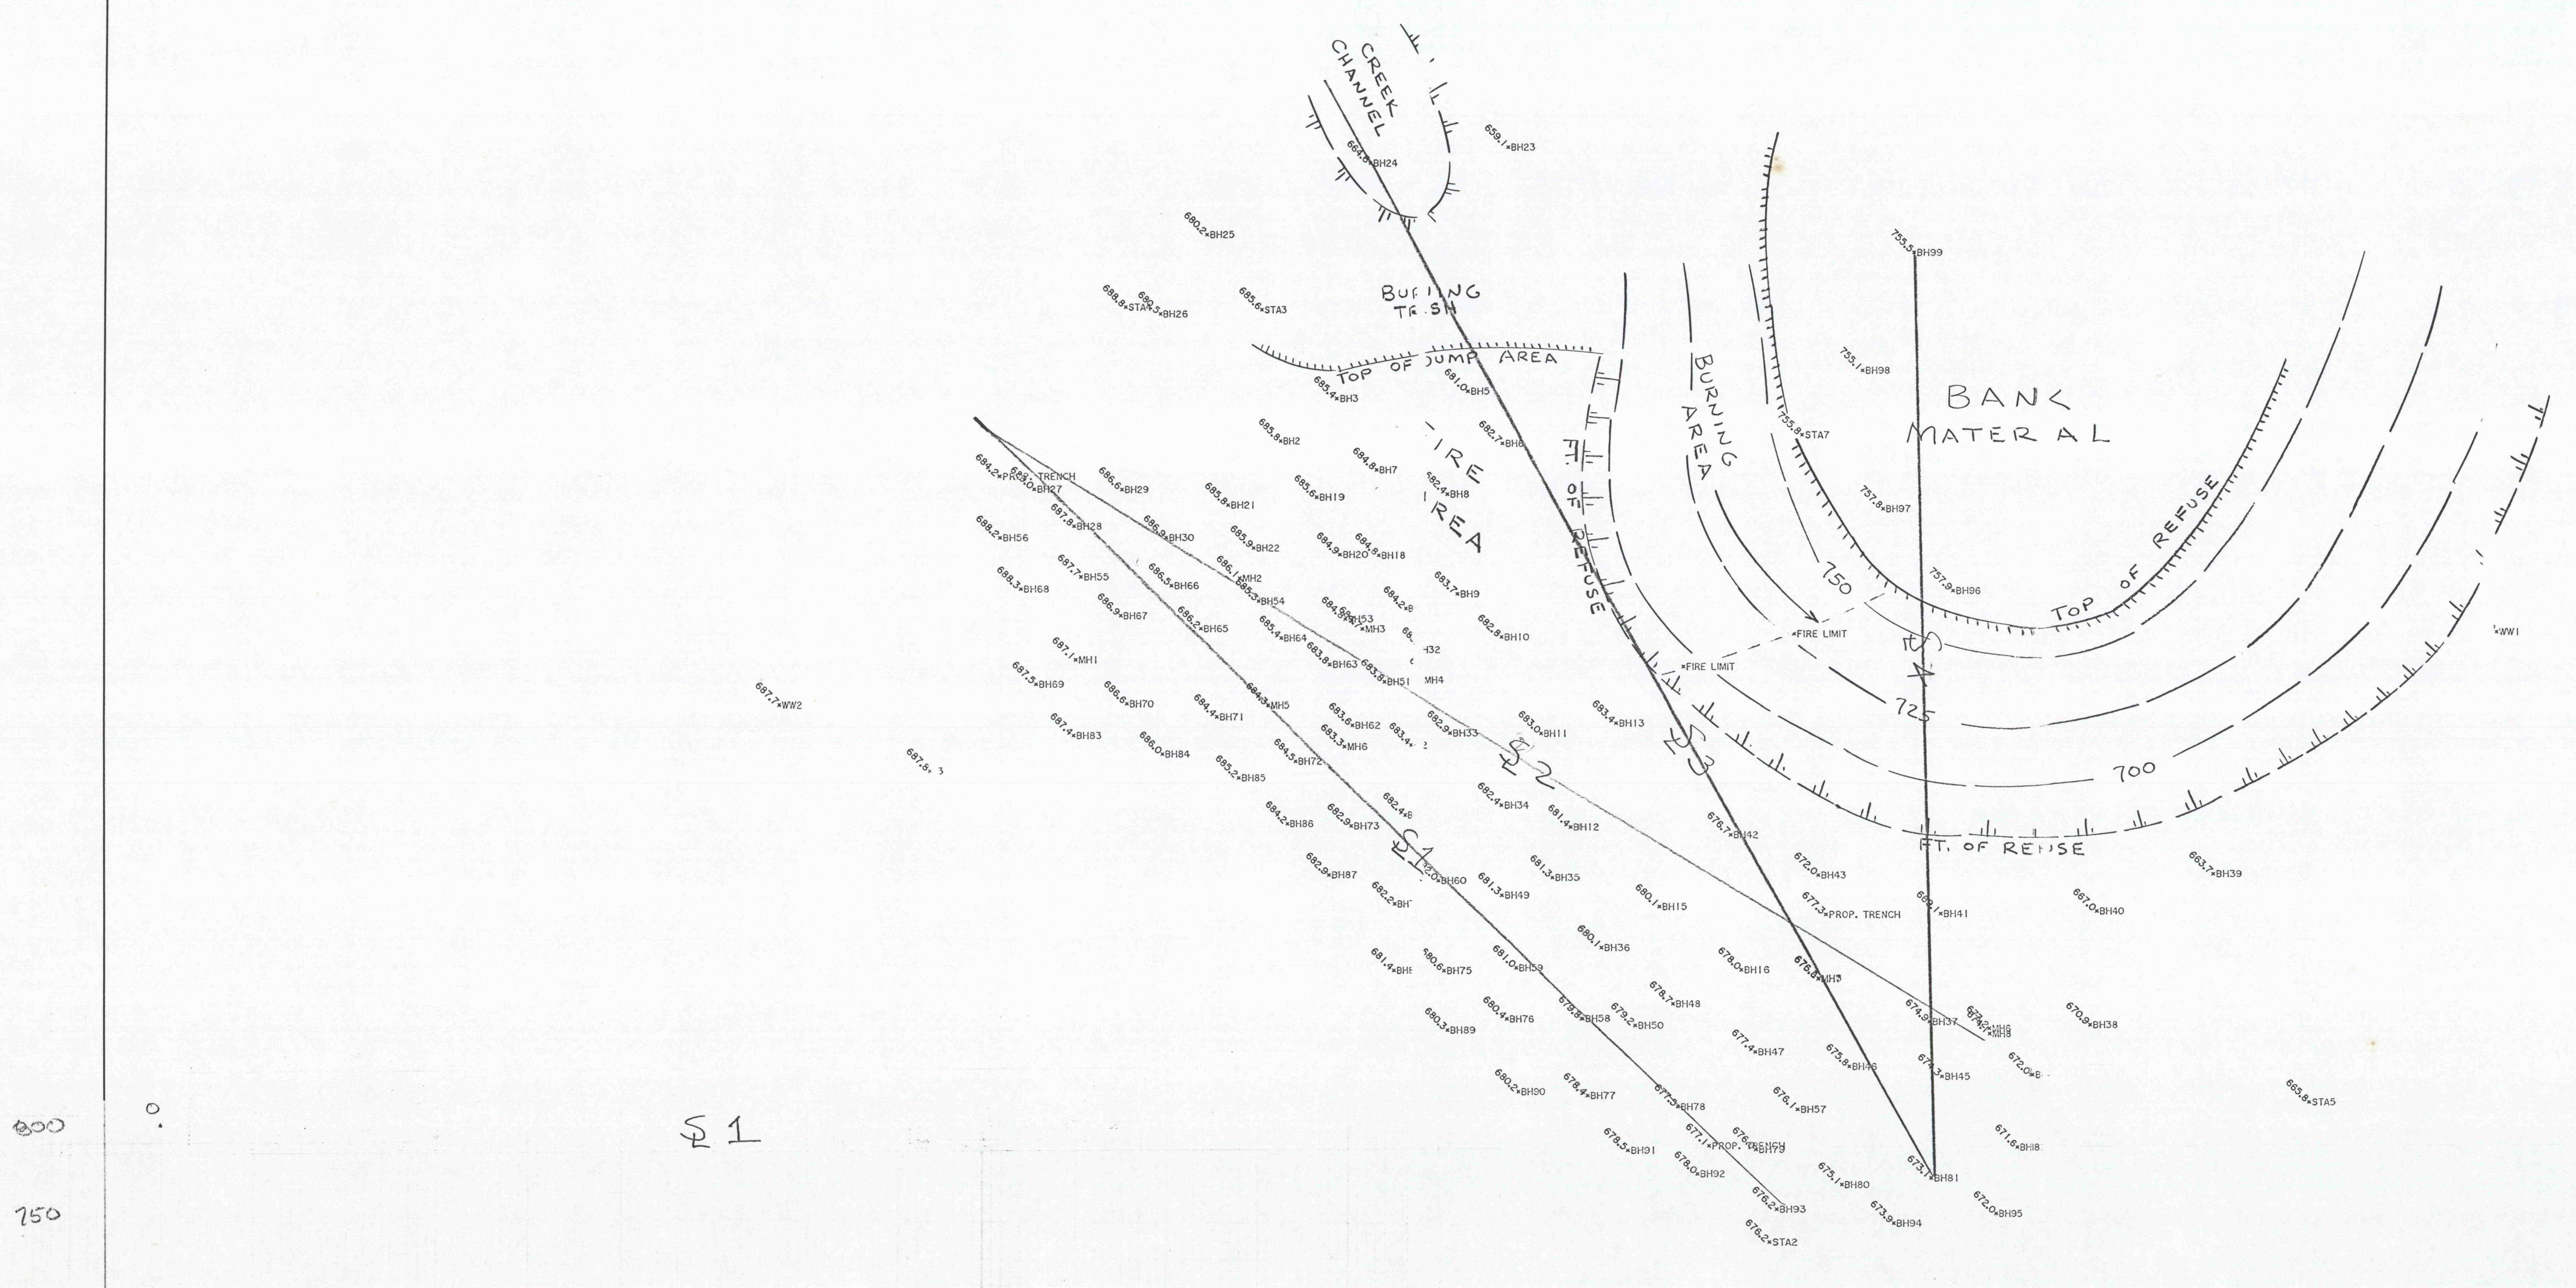


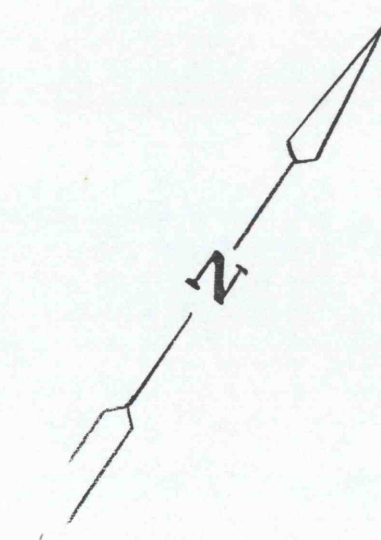

NEWPORT TWP. PIT 3 REF SE FIRE
OCTOBER 8, 1903
Figure 2