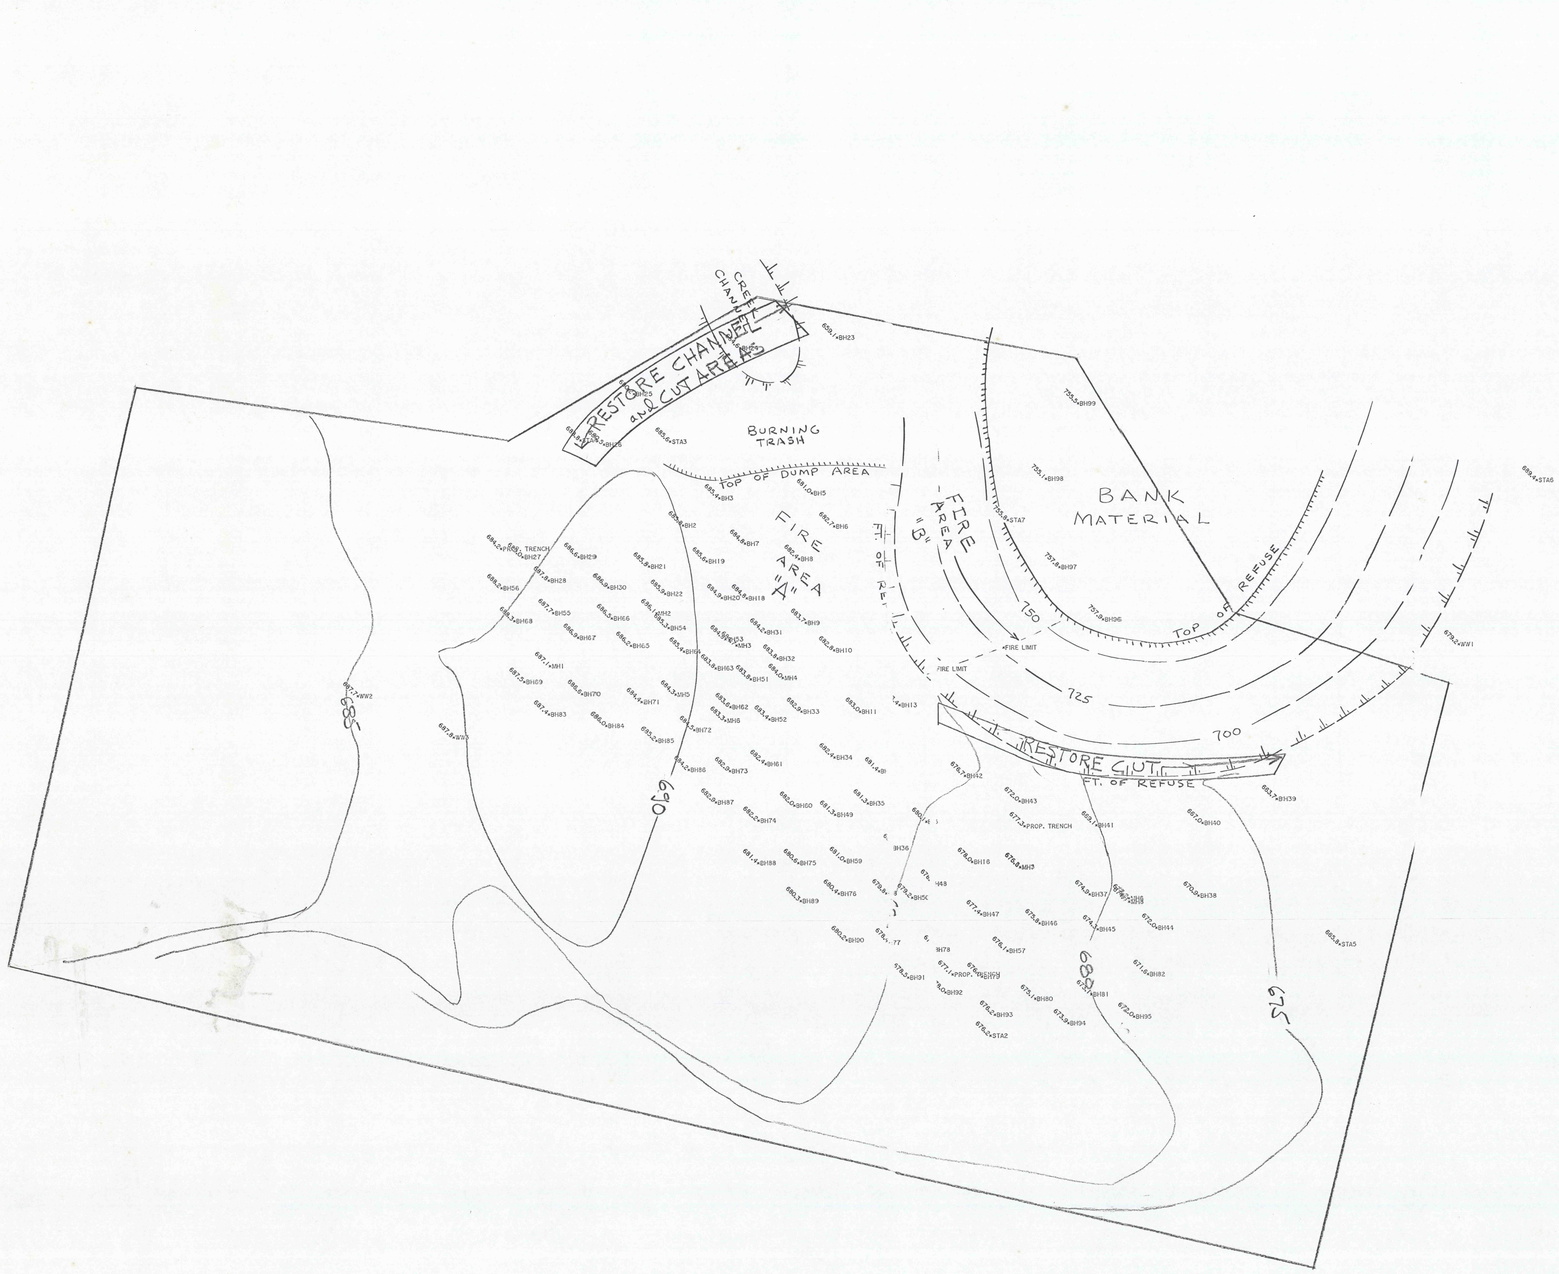


50 0 50 100 150
GRAPHIC SCALE – FEET

NEWPORT TWP. PIT 31 REFUSE FIRE
OCTOBER 8, 2003

Figure 3, Restration

① Contour Lines are approximate ~675~

② Affected Area used on Item 6 —— (~20A)
Excavation Quantity
(does not include ingress-egress)

③ Cut Areas are approximate.