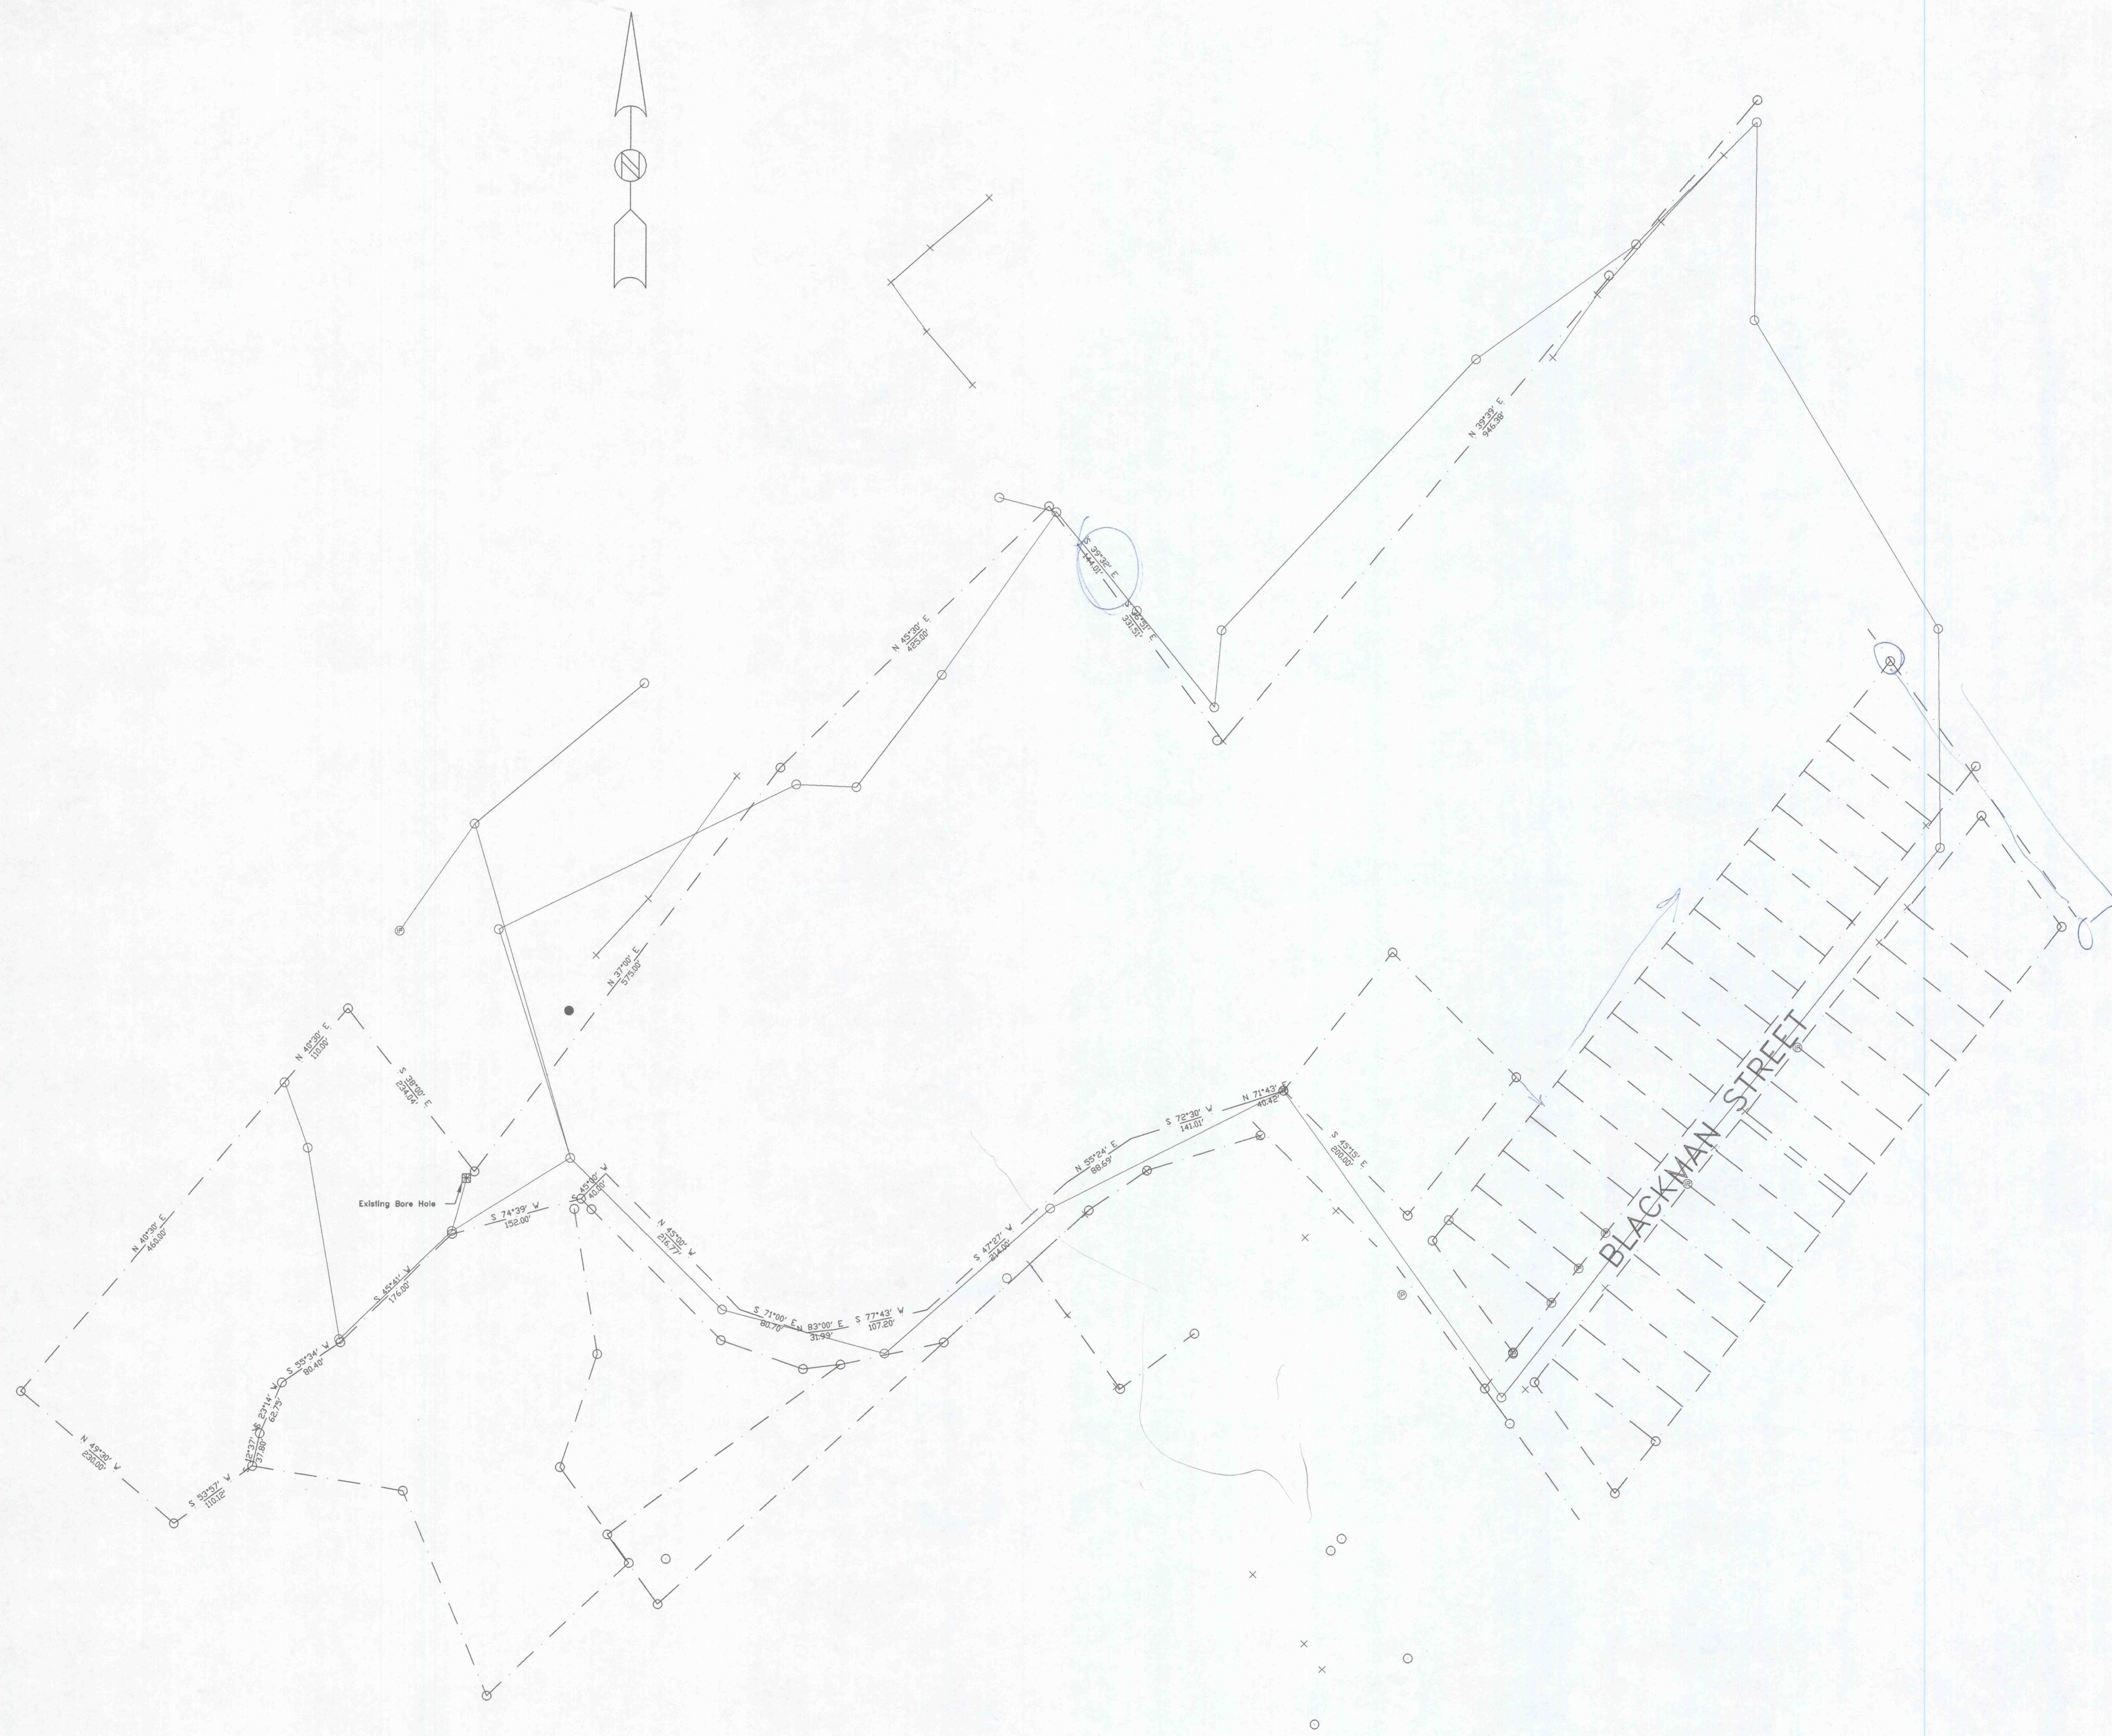


DRAWN BY:		APPROVED BY:		REVISIONS		PROJECT		SHT. NAME		SHT. NO.	
DATE:		PROJ. NO.									
DWG. NO.:		DWG.									