


CORRY STREET HOUSE

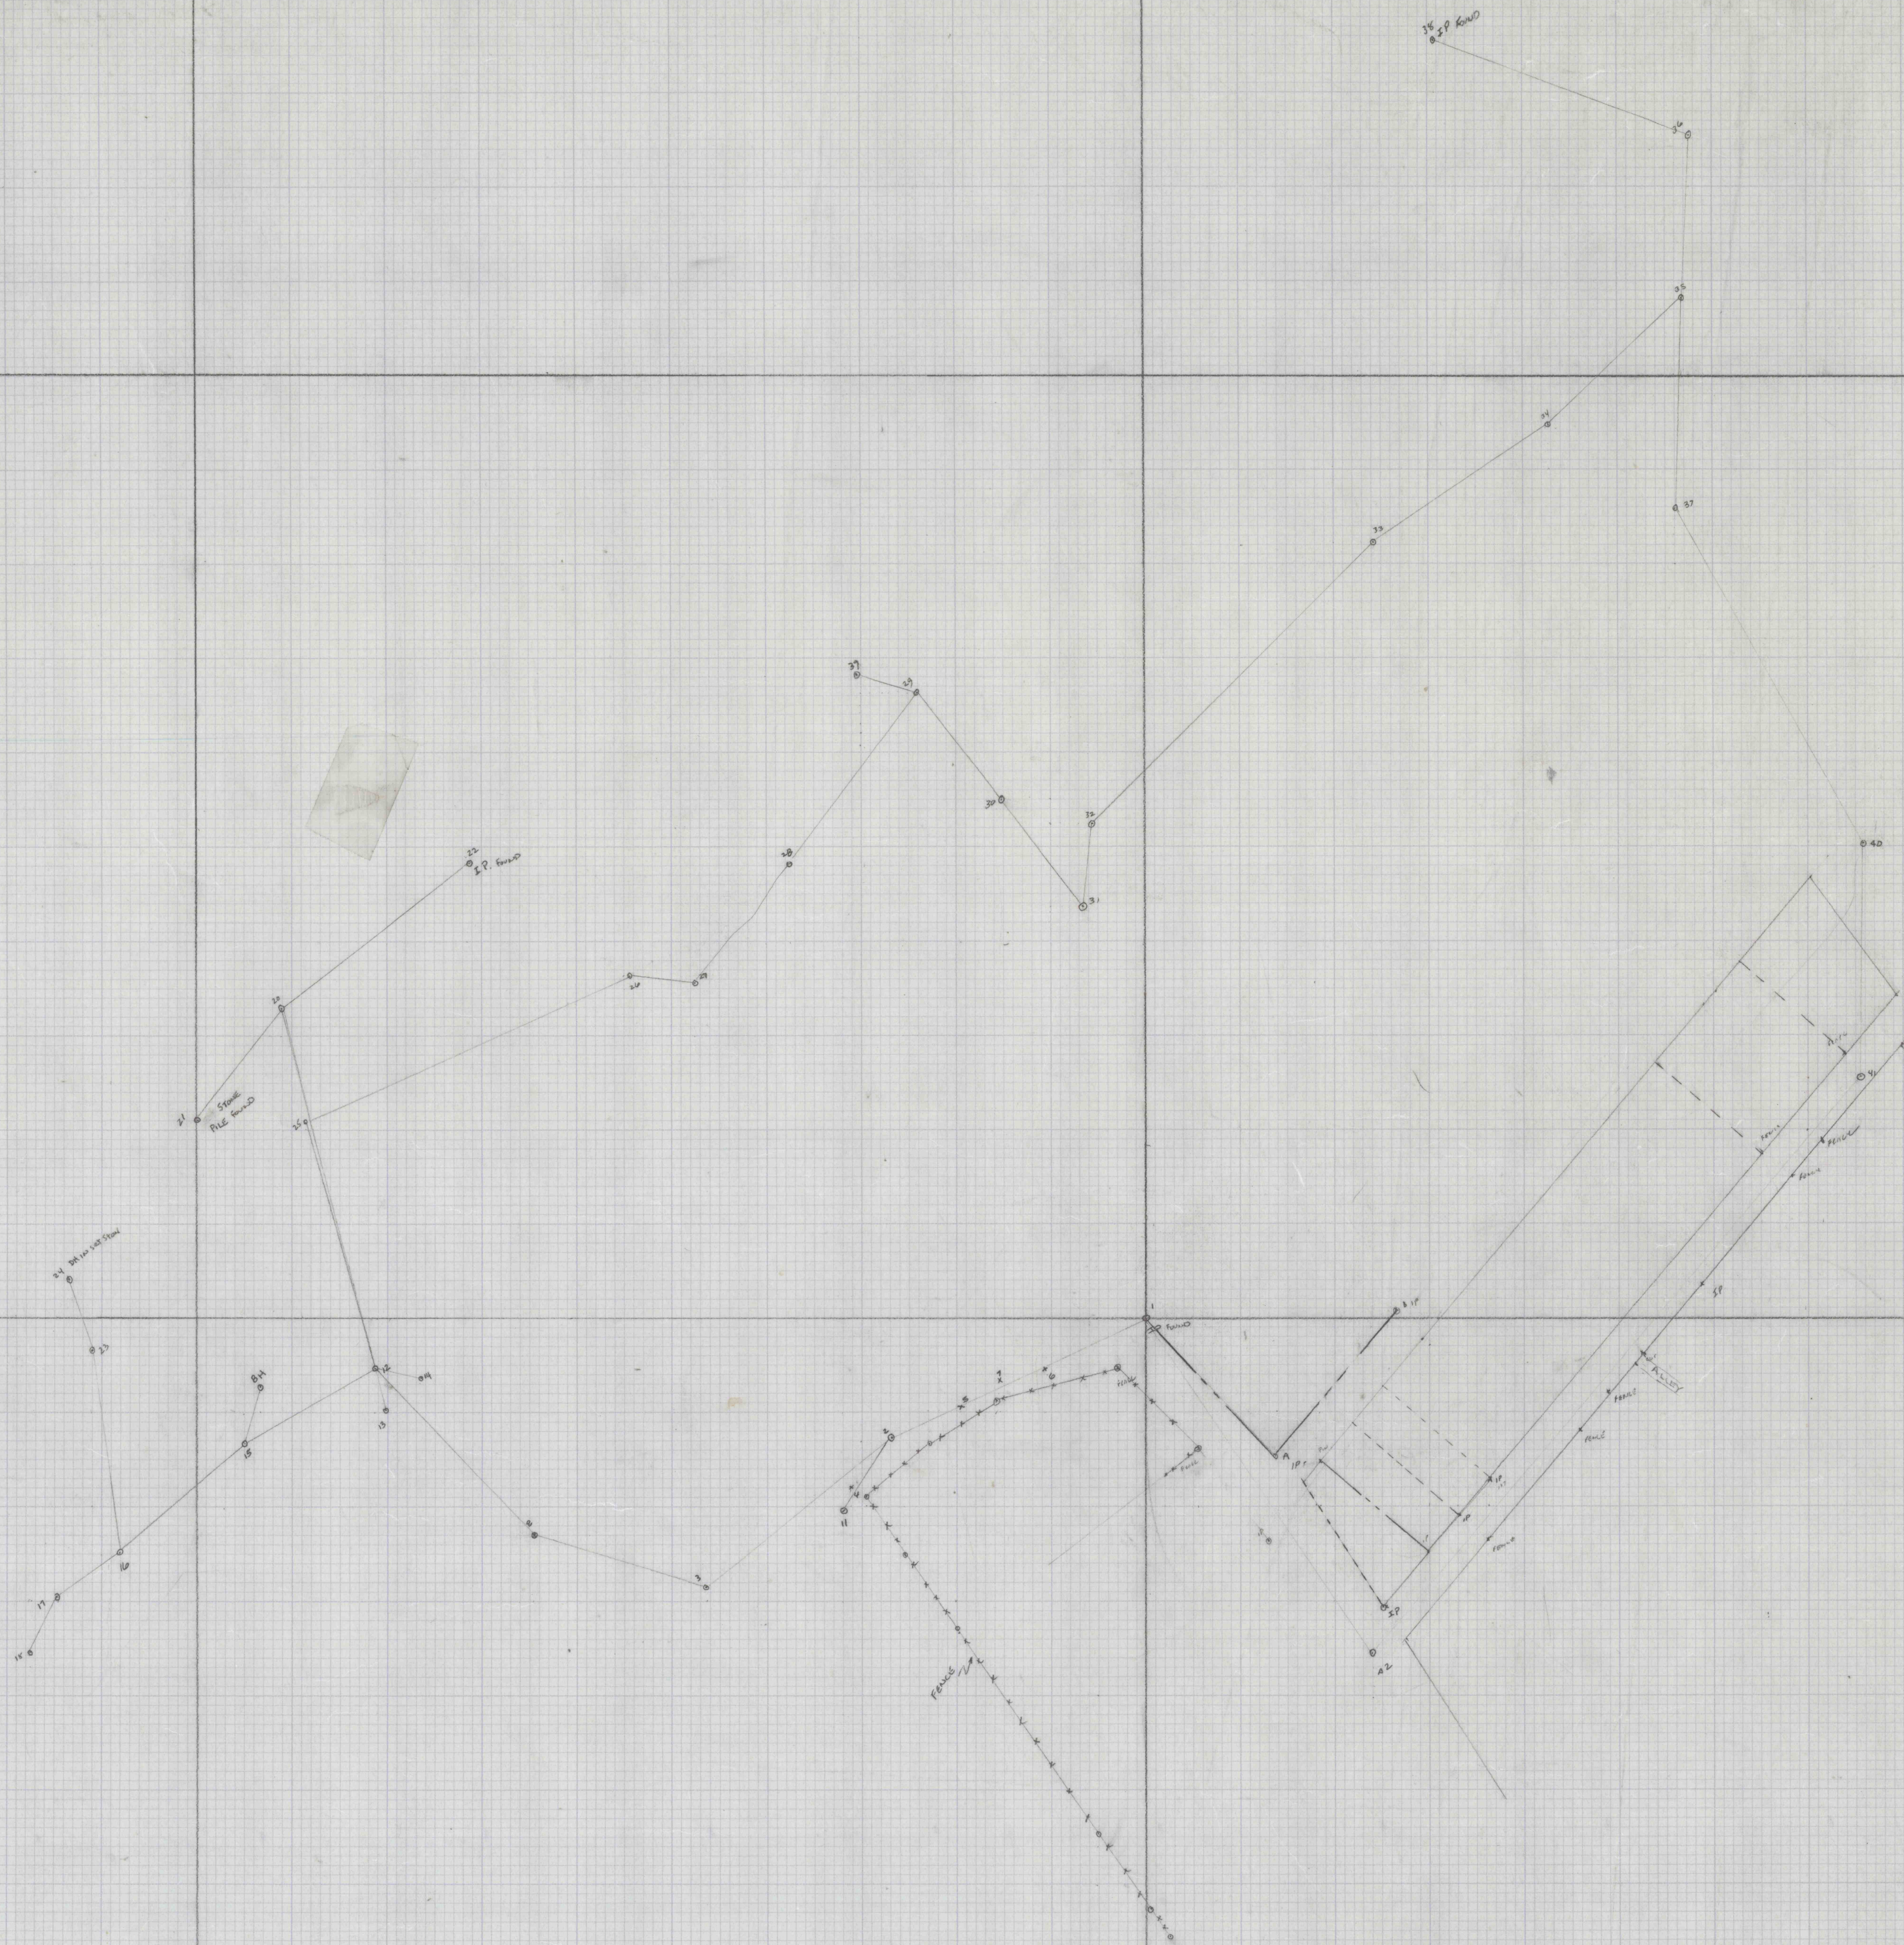

N 10000

E 11000

E 10000