



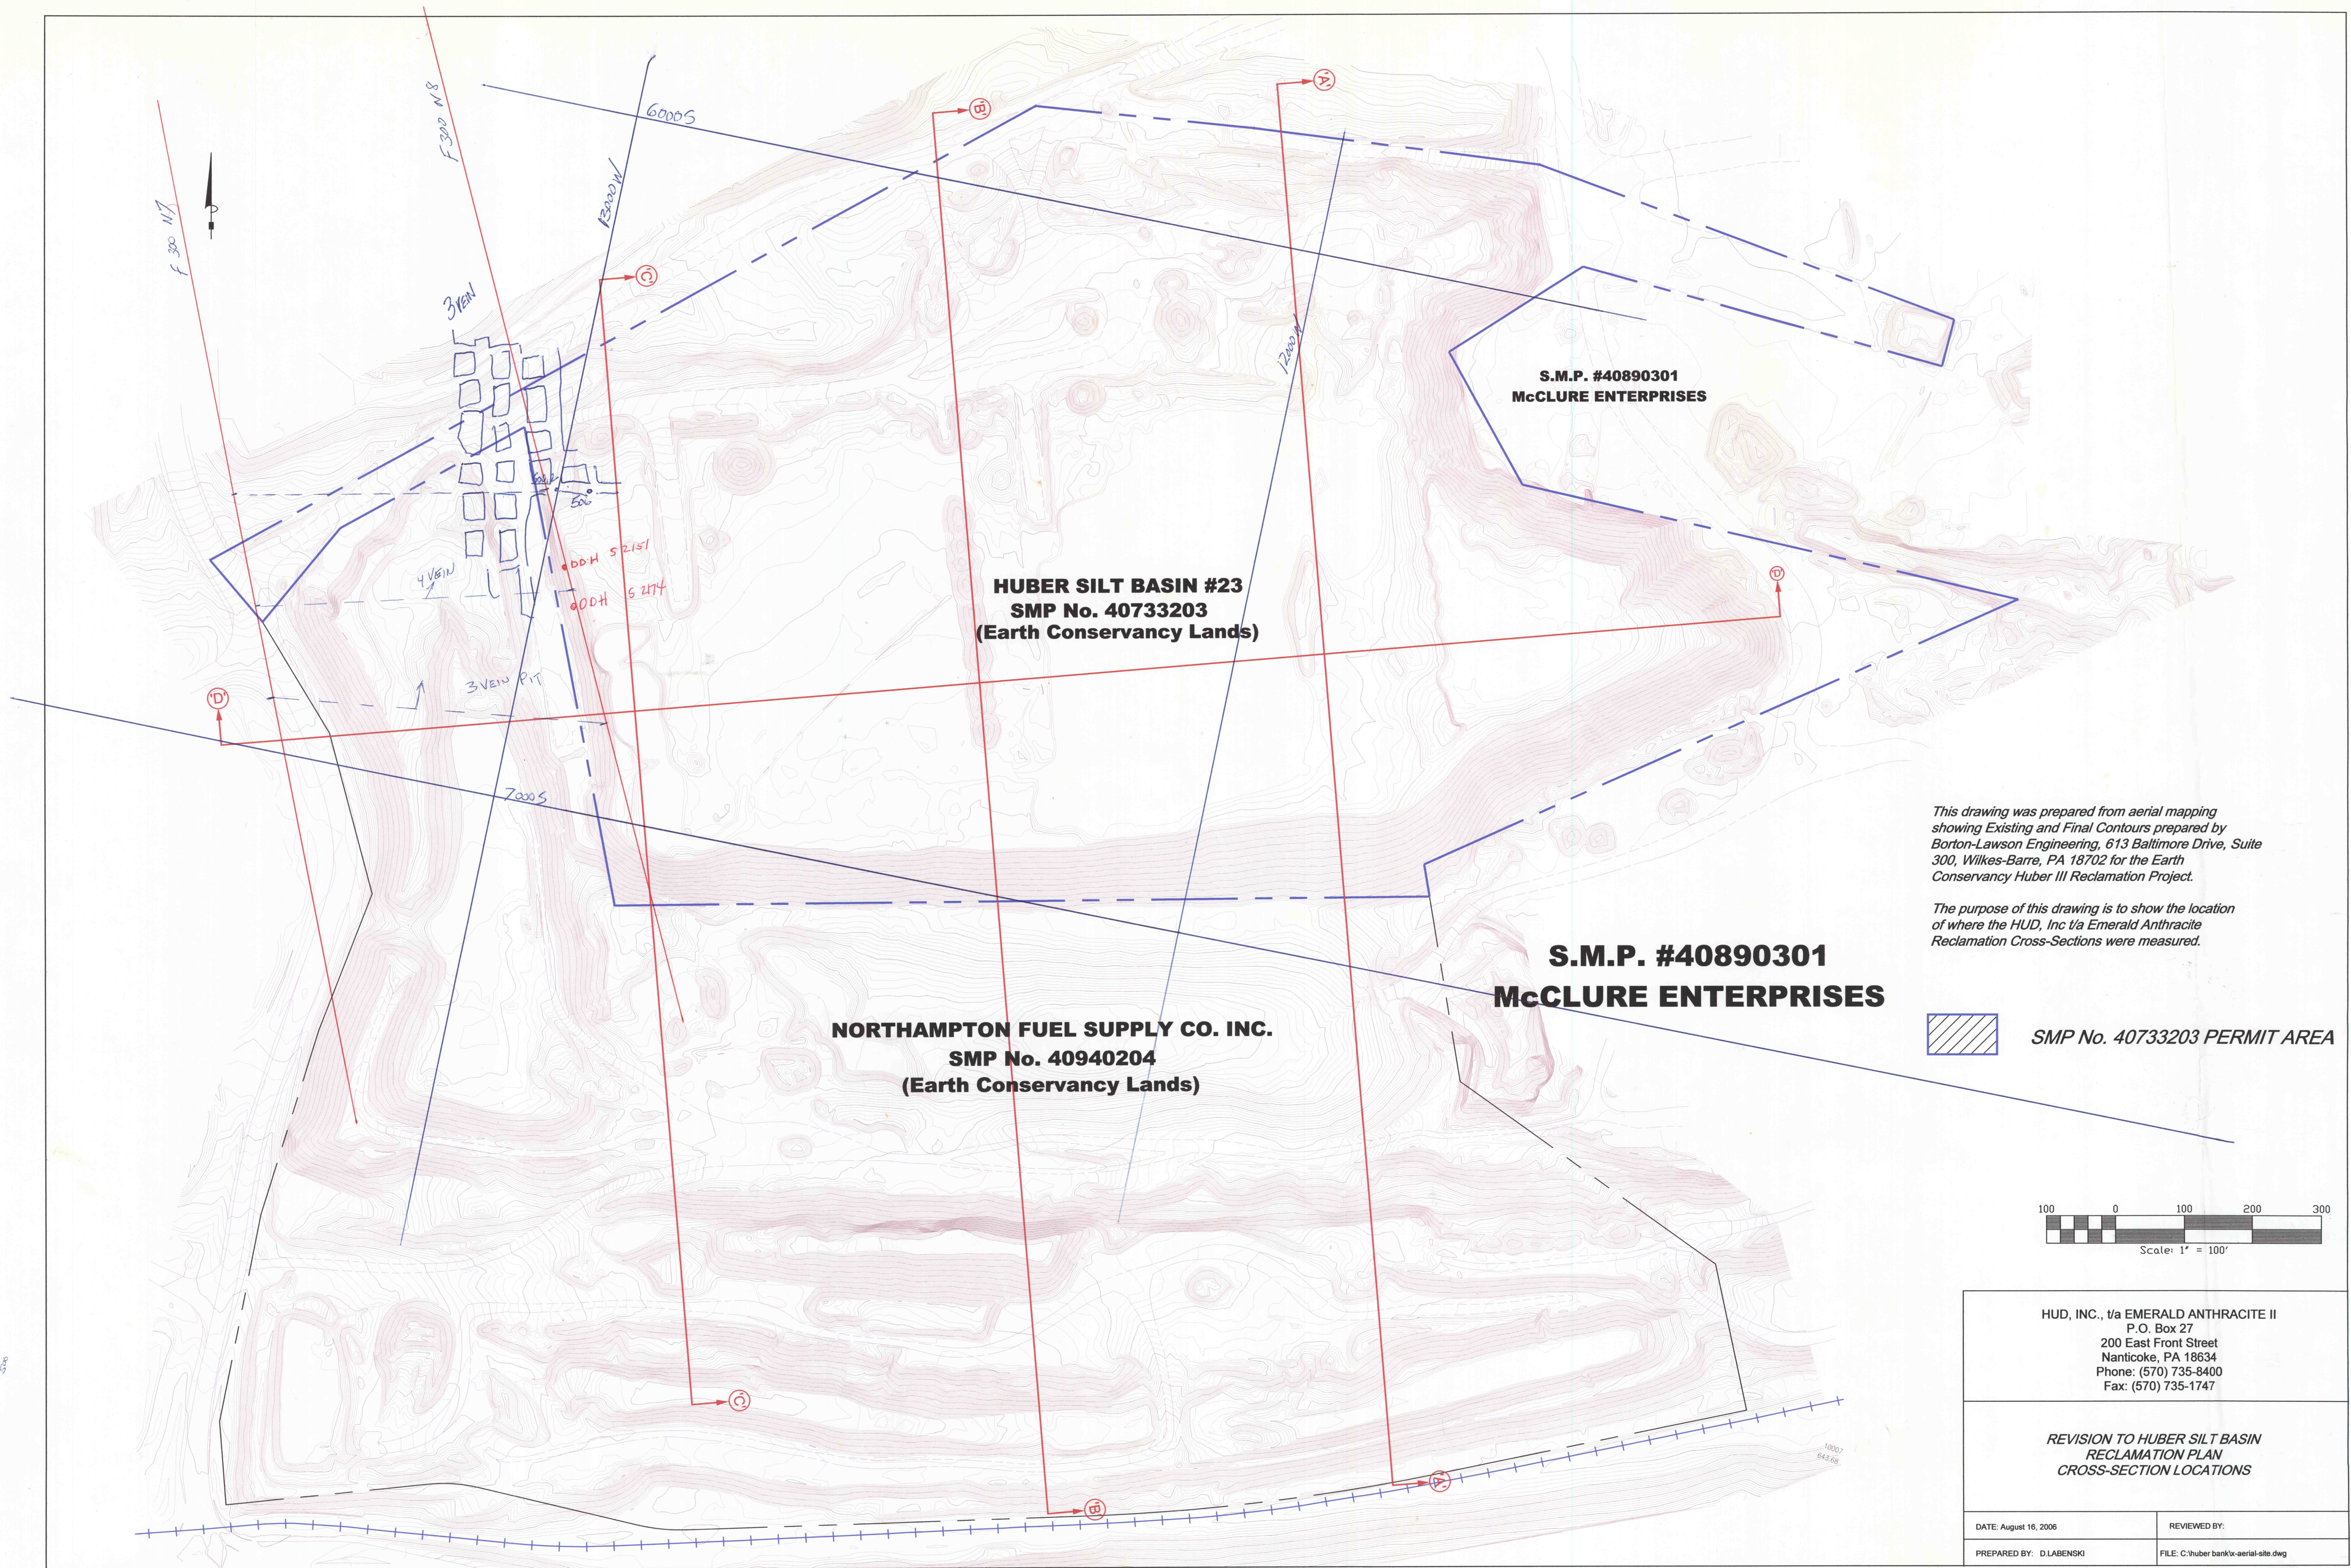


This drawing was prepared from aerial mapping showing Existing and Final Contours prepared by Borton-Lawson Engineering, 613 Baltimore Drive, Suite 300, Wilkes-Barre, PA 18702 for the Earth Conservancy Huber III Reclamation Project.

The purpose of this drawing is to show the location of where the HUD, Inc t/a Emerald Anthracite Reclamation Cross-Sections were measured.

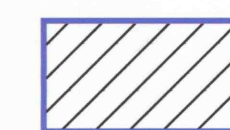

SMP No. 40733203 PERMIT AREA

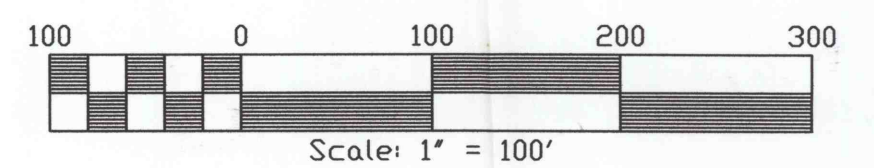

HUD, INC., t/a EMERALD ANTHRACITE II
P.O. Box 27
200 East Front Street
Nanticoke, PA 18634
Phone: (570) 735-8400
Fax: (570) 735-1747

REVISION TO HUBER SILT BASIN
RECLAMATION PLAN
CROSS-SECTION LOCATIONS

DATE: August 16, 2006	REVIEWED BY:
PREPARED BY: D.LABENSKI	FILE: C:\huber bank\k-aerial-site.dwg