


No 4 VEIN

Pillars tinted red
to be left intact to
support the Sugar Notch Cross Road

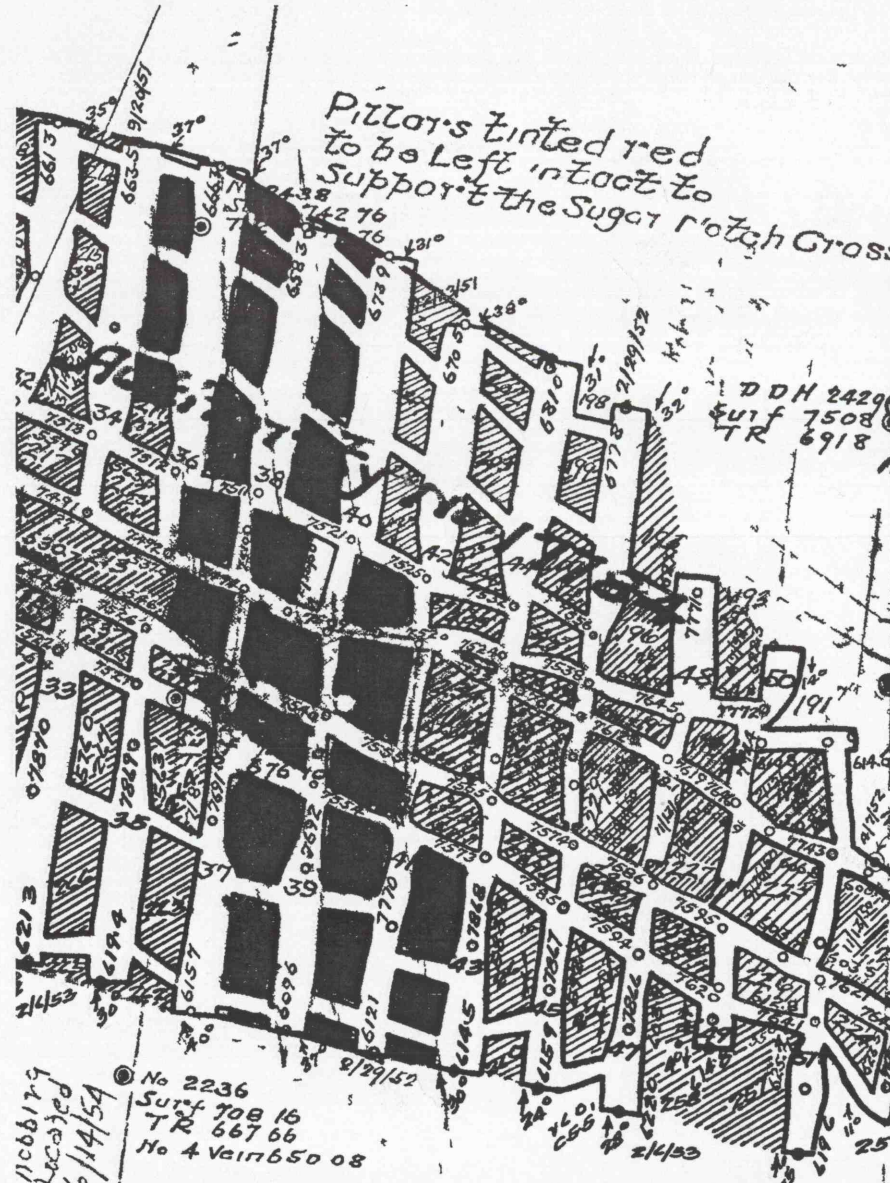

DDH 2429
Surf 7508
TR 6918
No 3 Vein 59990

DDH S-2161
Surf 73596
TR 68438
No 3 Vein 51680

DDH No 2440
Surface 72878
Top Rock 67078

DDH No S-2150
Surface 72234
Top Rock 67584
No 4 Vein 60234

DDH No S-2158
Surf 72612
TR 68562
No 4 Vein 62337

DDH No S-2144
Surf 71778
TR 67878
No 4 Vein 58478

DDH No S-2162
Surface 70598
Top Rock 67298
No 4 Vein 65148

C 3-6

DDH No S-2149
Surface 69768
Top of No 4 Vein 66468

No 2424
Surf 69664
TR 67564

DDH S-2177
Surf 68987
TR 67387
No 3 Vein 60587

DDH No S-2151
Surf 68717
TR 68567
No 4 Vein 64817
C 3 2

No 2236
Surf 70816
TR 66766
No 4 Vein 65008

5000'S

W 13000

6883
WIND