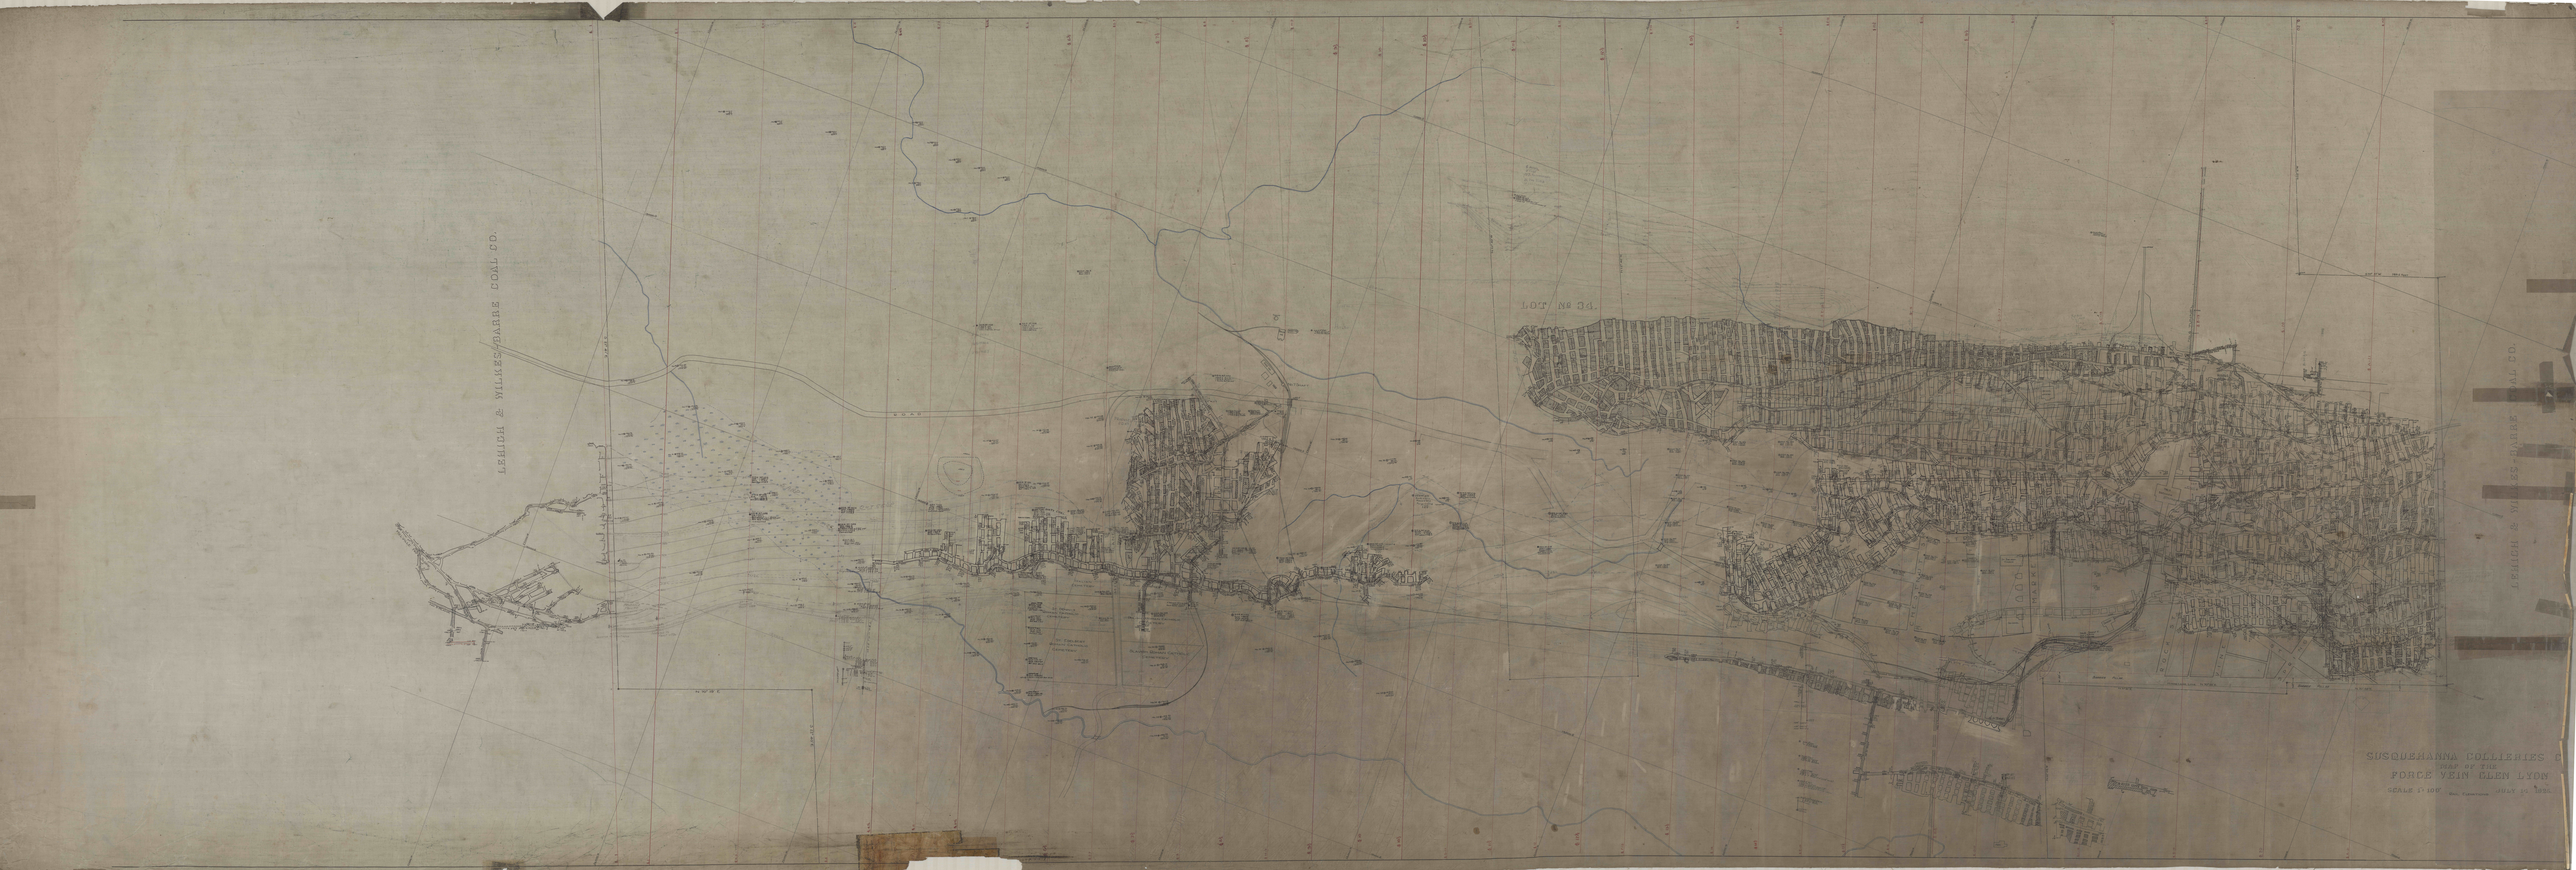

LEHIGH & WILKES-BARRE COAL CO.
LOT № 34.
SUSQUEHANNA COLLIERIES
FORCE VEIN GLEN LYON