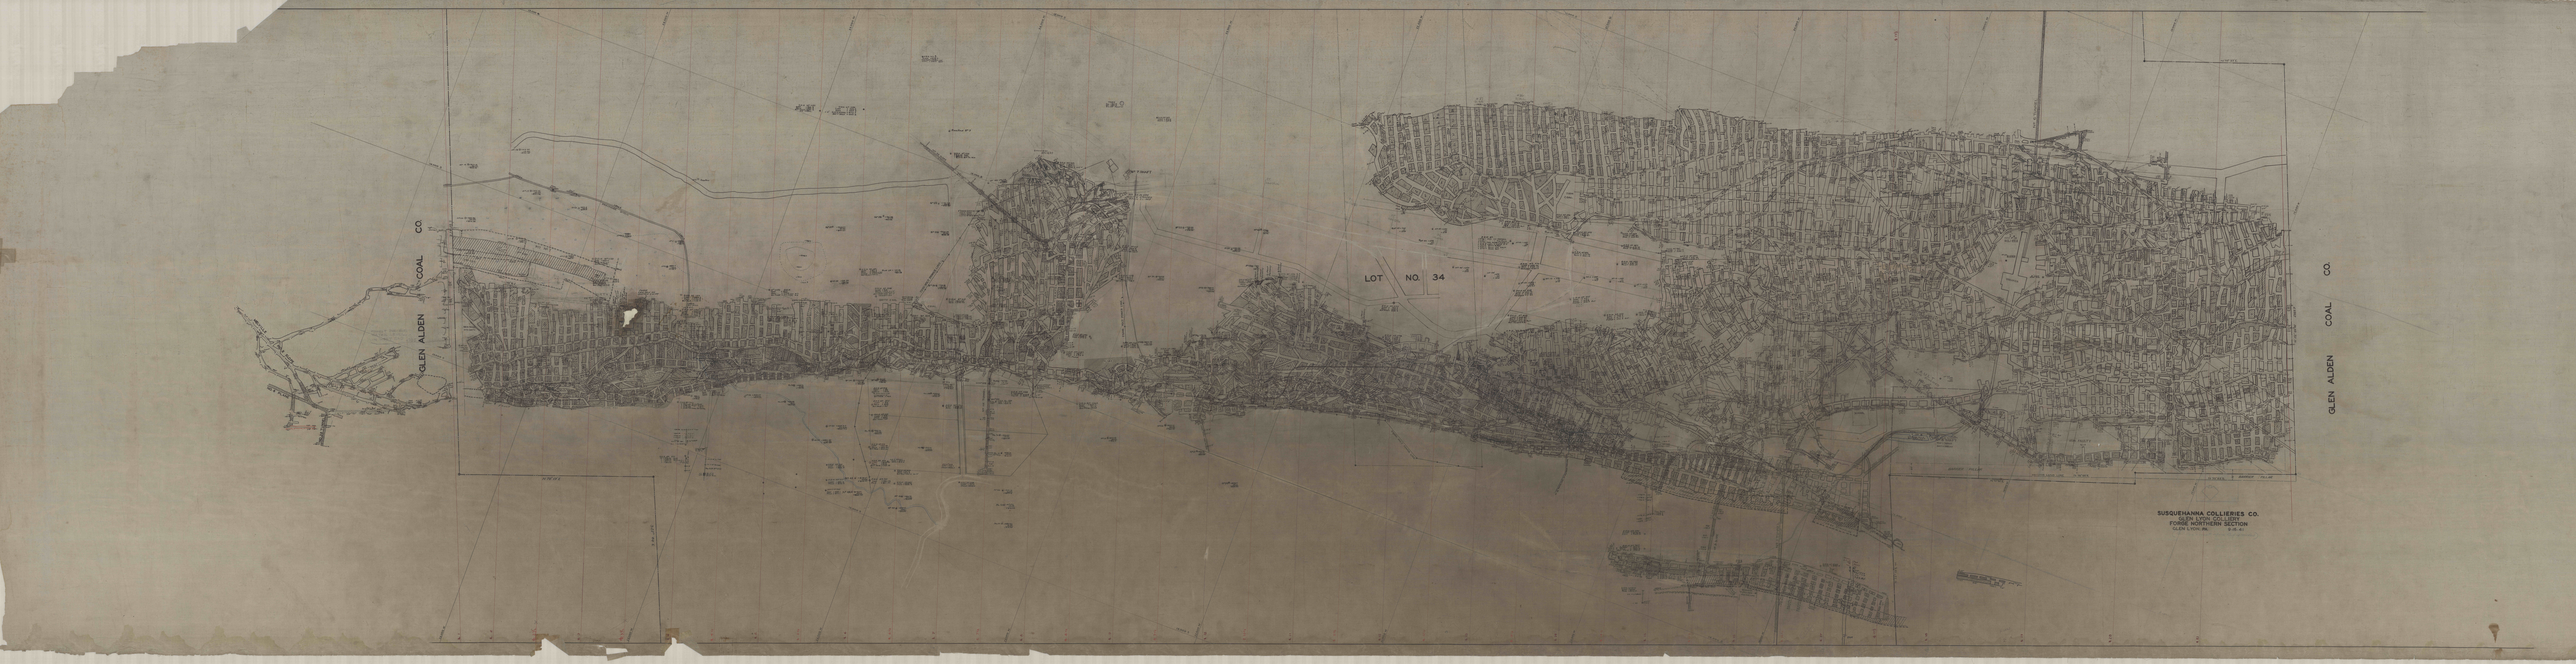

GLEN ALDEN COAL CO.
LOT NO. 34
GLEN ALDEN COAL CO.
SUSQUEHANNA COLLIERIES CO.
FORGE NORTHERN SECTION