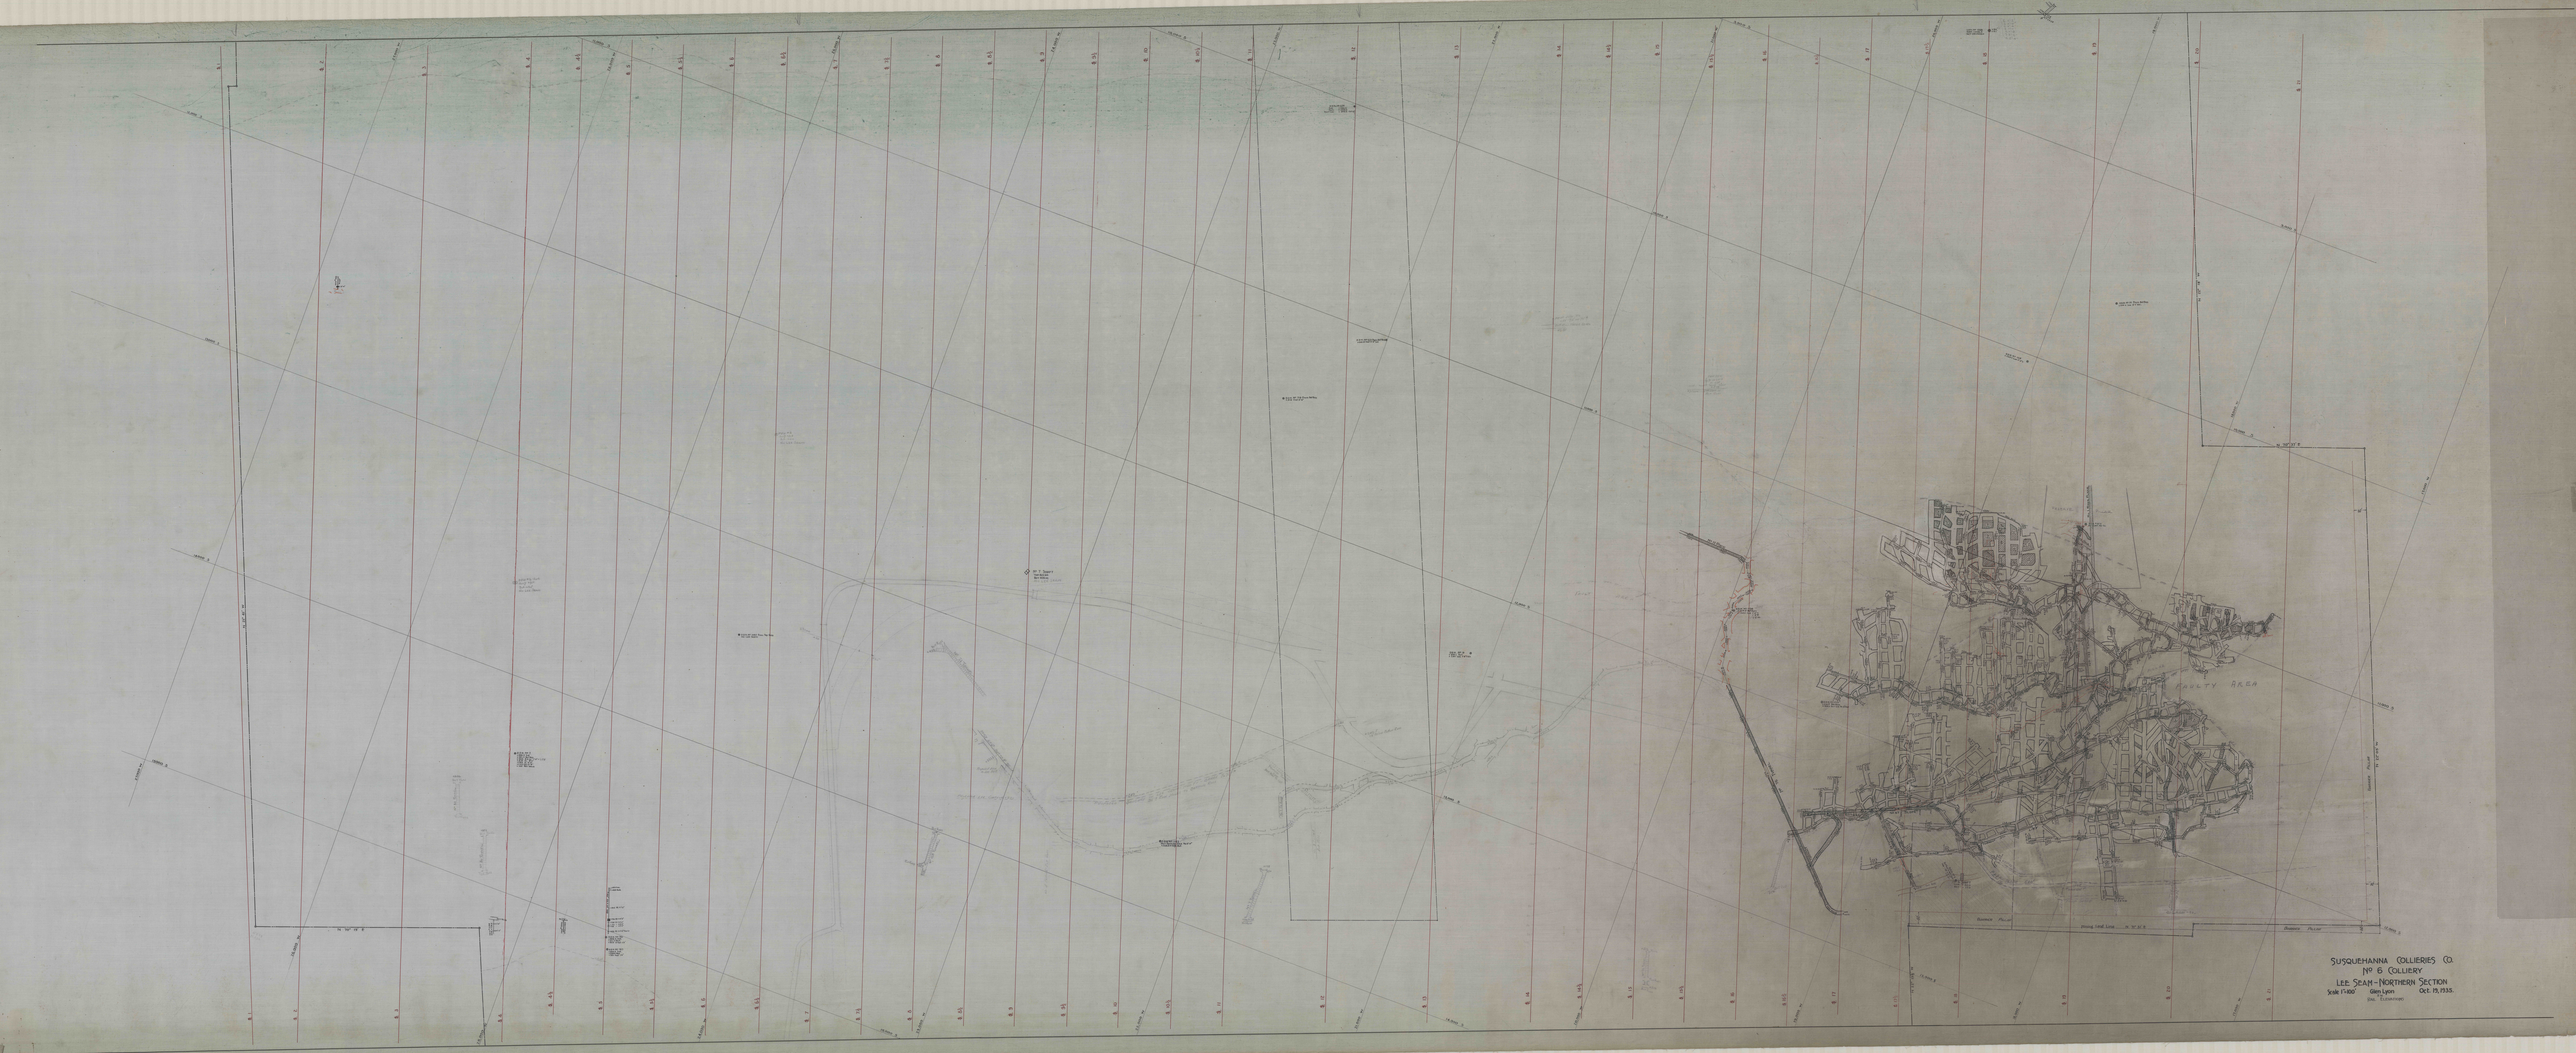

SUSQUEHANNA COLLIERIES CO.
No 6 COLLIERY
LEE SEAM - NORTHERN SECTION
Scale 1"=100'
Glen Lyon
Oct. 15, 1935.