


\$ thru No 5 CHUTE EAST OF No 153 TUNNEL

SCALE 1" = 20'

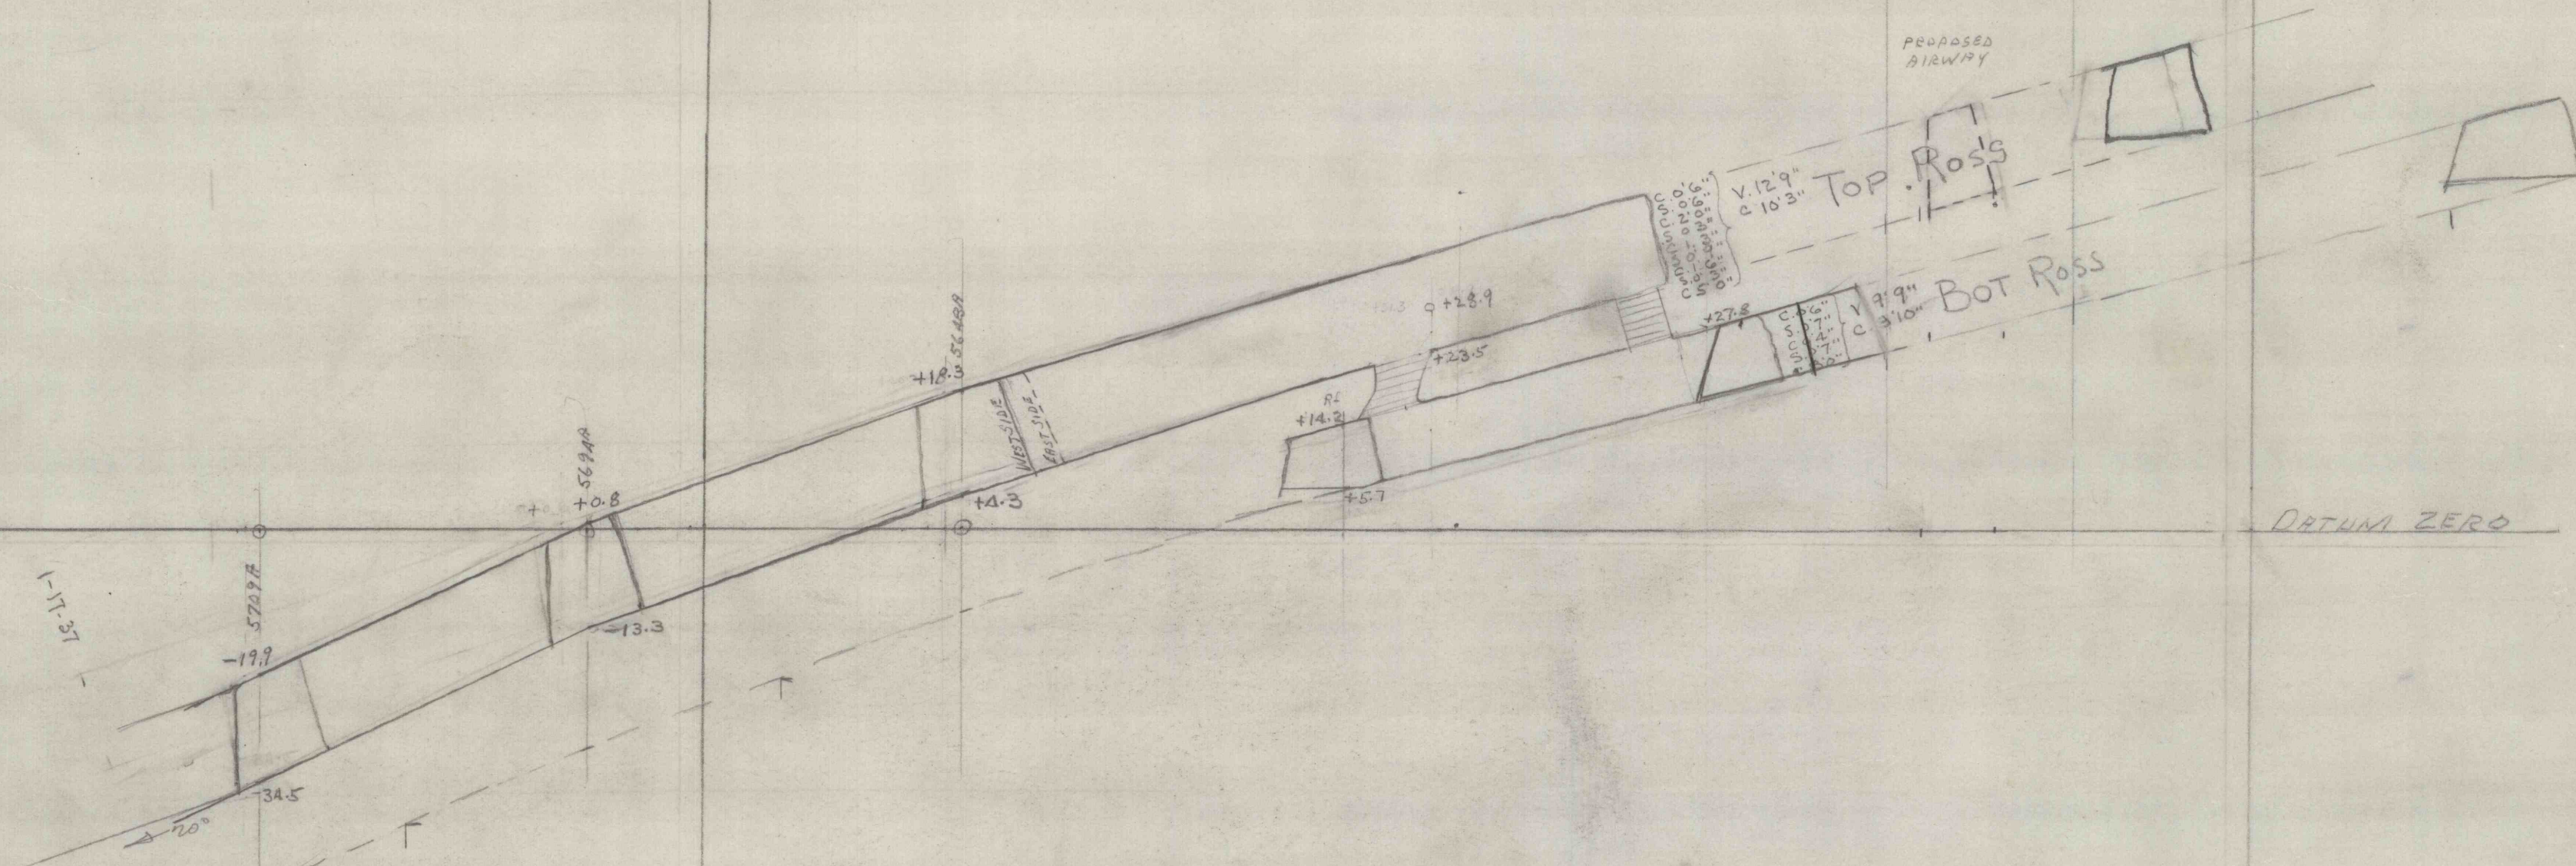

BARRIER PILLAR

512 200

512 000

511 800

FIP0-002