


+100

\$ thru No. 1 CHUTE WEST OF NO. 153 TUNNEL

SCALE 1" = 20'

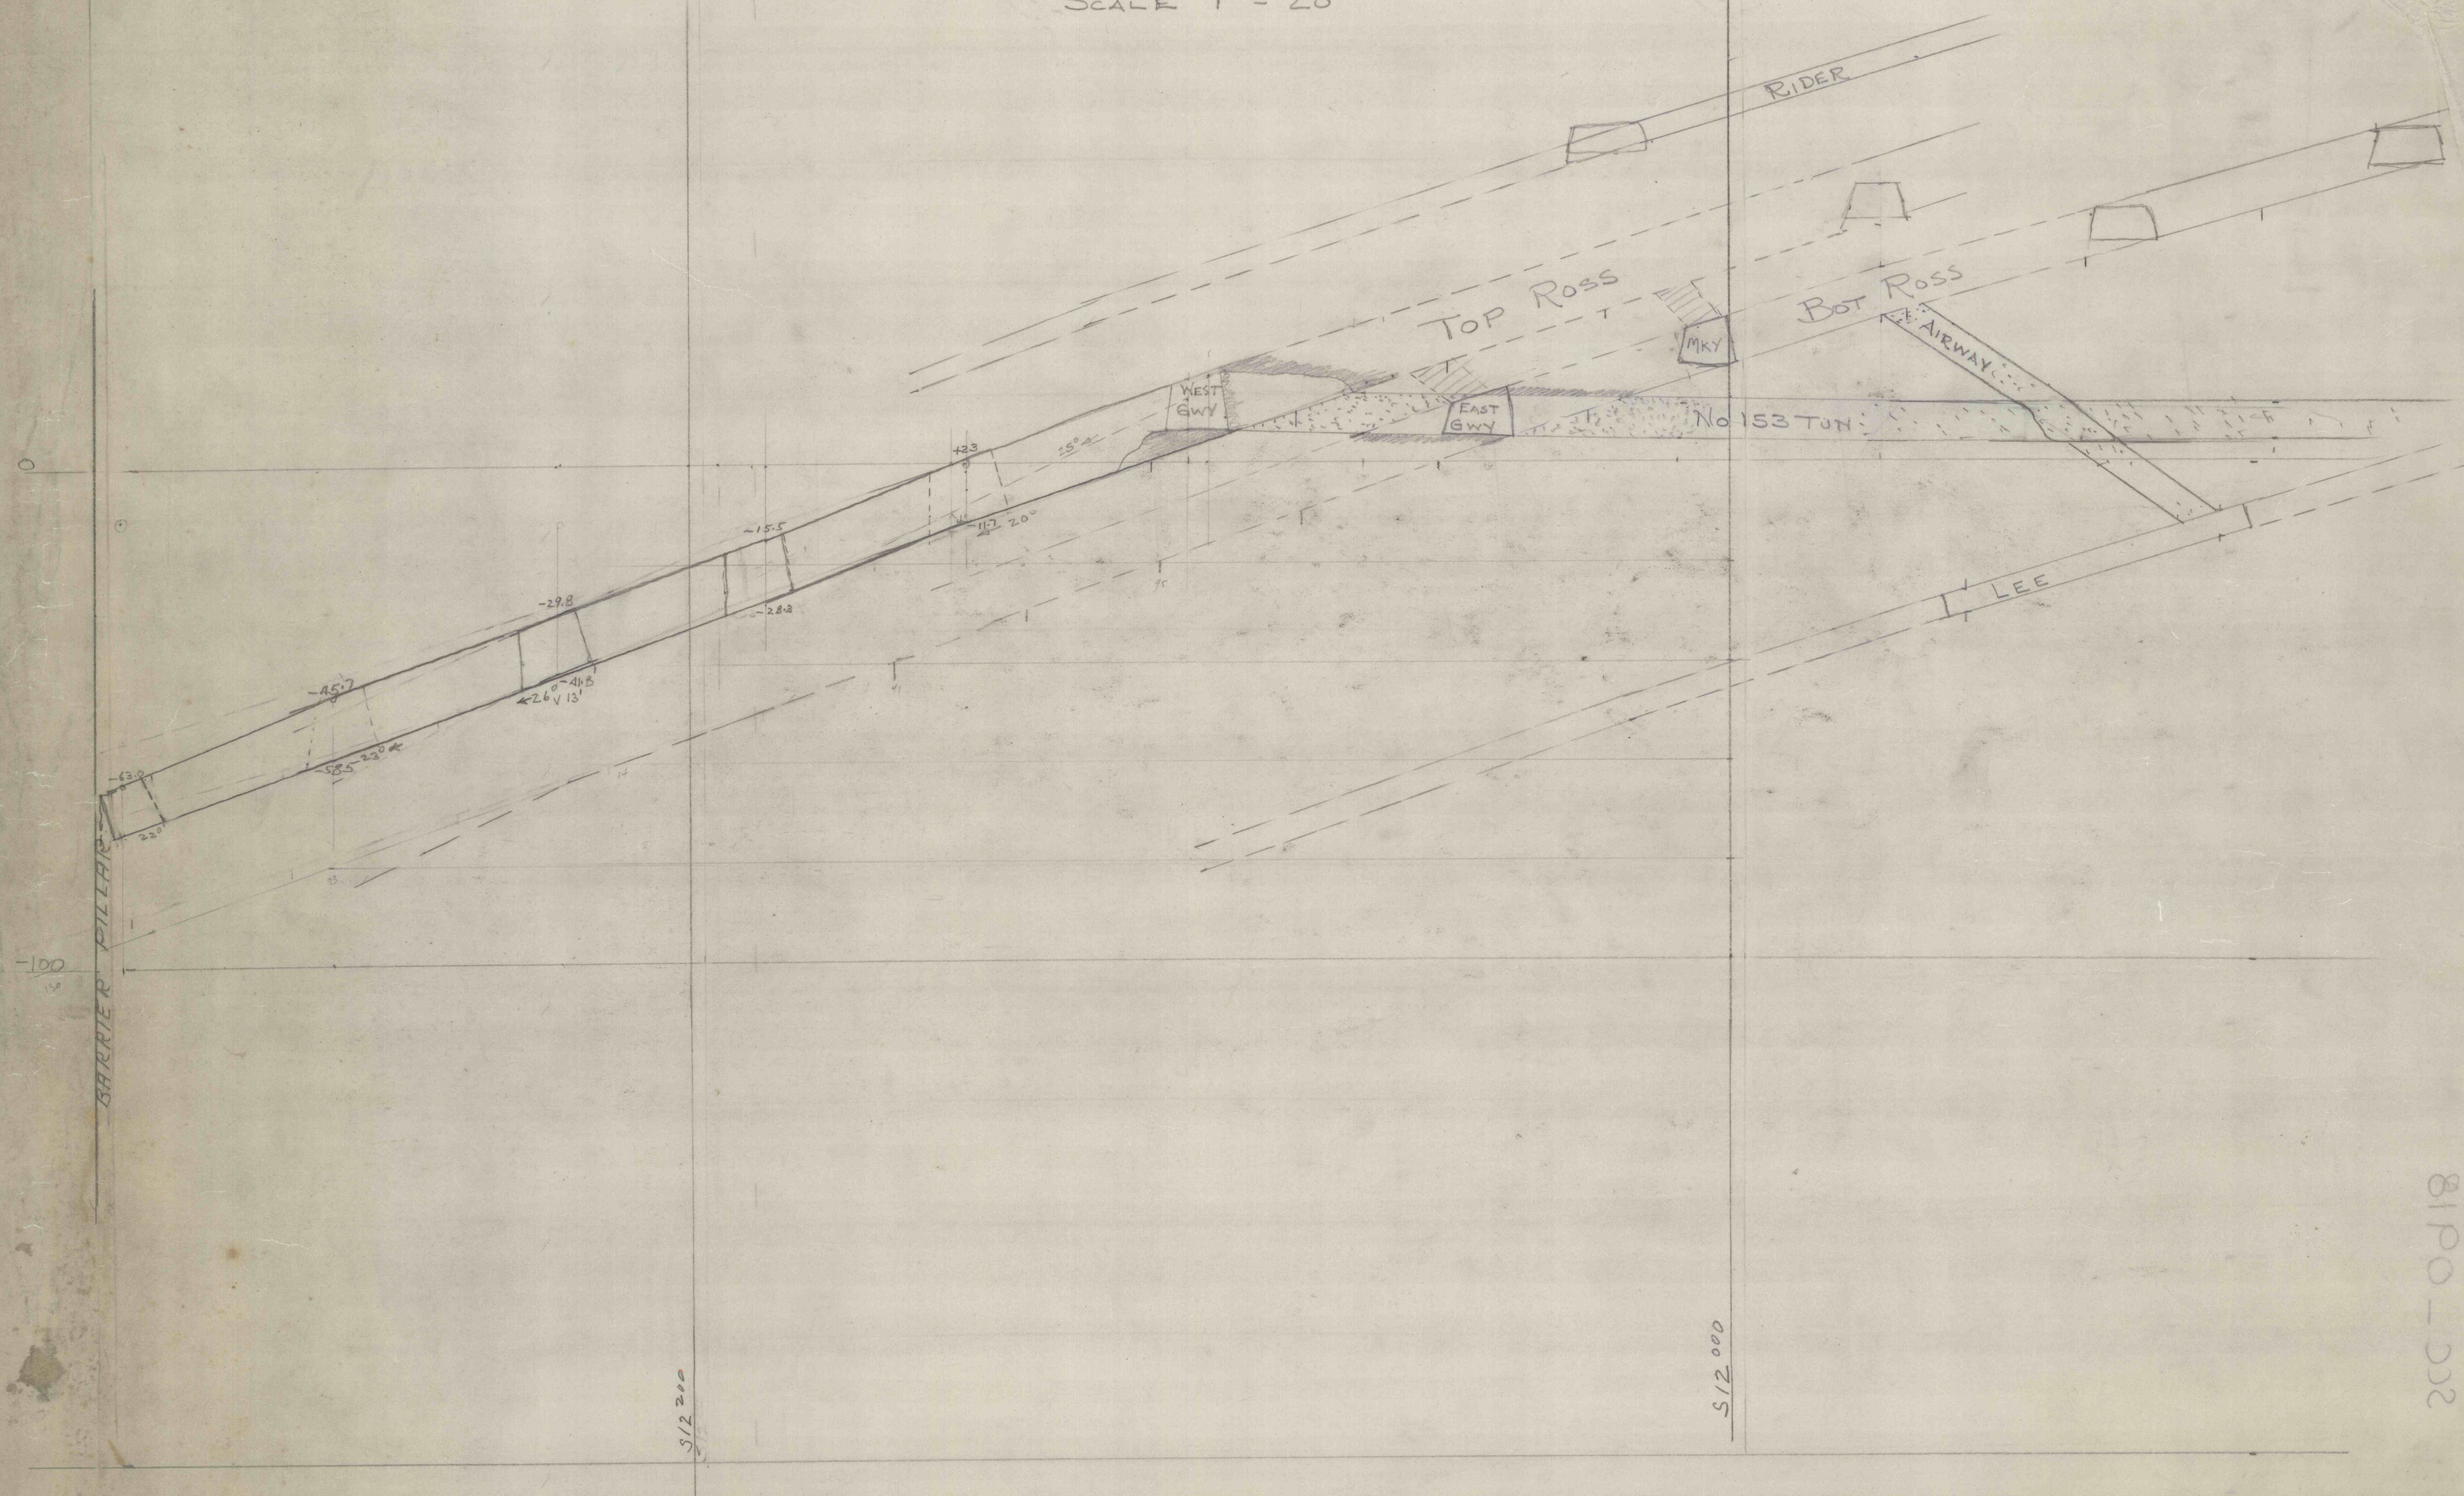

81PO-032