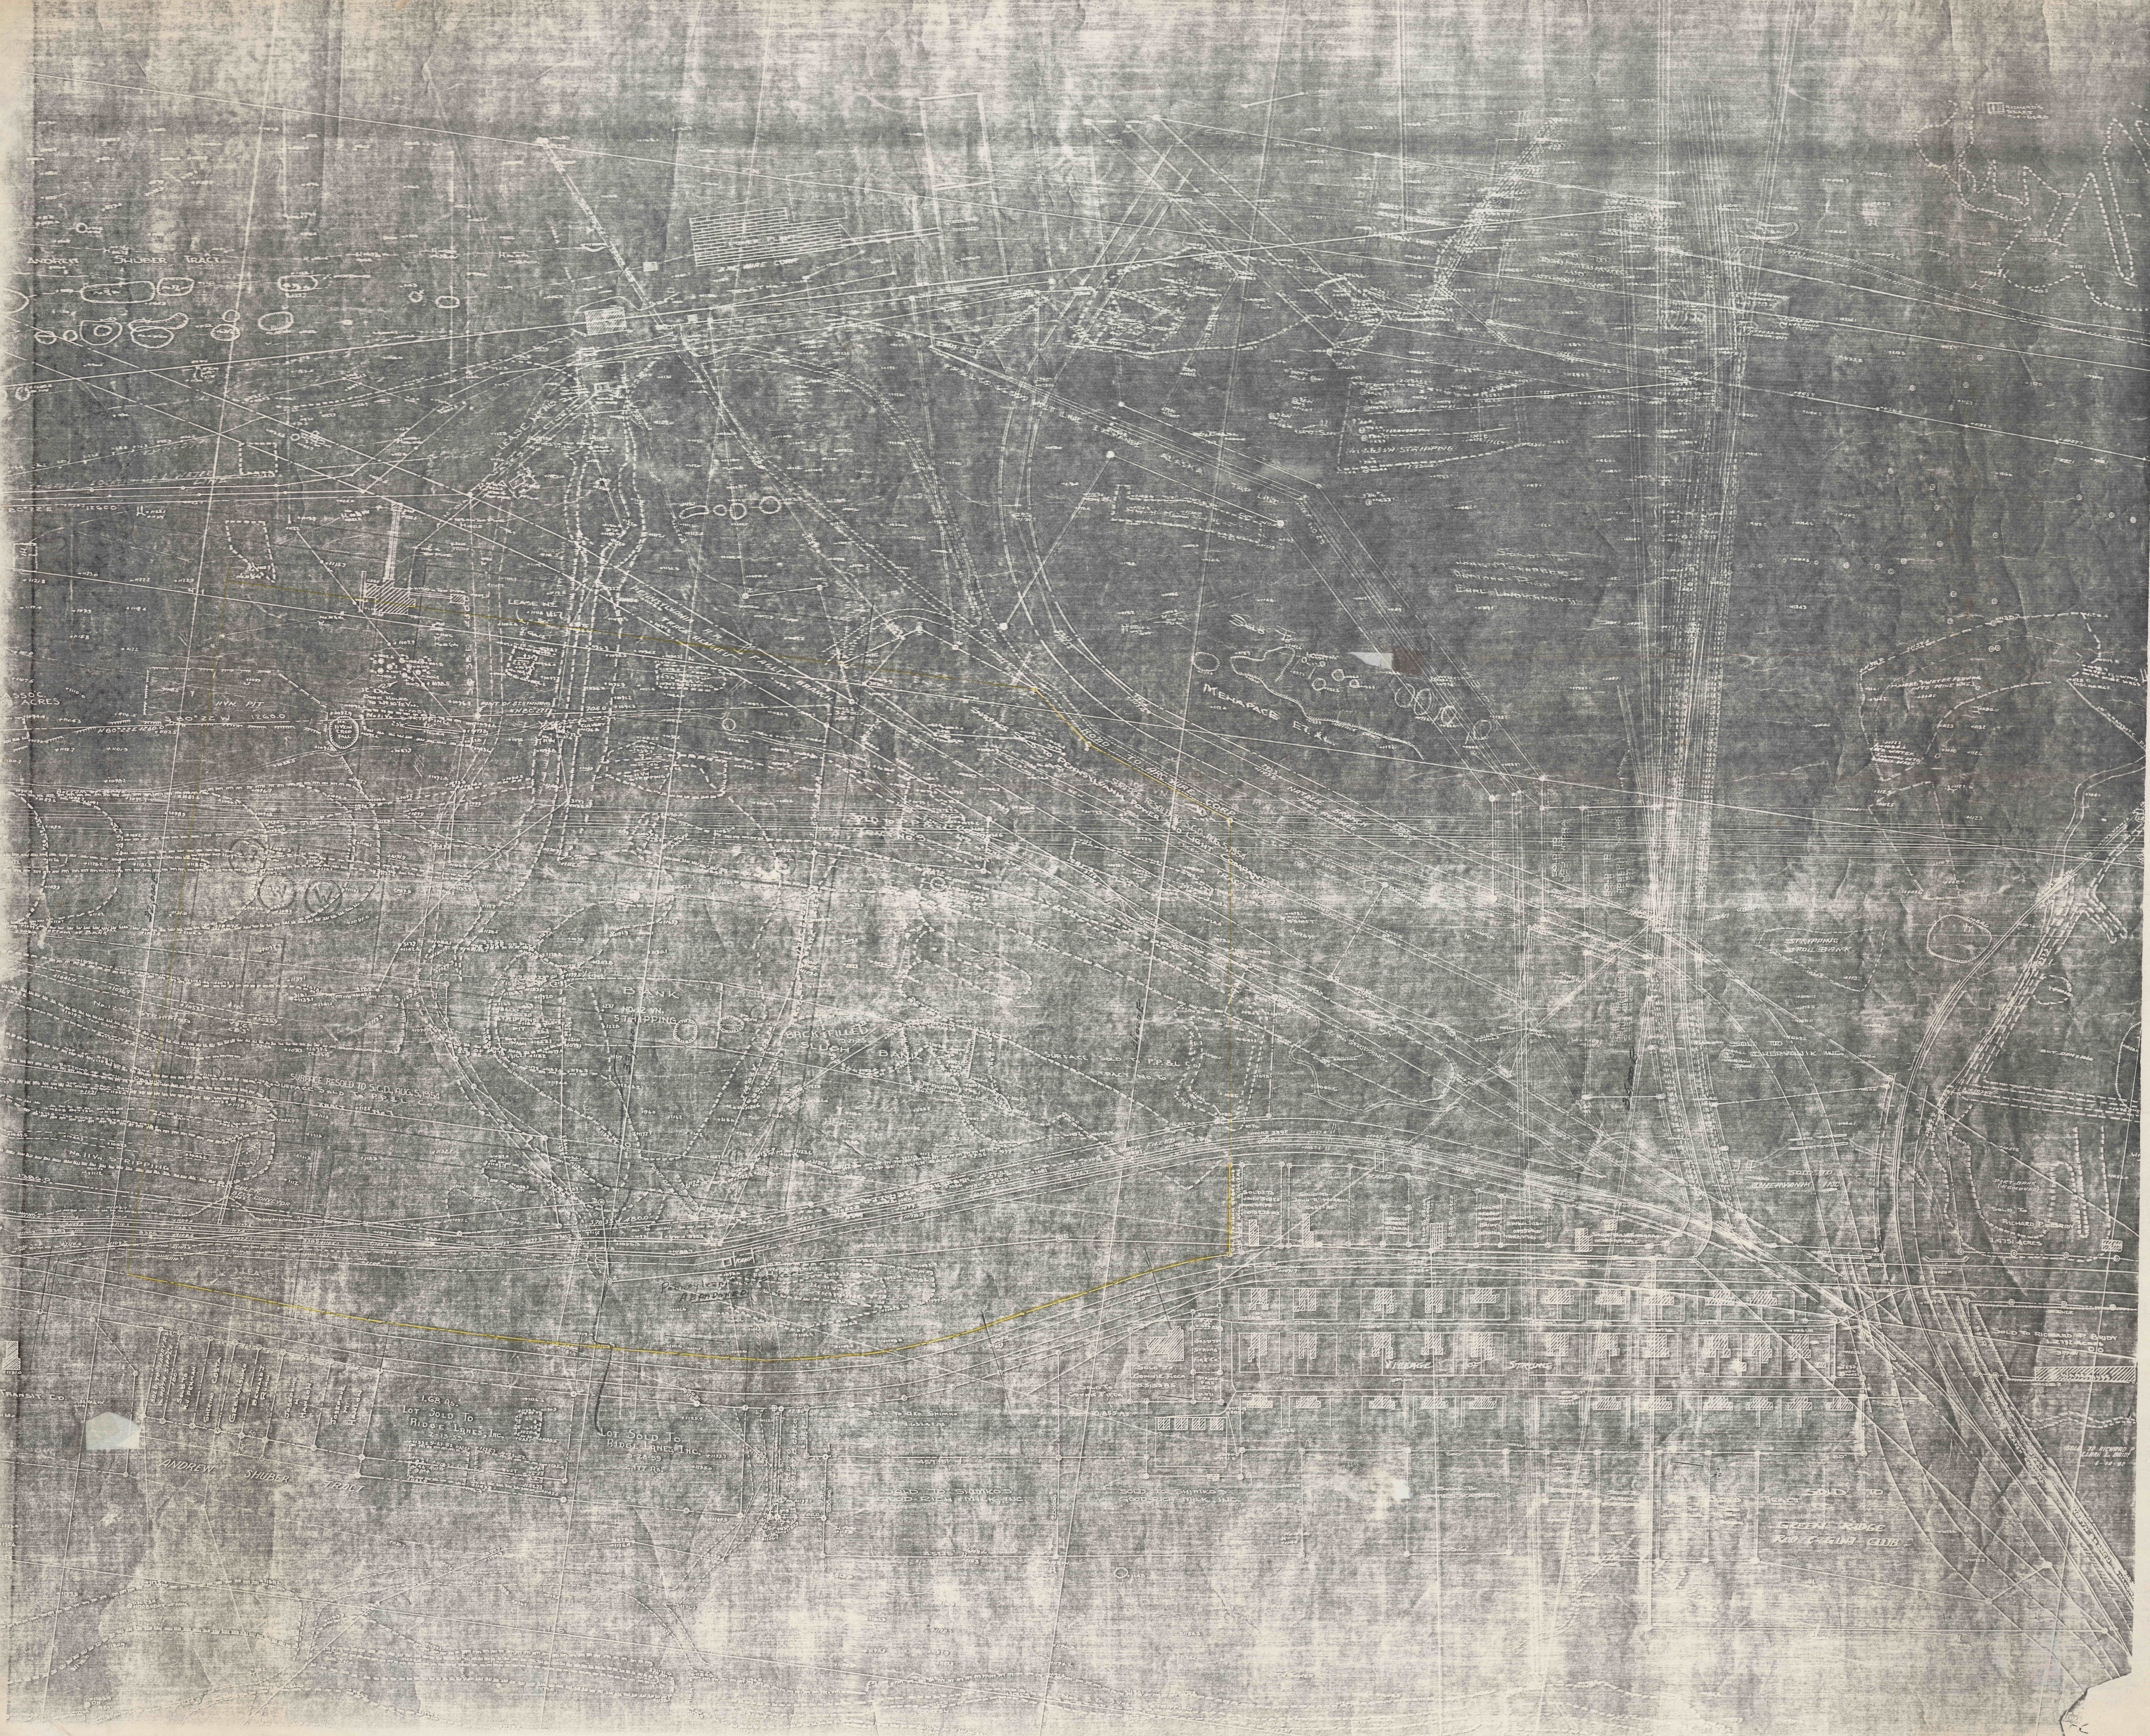
ANDREW SHUBER TRACT
LEASE No 116
LEASE No 117
PENNSYLVANIA R.R.
TRACK REMOVED
FAGLEY BRANCH
11VN. PIT
No 11 VEIN CROP FALL
BORE HOLES
POINT OF BEGINNING
S 80°22' W 1260.0
N 80°22' E 1260.0
CULVERT
BOTTOM OF BANK
ASSO'C.
ACRES
ALASKA TAP LINE
STRIPPING
SOLD TO
JOHN McGAHAGAN
ANTHONY PHIUS
EARL LINDERMUTH
MENAPACE ET. AL.
SURFACE OPEN
ROAD TO ARC WIRE CORP.
NATALIE BRANCH
TRACK REMOVED
SURFACE RESOLD TO S.C.D. AUG. 5, 1954
SOLD TO PENNSYLVANIA POWER AND LIGHT COMPANY
TRACT No. 5
BANK
No. 12 VN. STRIPPING
BACK FILLED 3-21-55
SLUSH BANK
SURFACE SOLD TO P.P.&L. CO.
TRACT No. 6
STRIPPING SPOIL BANK
SOLD TO CHERVANIK INC.
DIRT BANK (REMOVED)
SOLD TO RICHARD P. BRIDY 1.4751 ACRES
SOLD TO RICHARD P. BRIDY 1.2792 ACRES
BOT. DAM
Pennsylvania Breaker ABANDONED
SOLD TO HARRY & RUTH SIPPLE
SOLD TO R.J. PENMAN
SHERINO COSTA
GEO. WAISHKO
BERNARD J. RUAN
JOSEPHINE M. HANLON
JOSEPHINE M. HANLON
1.68 As.
LOT SOLD TO RIDGE LANES, INC. 2-13-59
LOT SOLD TO RIDGE LANES, INC. 9-28-59 2.177 As.
SOLD TO ROBERT D. GRECO
SOLD TO GEO. SHIMKO
TRANSIT CO.
SOLD TO CONNIE FICCA
SOLD TO CONNIE FICCA 0.5155 AS.
0.855 As.
STRONG FIRE CO.
SOLD TO STRONG FIRE CO.
STRONG FIRE CO. 0.011 As.
VILLAGE OF STRONG
SOLD TO SHIMKO & GOOD-RICH MILK, INC.
SOLD TO JAMES KASHER
SOLD TO GREEN RIDGE ROD & GUN CLUB
SOLD TO RICHARD P. & CLARA L. BRIDY 6-18-80
NORTH BRANCH