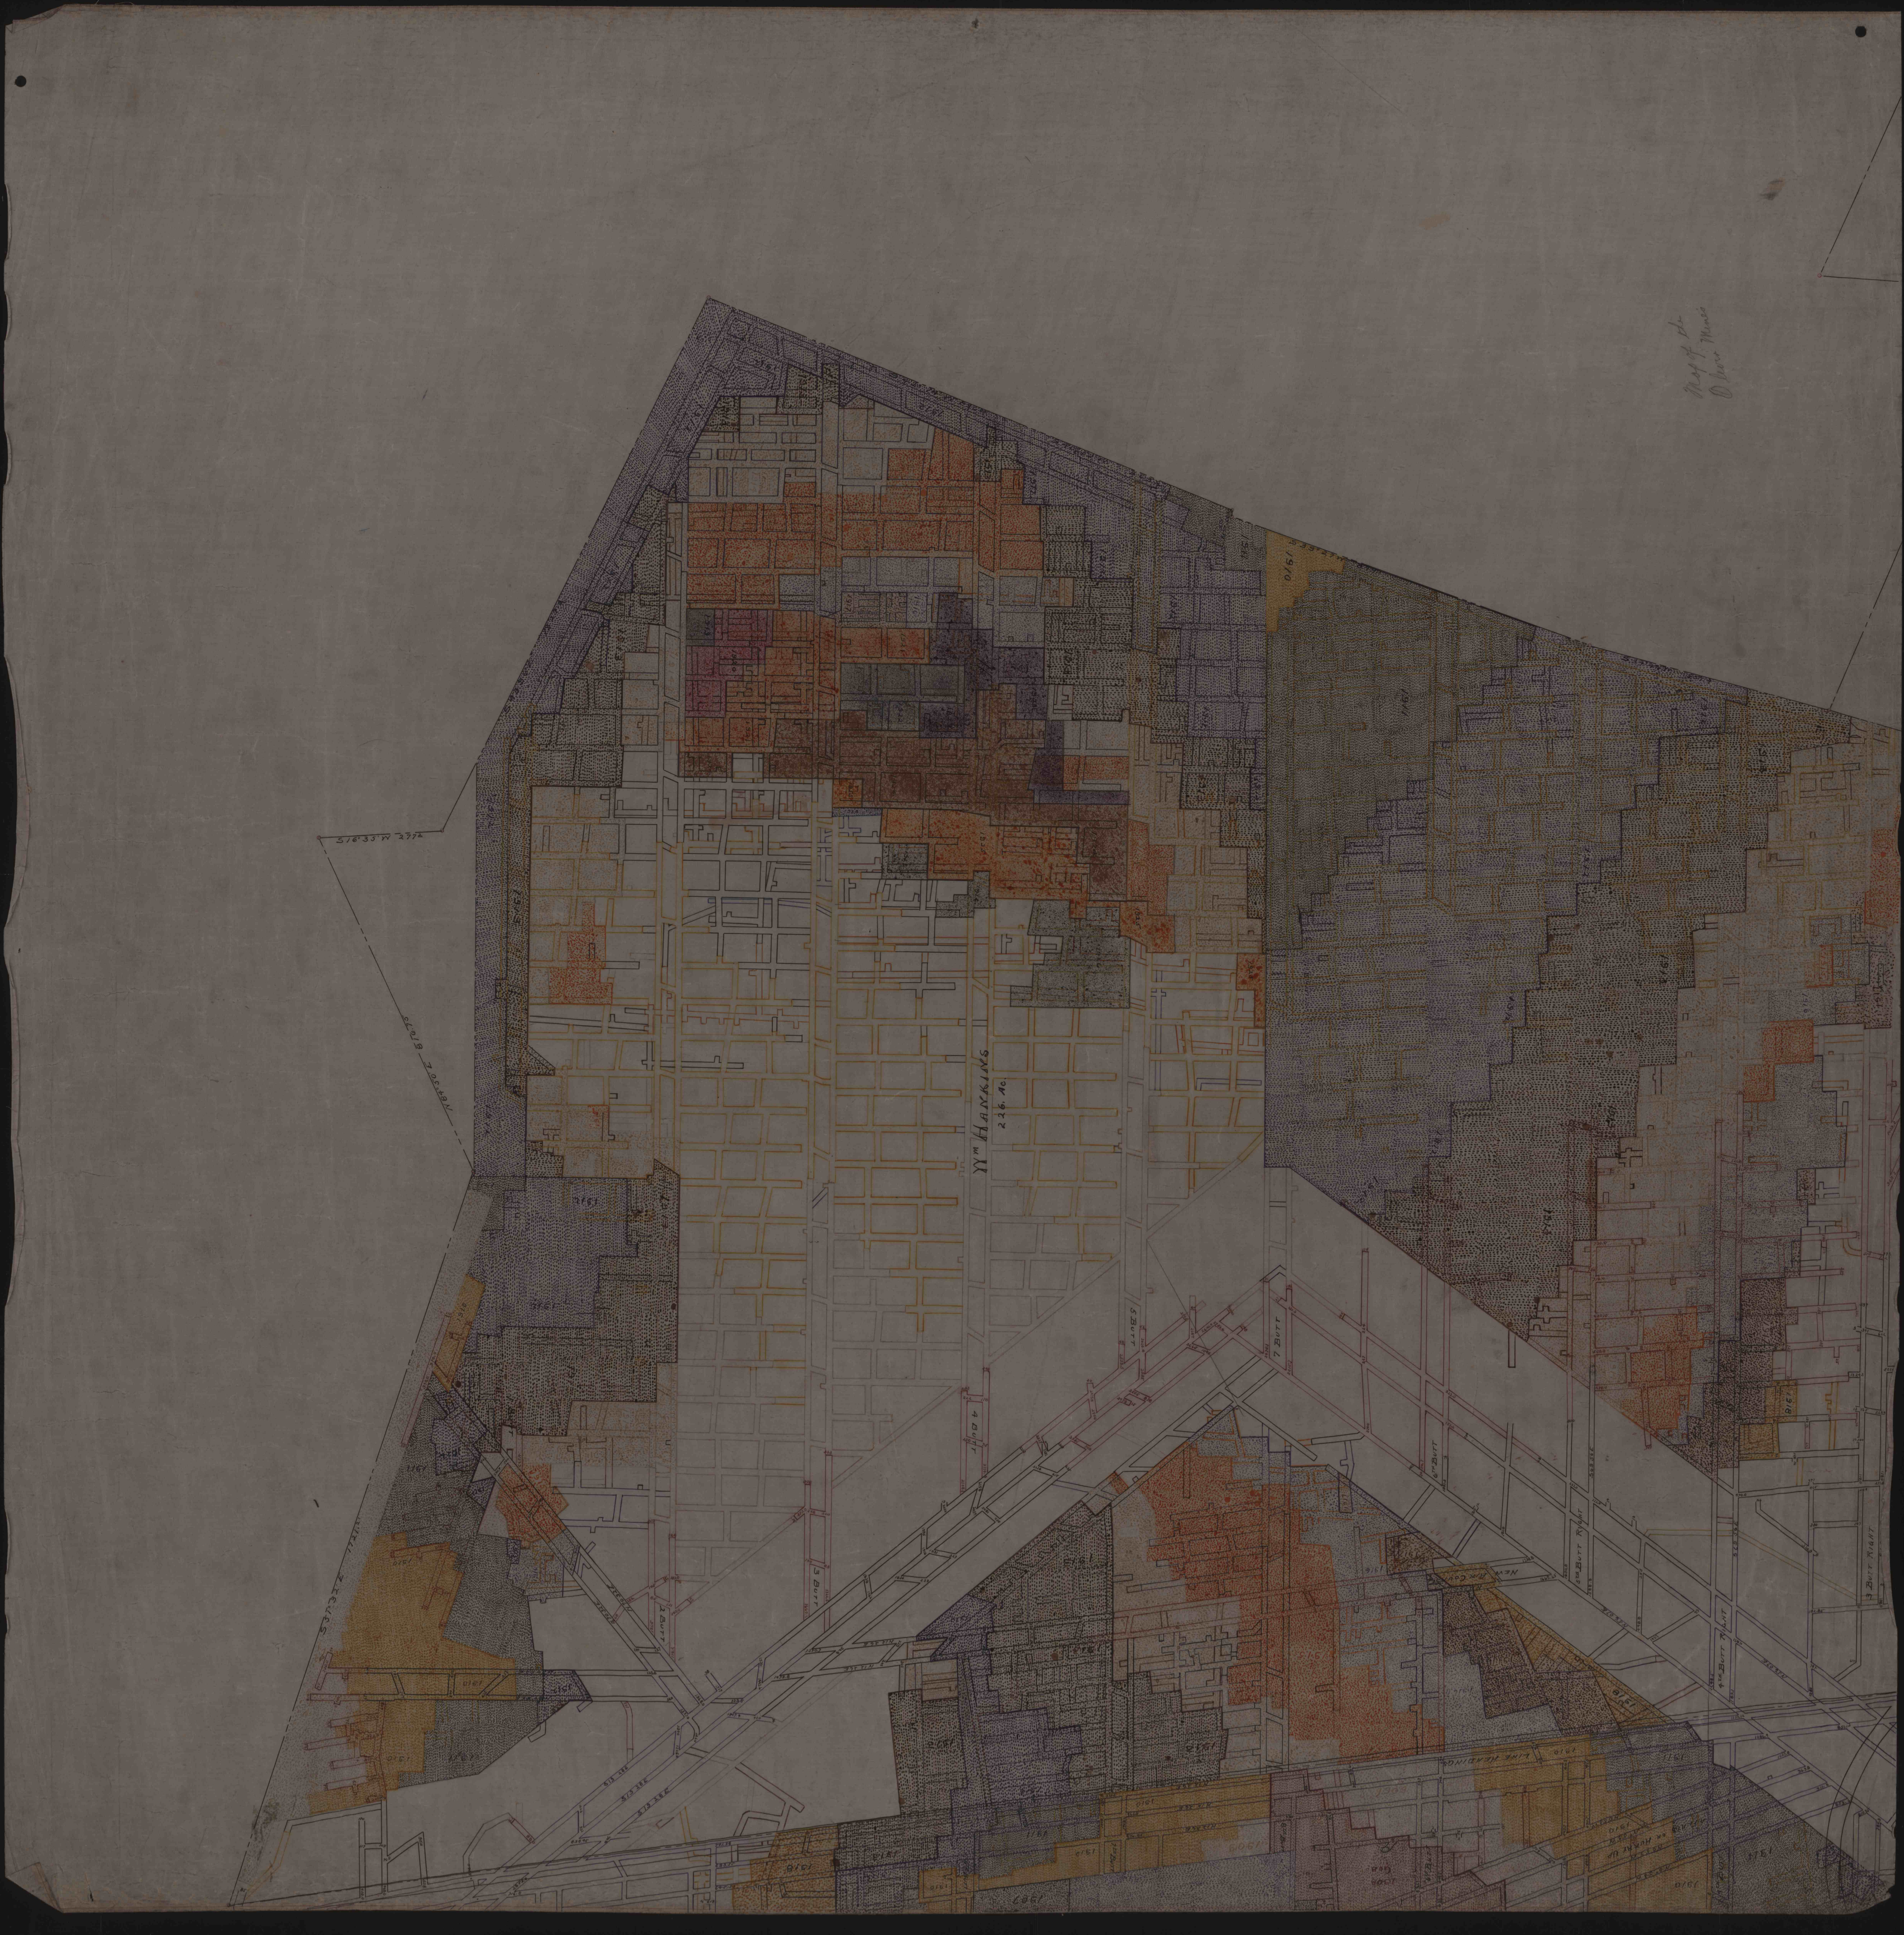
Wm Hankins
226 Ac.
S16°35'W 277½
5 Butt
7 Butt
4 Butt
3 Butt
2 Butt
6th Butt
5th Butt Right
4th Butt Right
3 Butt Right
1910 Line Headings