


Copyright © 1924
The Westmoreland Coal
Company
Pittsburgh, Pa.

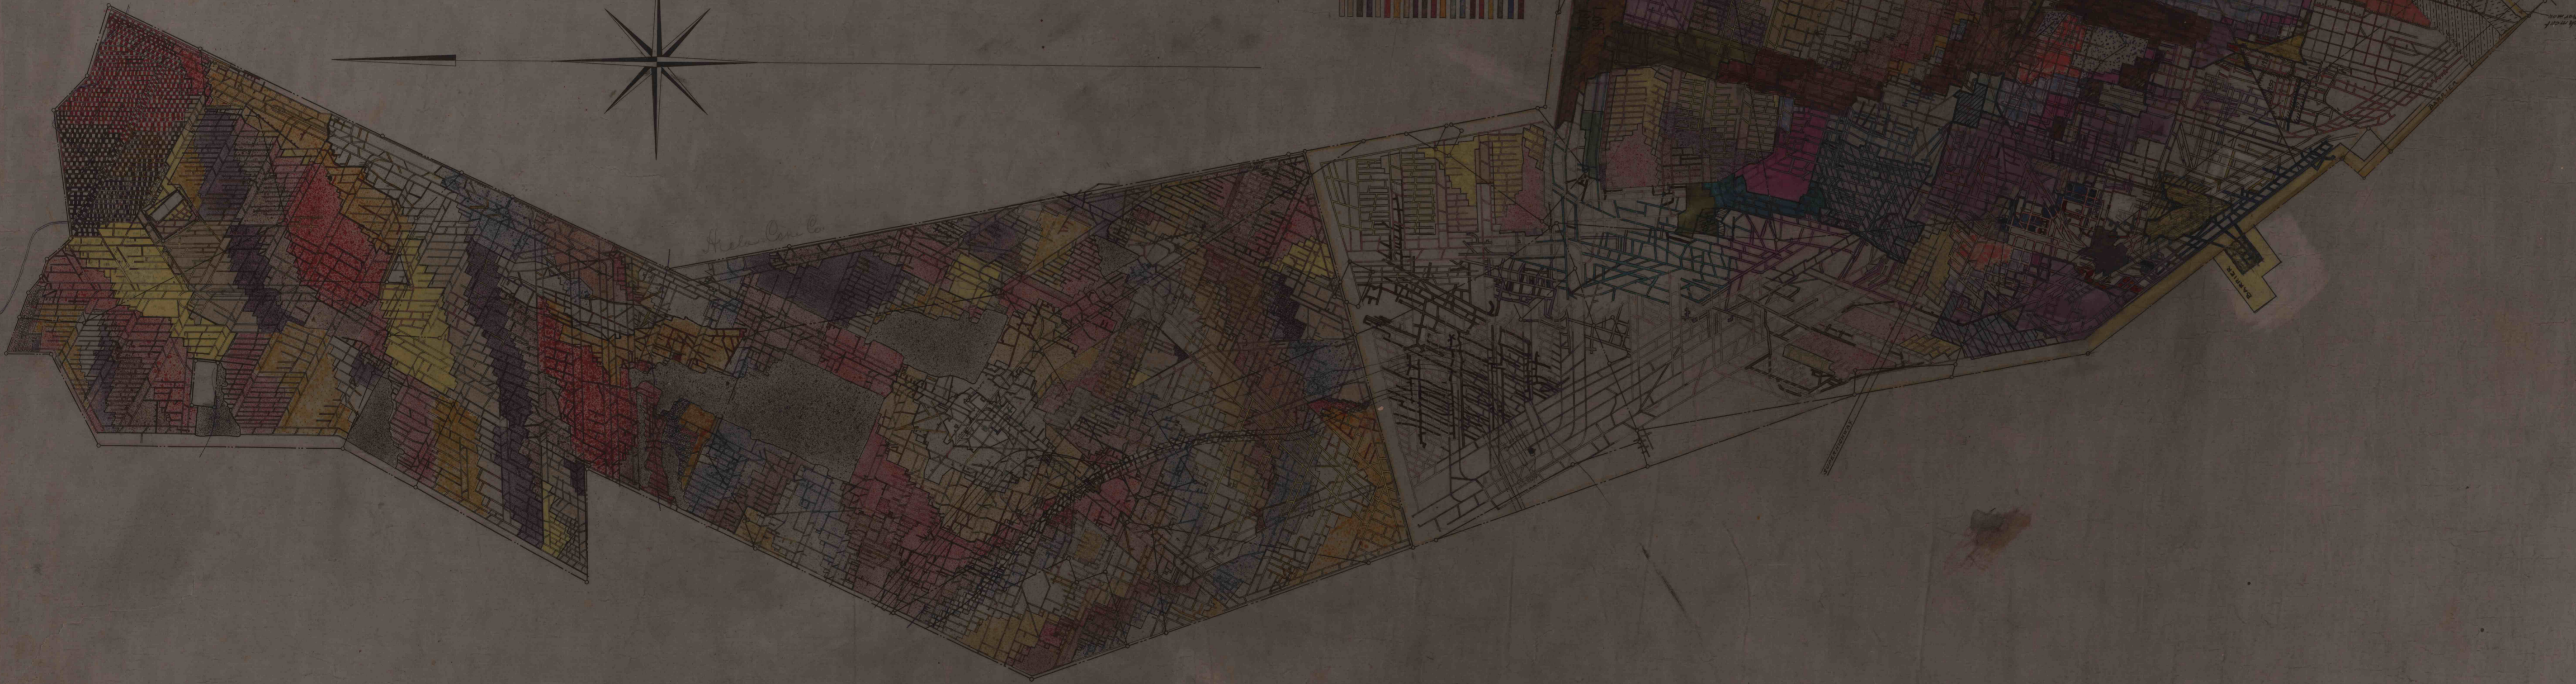

**MAP OF MINES
MOUNT PLEASANT TRACT,
ESTATE OF WILLIAM THAW, DEC'D. "COKE TRUST,"
SITUATE IN MOUNT PLEASANT TOWNSHIP,
WESTMORELAND COUNTY, PA.**

SCALE 1"=400'
JULY 1924

The Westmoreland Coal
Company
Pittsburgh, Pa.

Color	Lease Period
Red	WORKINGS UP TO JAN. 1ST 1887
Orange	WORKINGS UP TO JAN. 1ST 1888
Yellow	WORKINGS UP TO JAN. 1ST 1889
Light Green	WORKINGS UP TO JAN. 1ST 1890
Green	WORKINGS UP TO JAN. 1ST 1891
Light Blue	WORKINGS UP TO JAN. 1ST 1892
Blue	WORKINGS UP TO JAN. 1ST 1893
Dark Blue	WORKINGS UP TO JAN. 1ST 1894
Purple	WORKINGS UP TO JAN. 1ST 1895
Light Purple	WORKINGS UP TO JAN. 1ST 1896

